


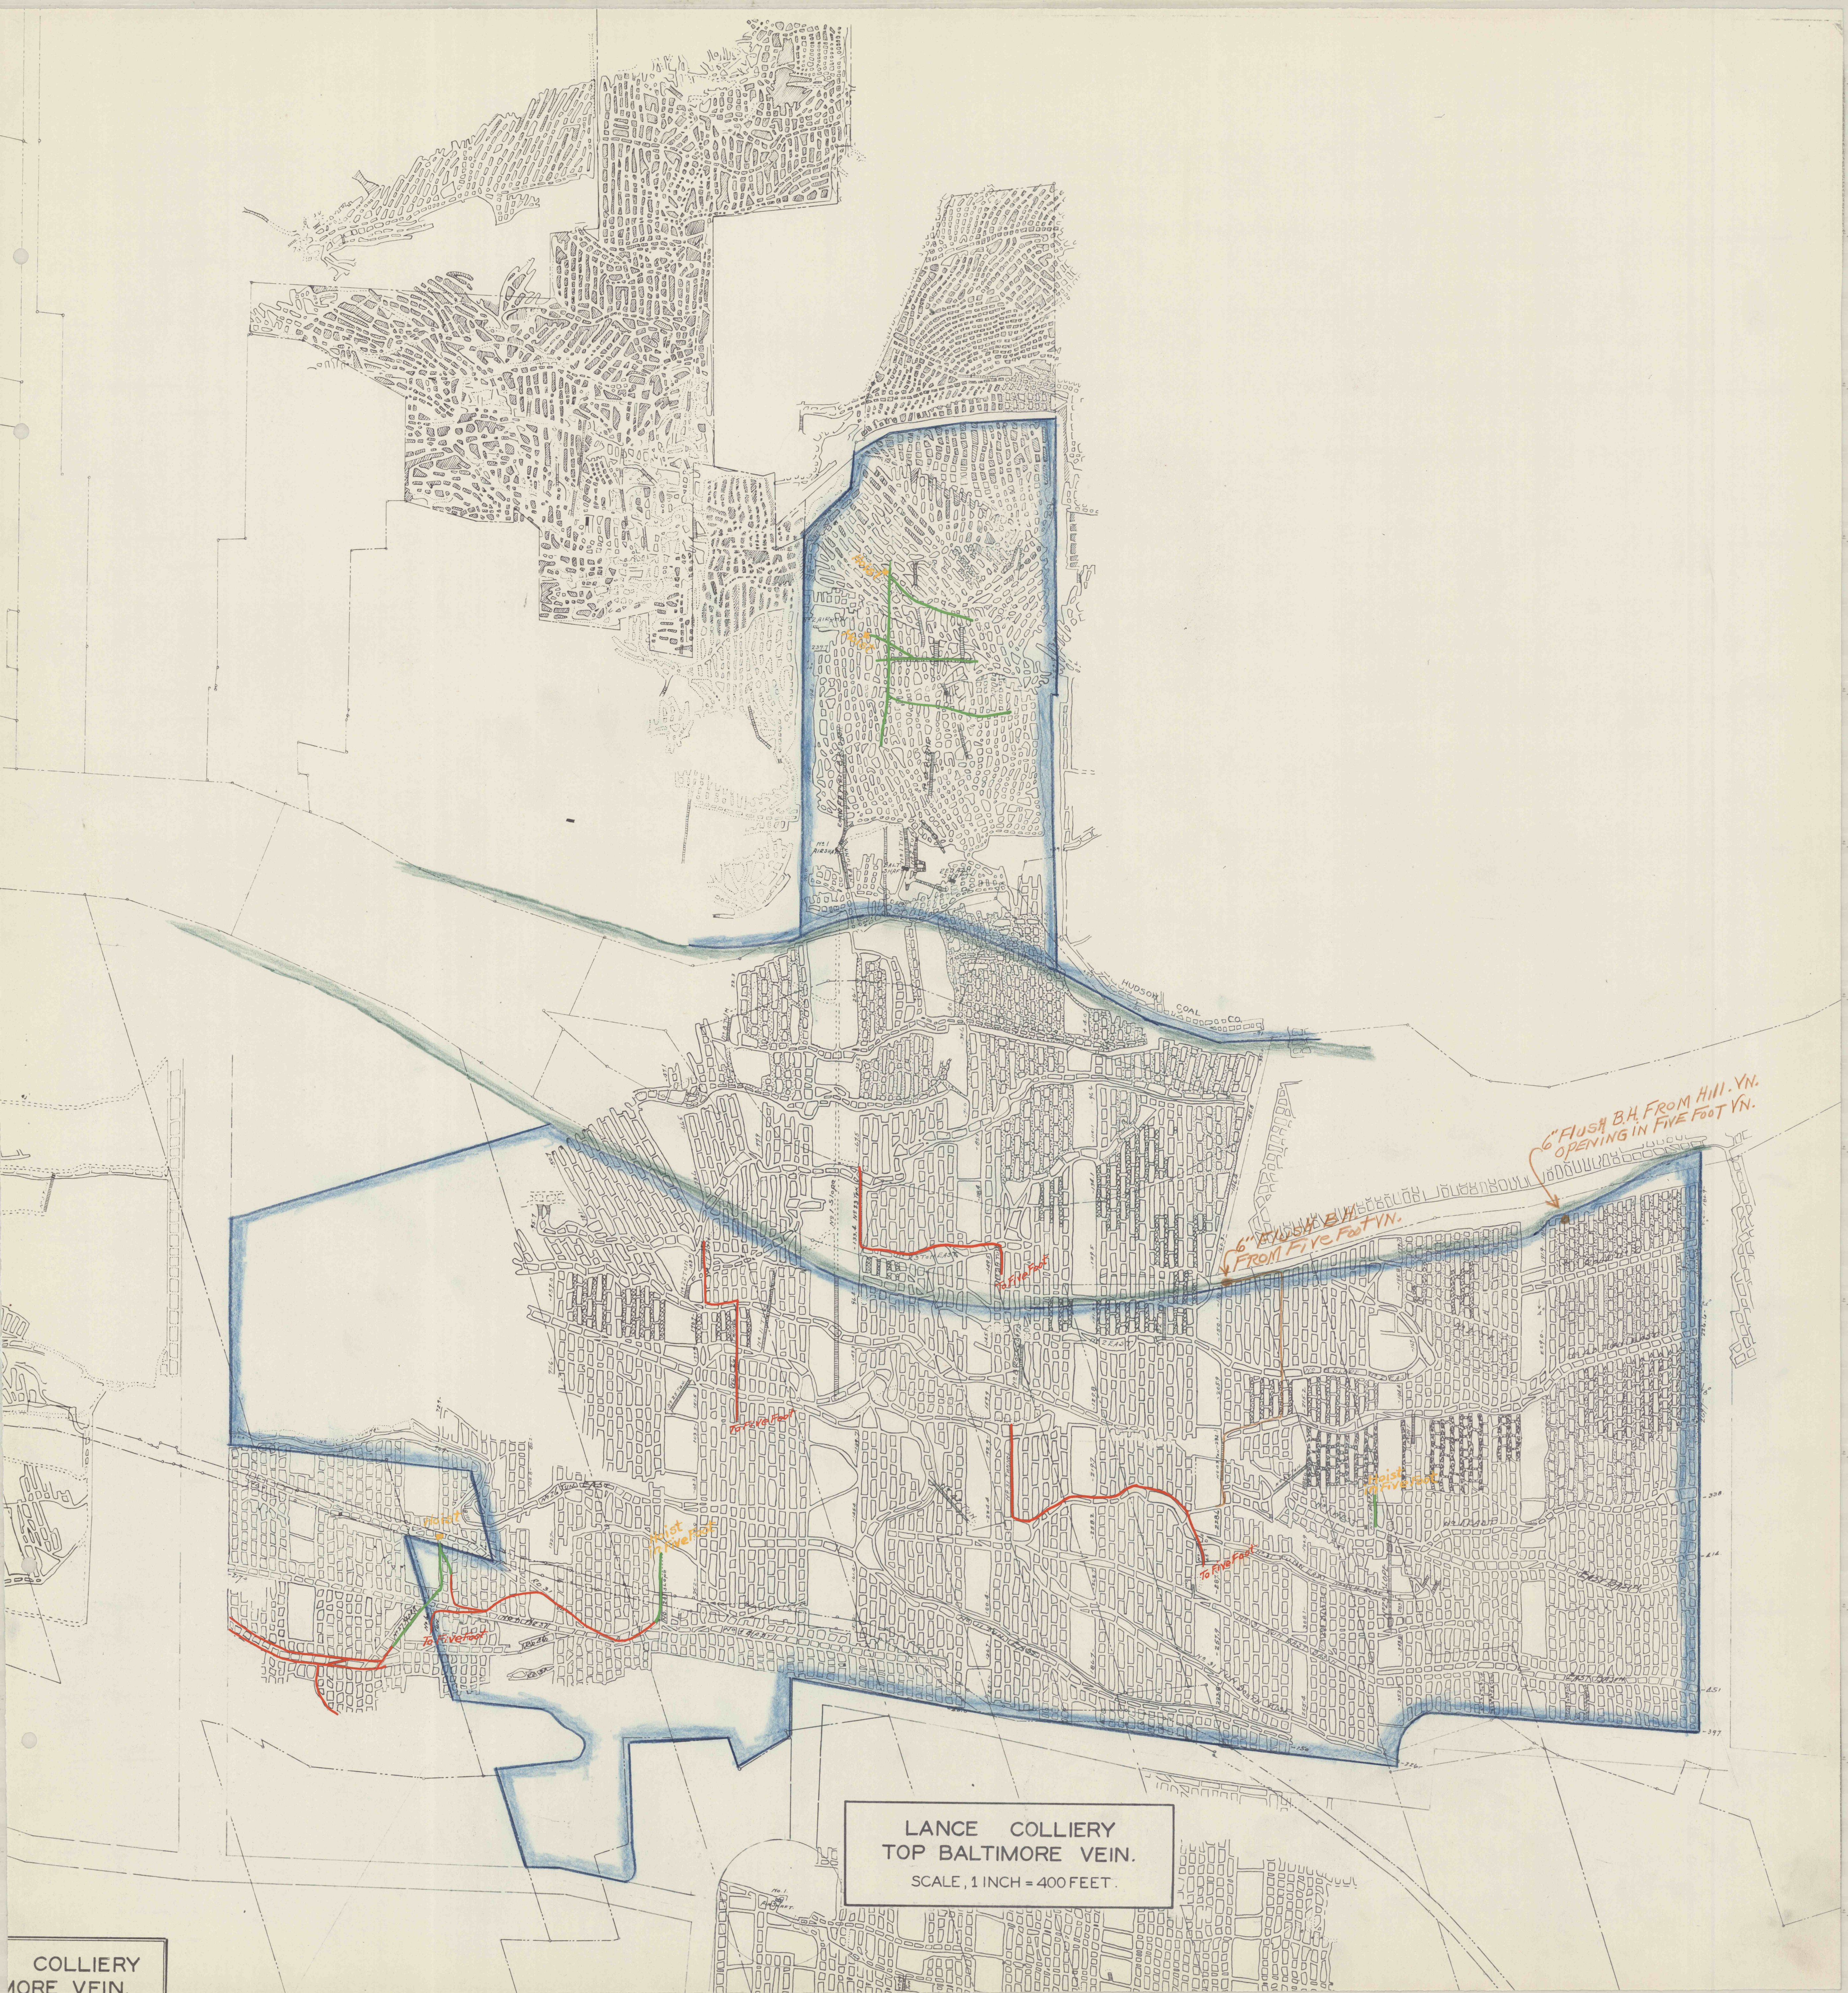

LANCE COLLIERY
TOP BALTIMORE VEIN.
SCALE, 1 INCH = 400 FEET.

COLLIERY
MORE VEIN.

6" FLUSH B.H. FROM HILL. VN.
OPENING IN FIVE FOOT VN.

6" FLUSH B.H. FROM FIVE FOOT VN.

to River

to River

to River