


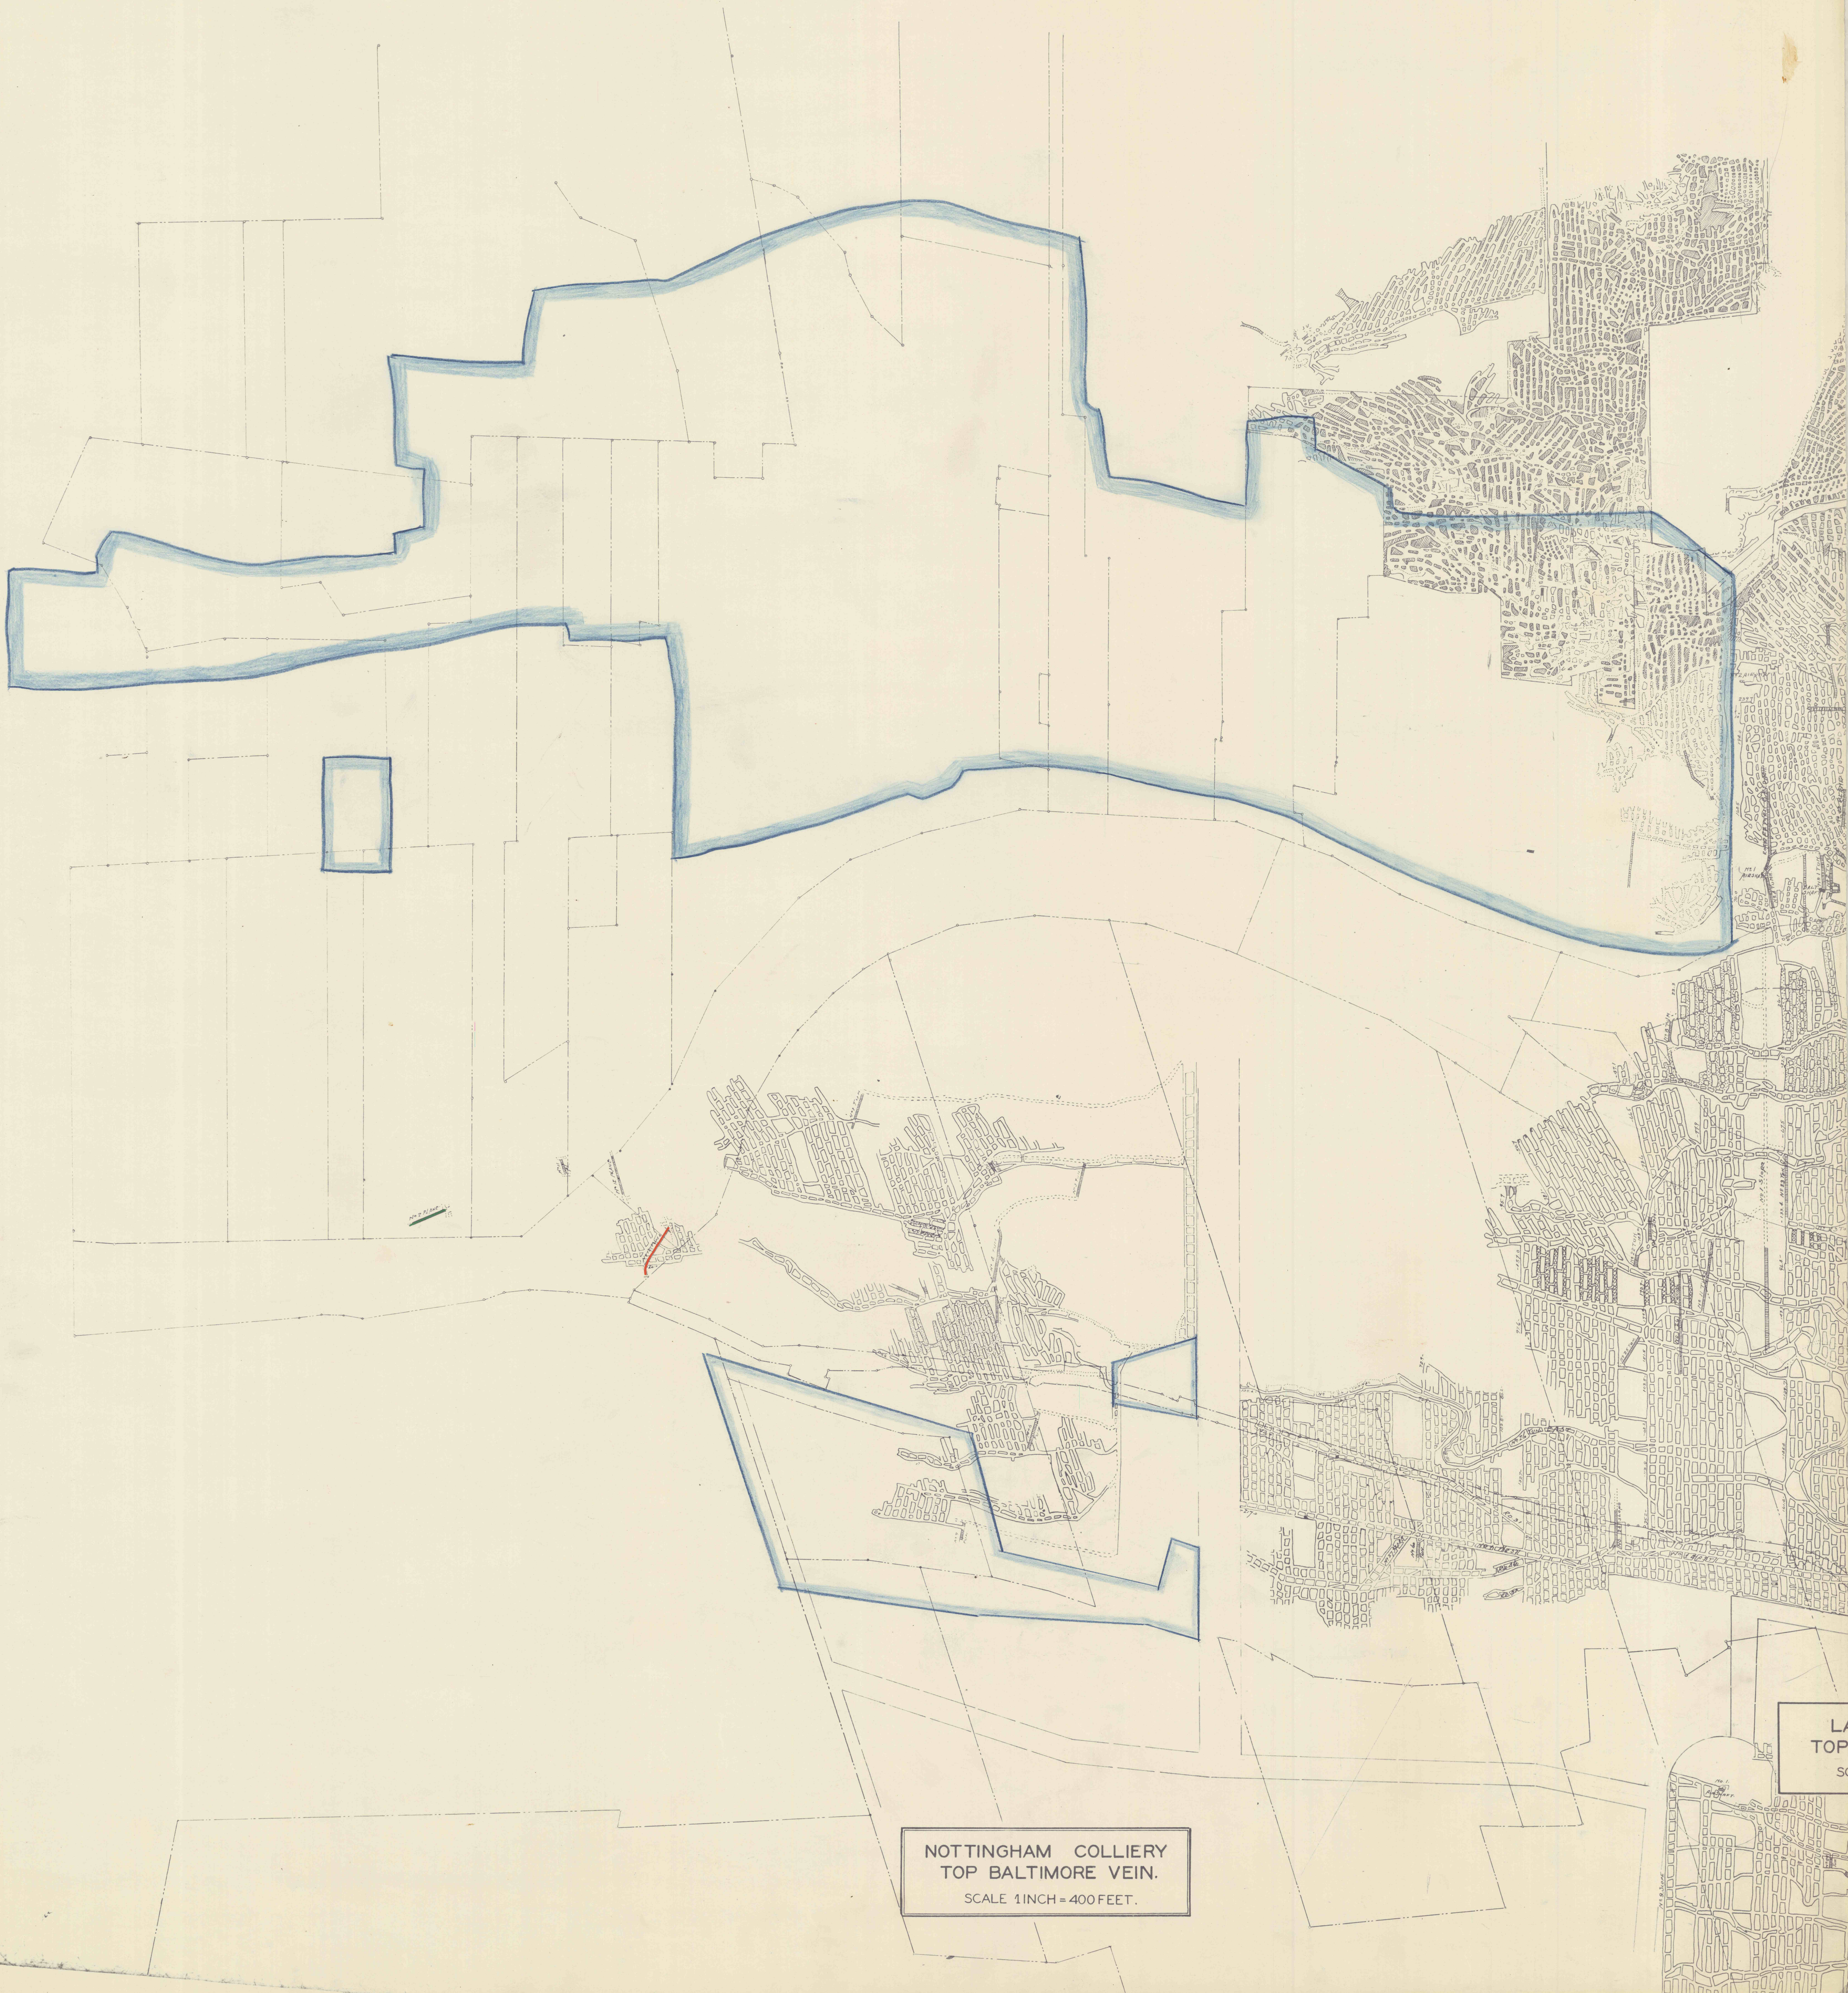

NOTTINGHAM COLLIERY
TOP BALTIMORE VEIN.
SCALE 1 INCH = 400 FEET.

LA
TOP
SC