


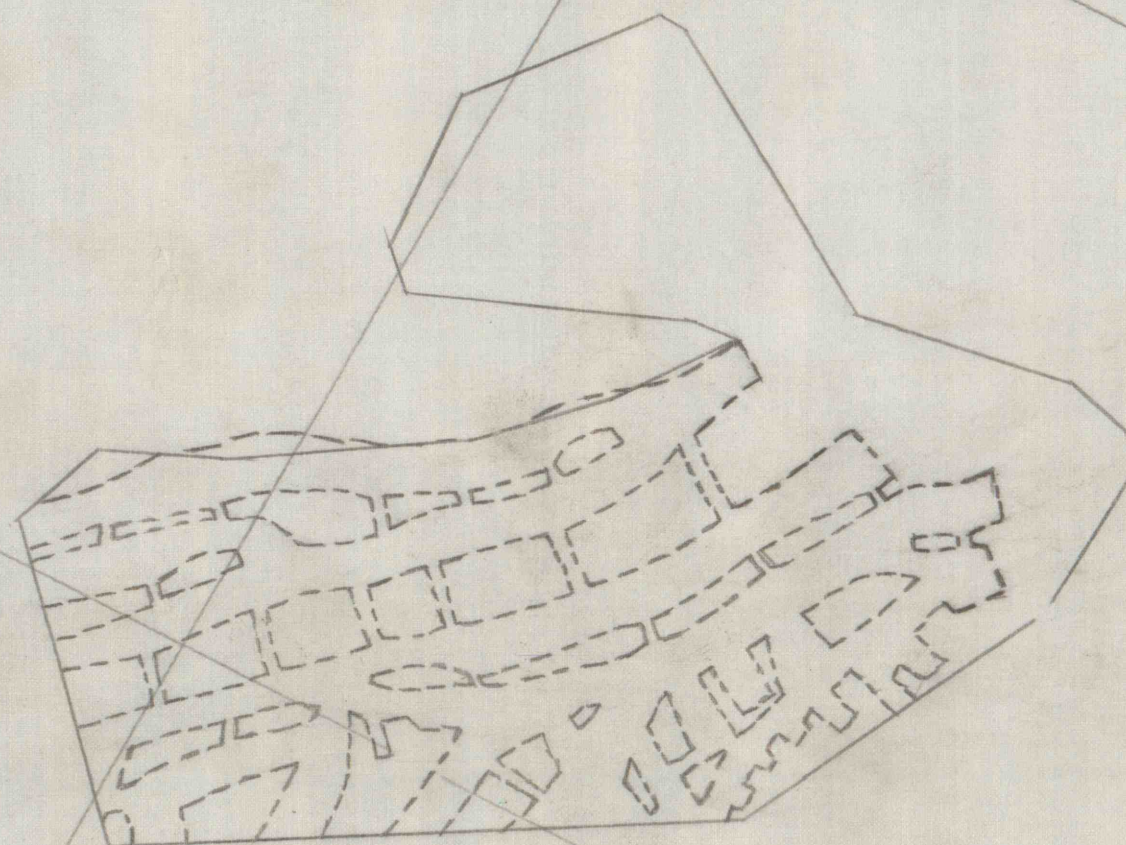

*Parrish Colliery Top Balt. - Before worked by Shawnee Coal Co.*