


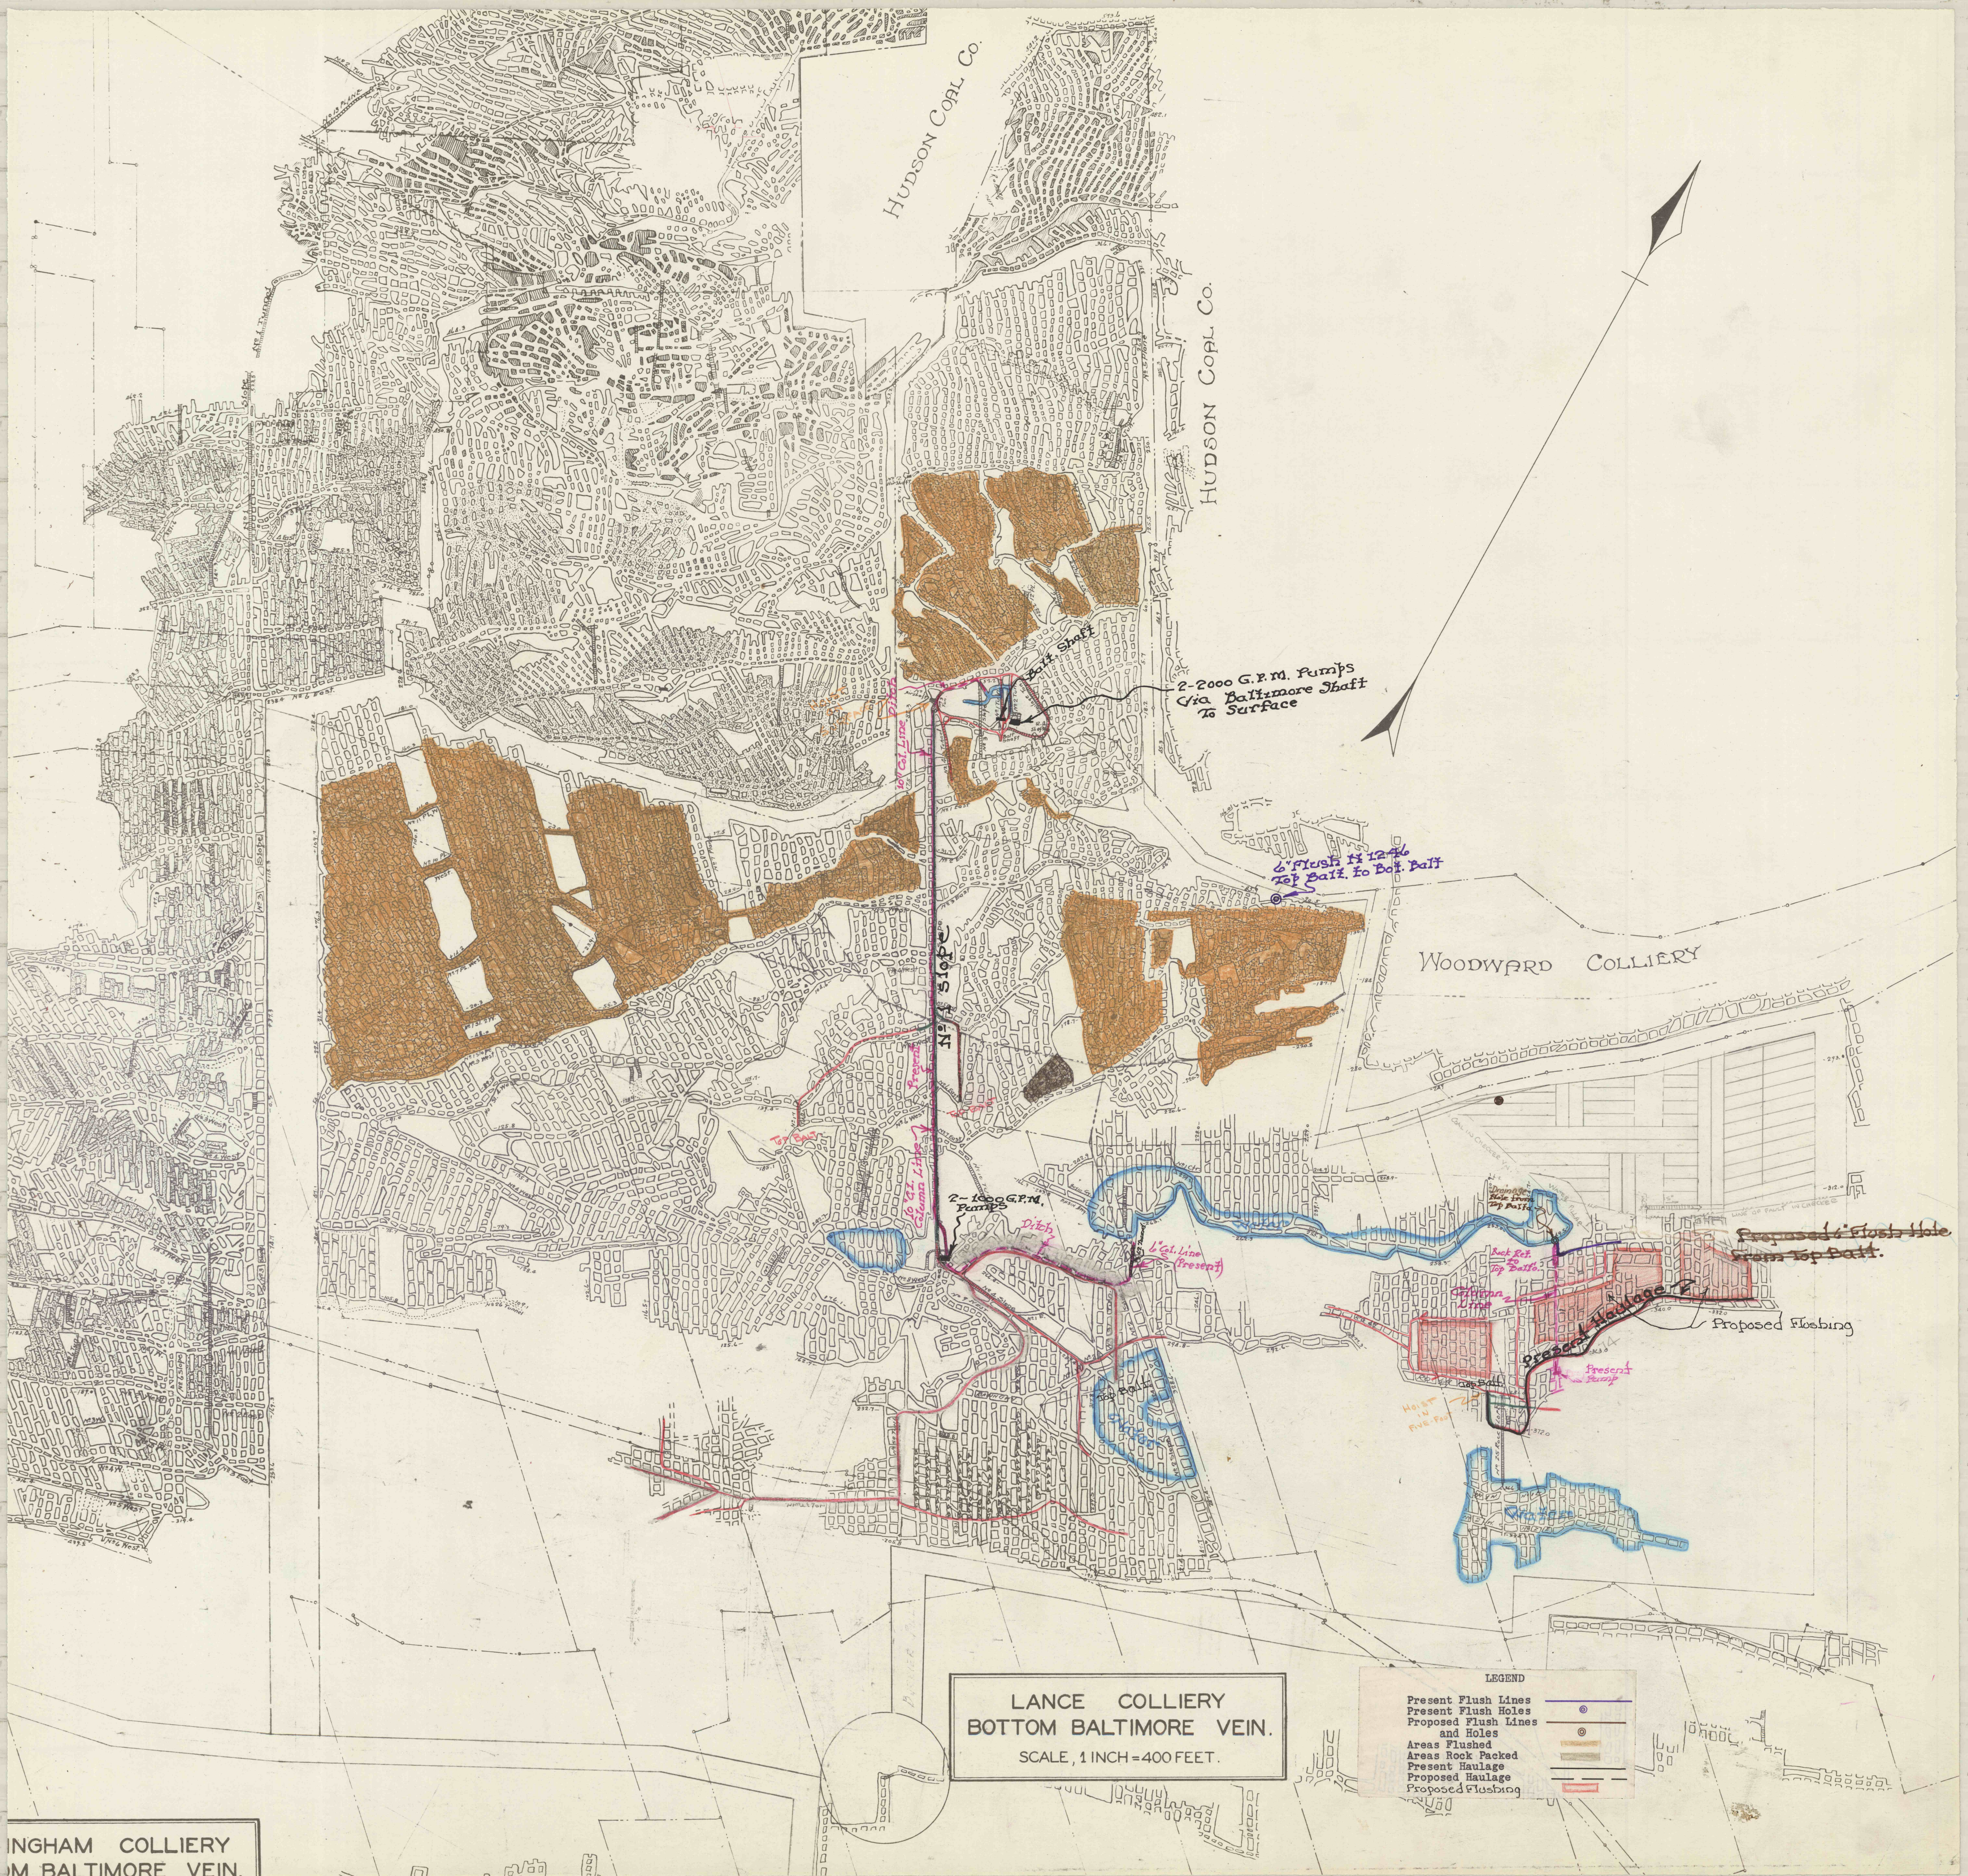

LANCE COLLIERY
BOTTOM BALTIMORE VEIN.
SCALE, 1 INCH = 400 FEET.

LEGEND	
Present Flush Lines	—
Present Flush Holes	⊙
Proposed Flush Lines and Holes	—○—
Areas Flushed	⊙
Areas Rock Packed	■
Present Haulage	—
Proposed Haulage	—
Proposed Flushing	—

INGHAM COLLIERY
M BALTIMORE VEIN.