


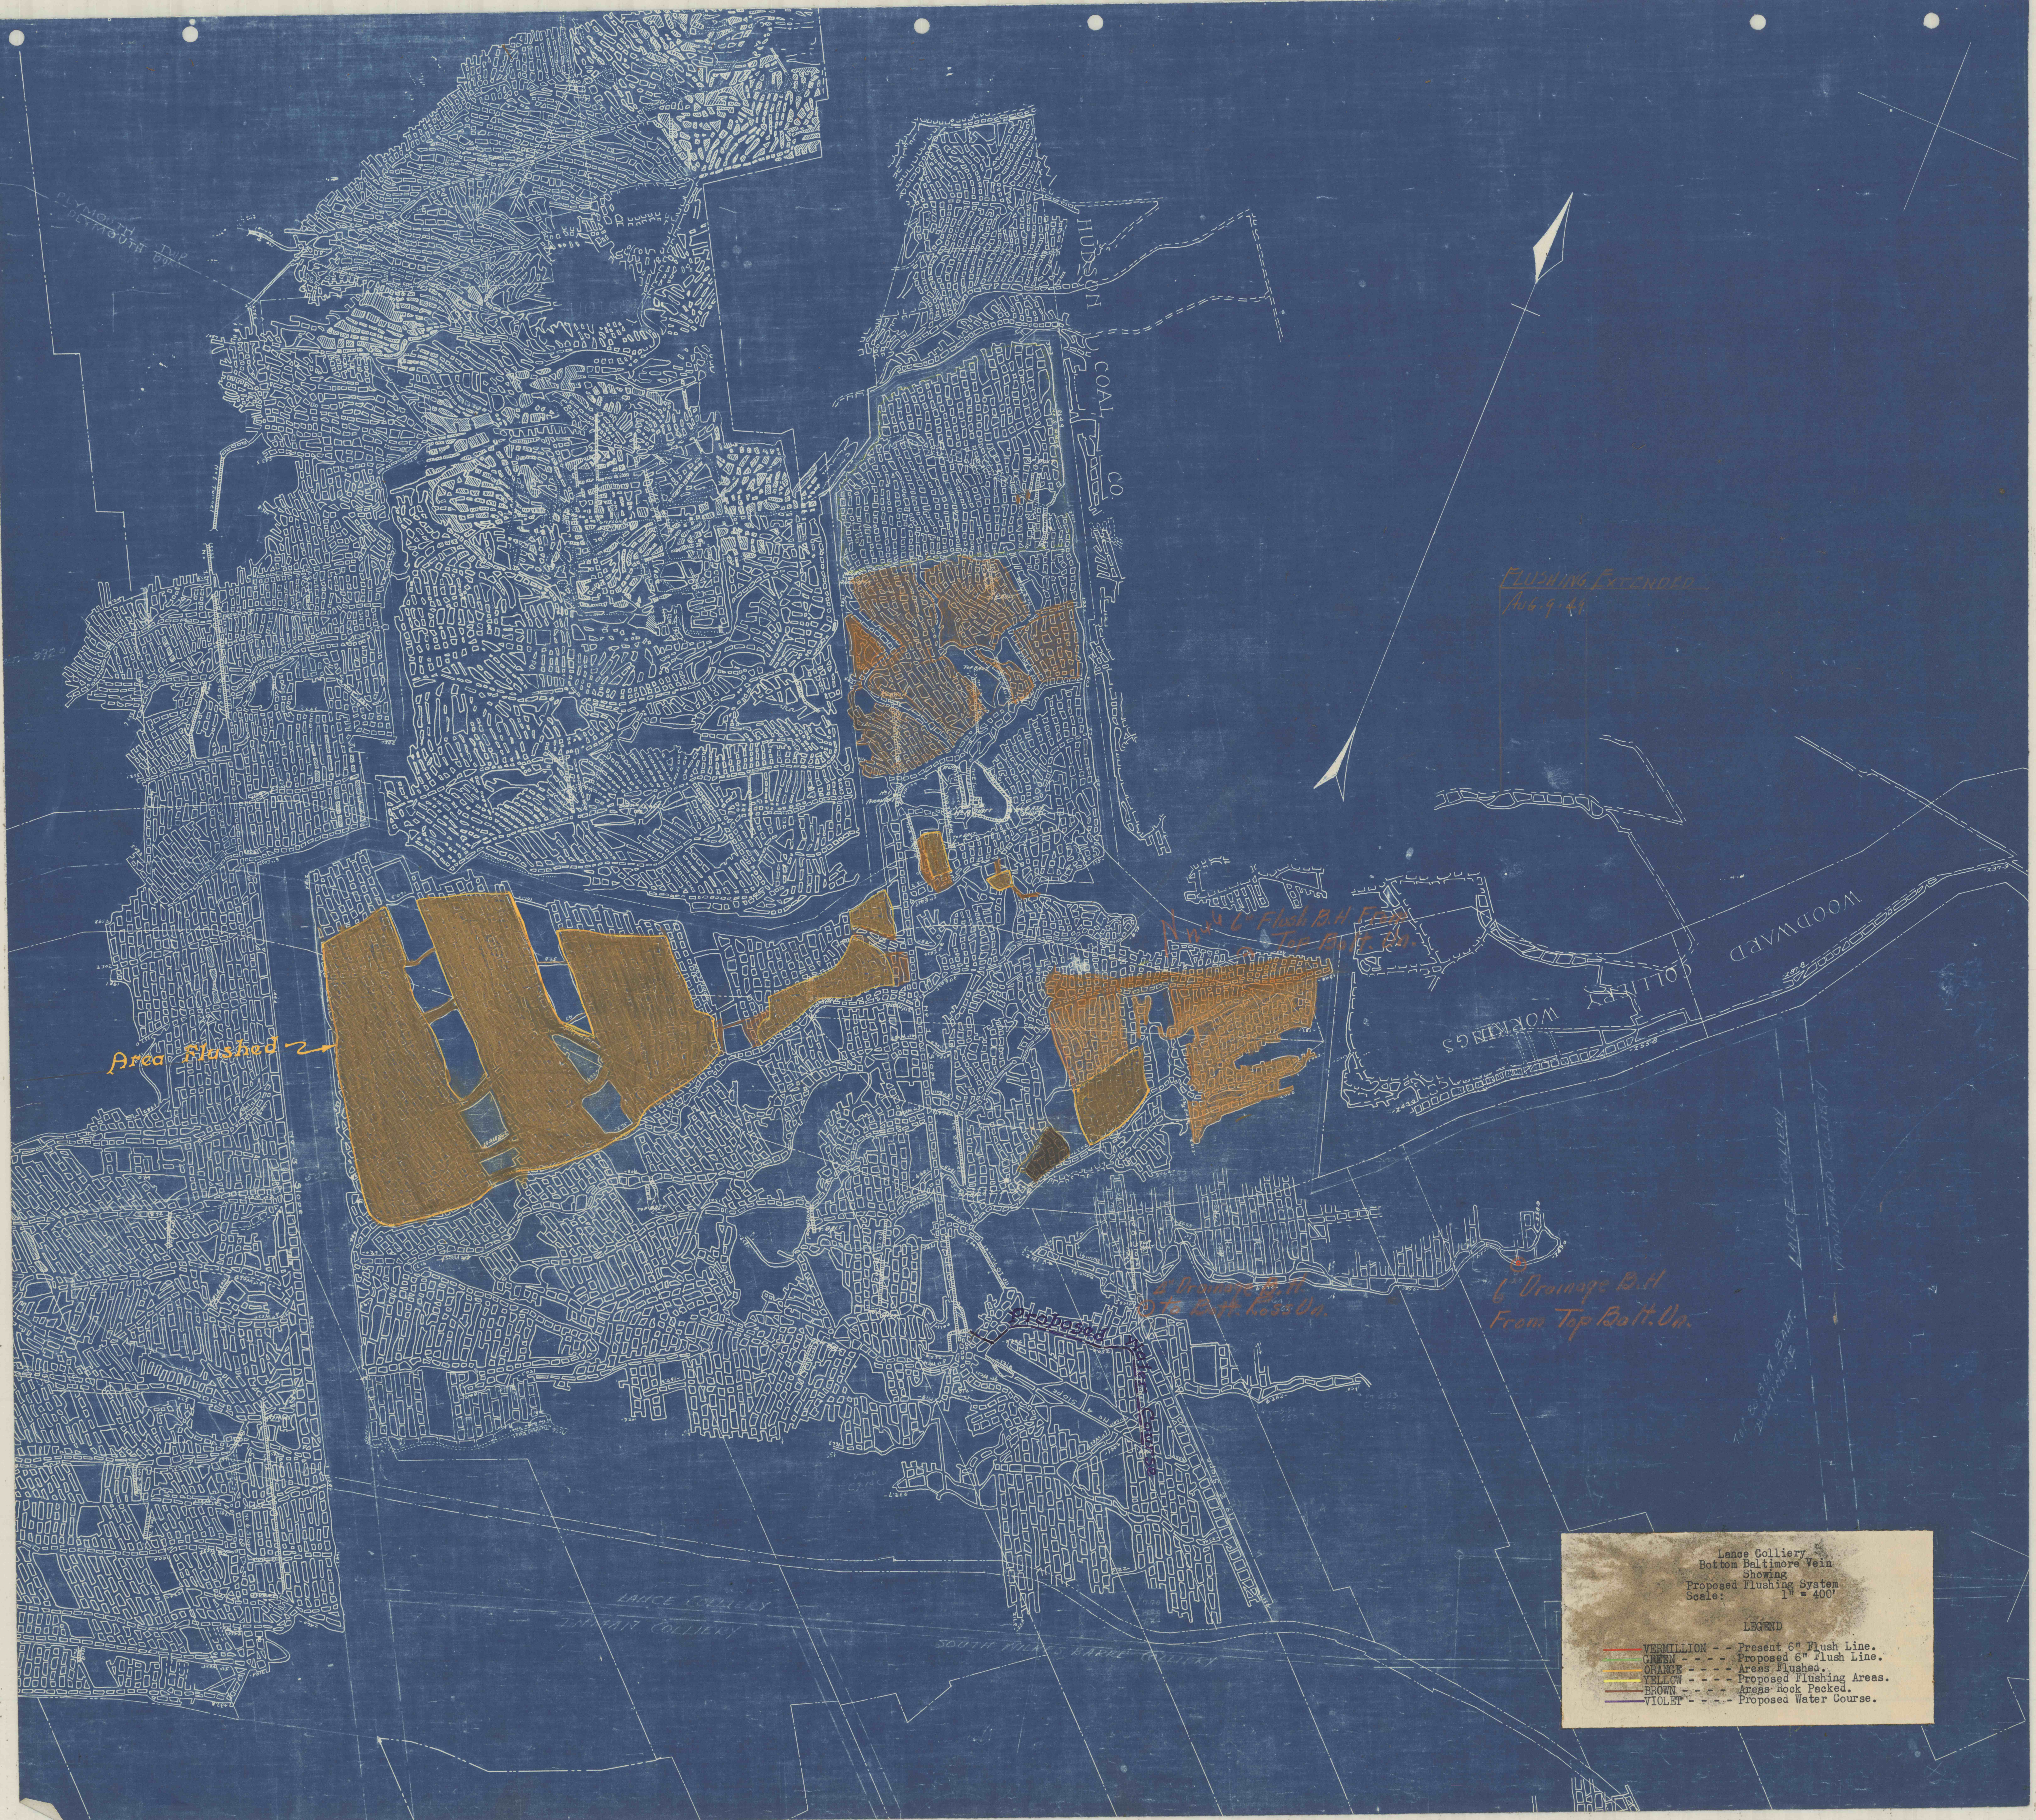

Lance Colliery
Bottom Baltimore Vein
Showing
Proposed Flushing System
Scale: 1" = 400'

LEGEND

VERMILION	- - -	Present 6" Flush Line.
GREEN	- - -	Proposed 6" Flush Line.
ORANGE	- - -	Areas Flashed.
YELLOW	- - -	Proposed Flushing Areas.
BROWN	- - -	Areas Rock Packed.
VIOLET	- - -	Proposed Water Course.