


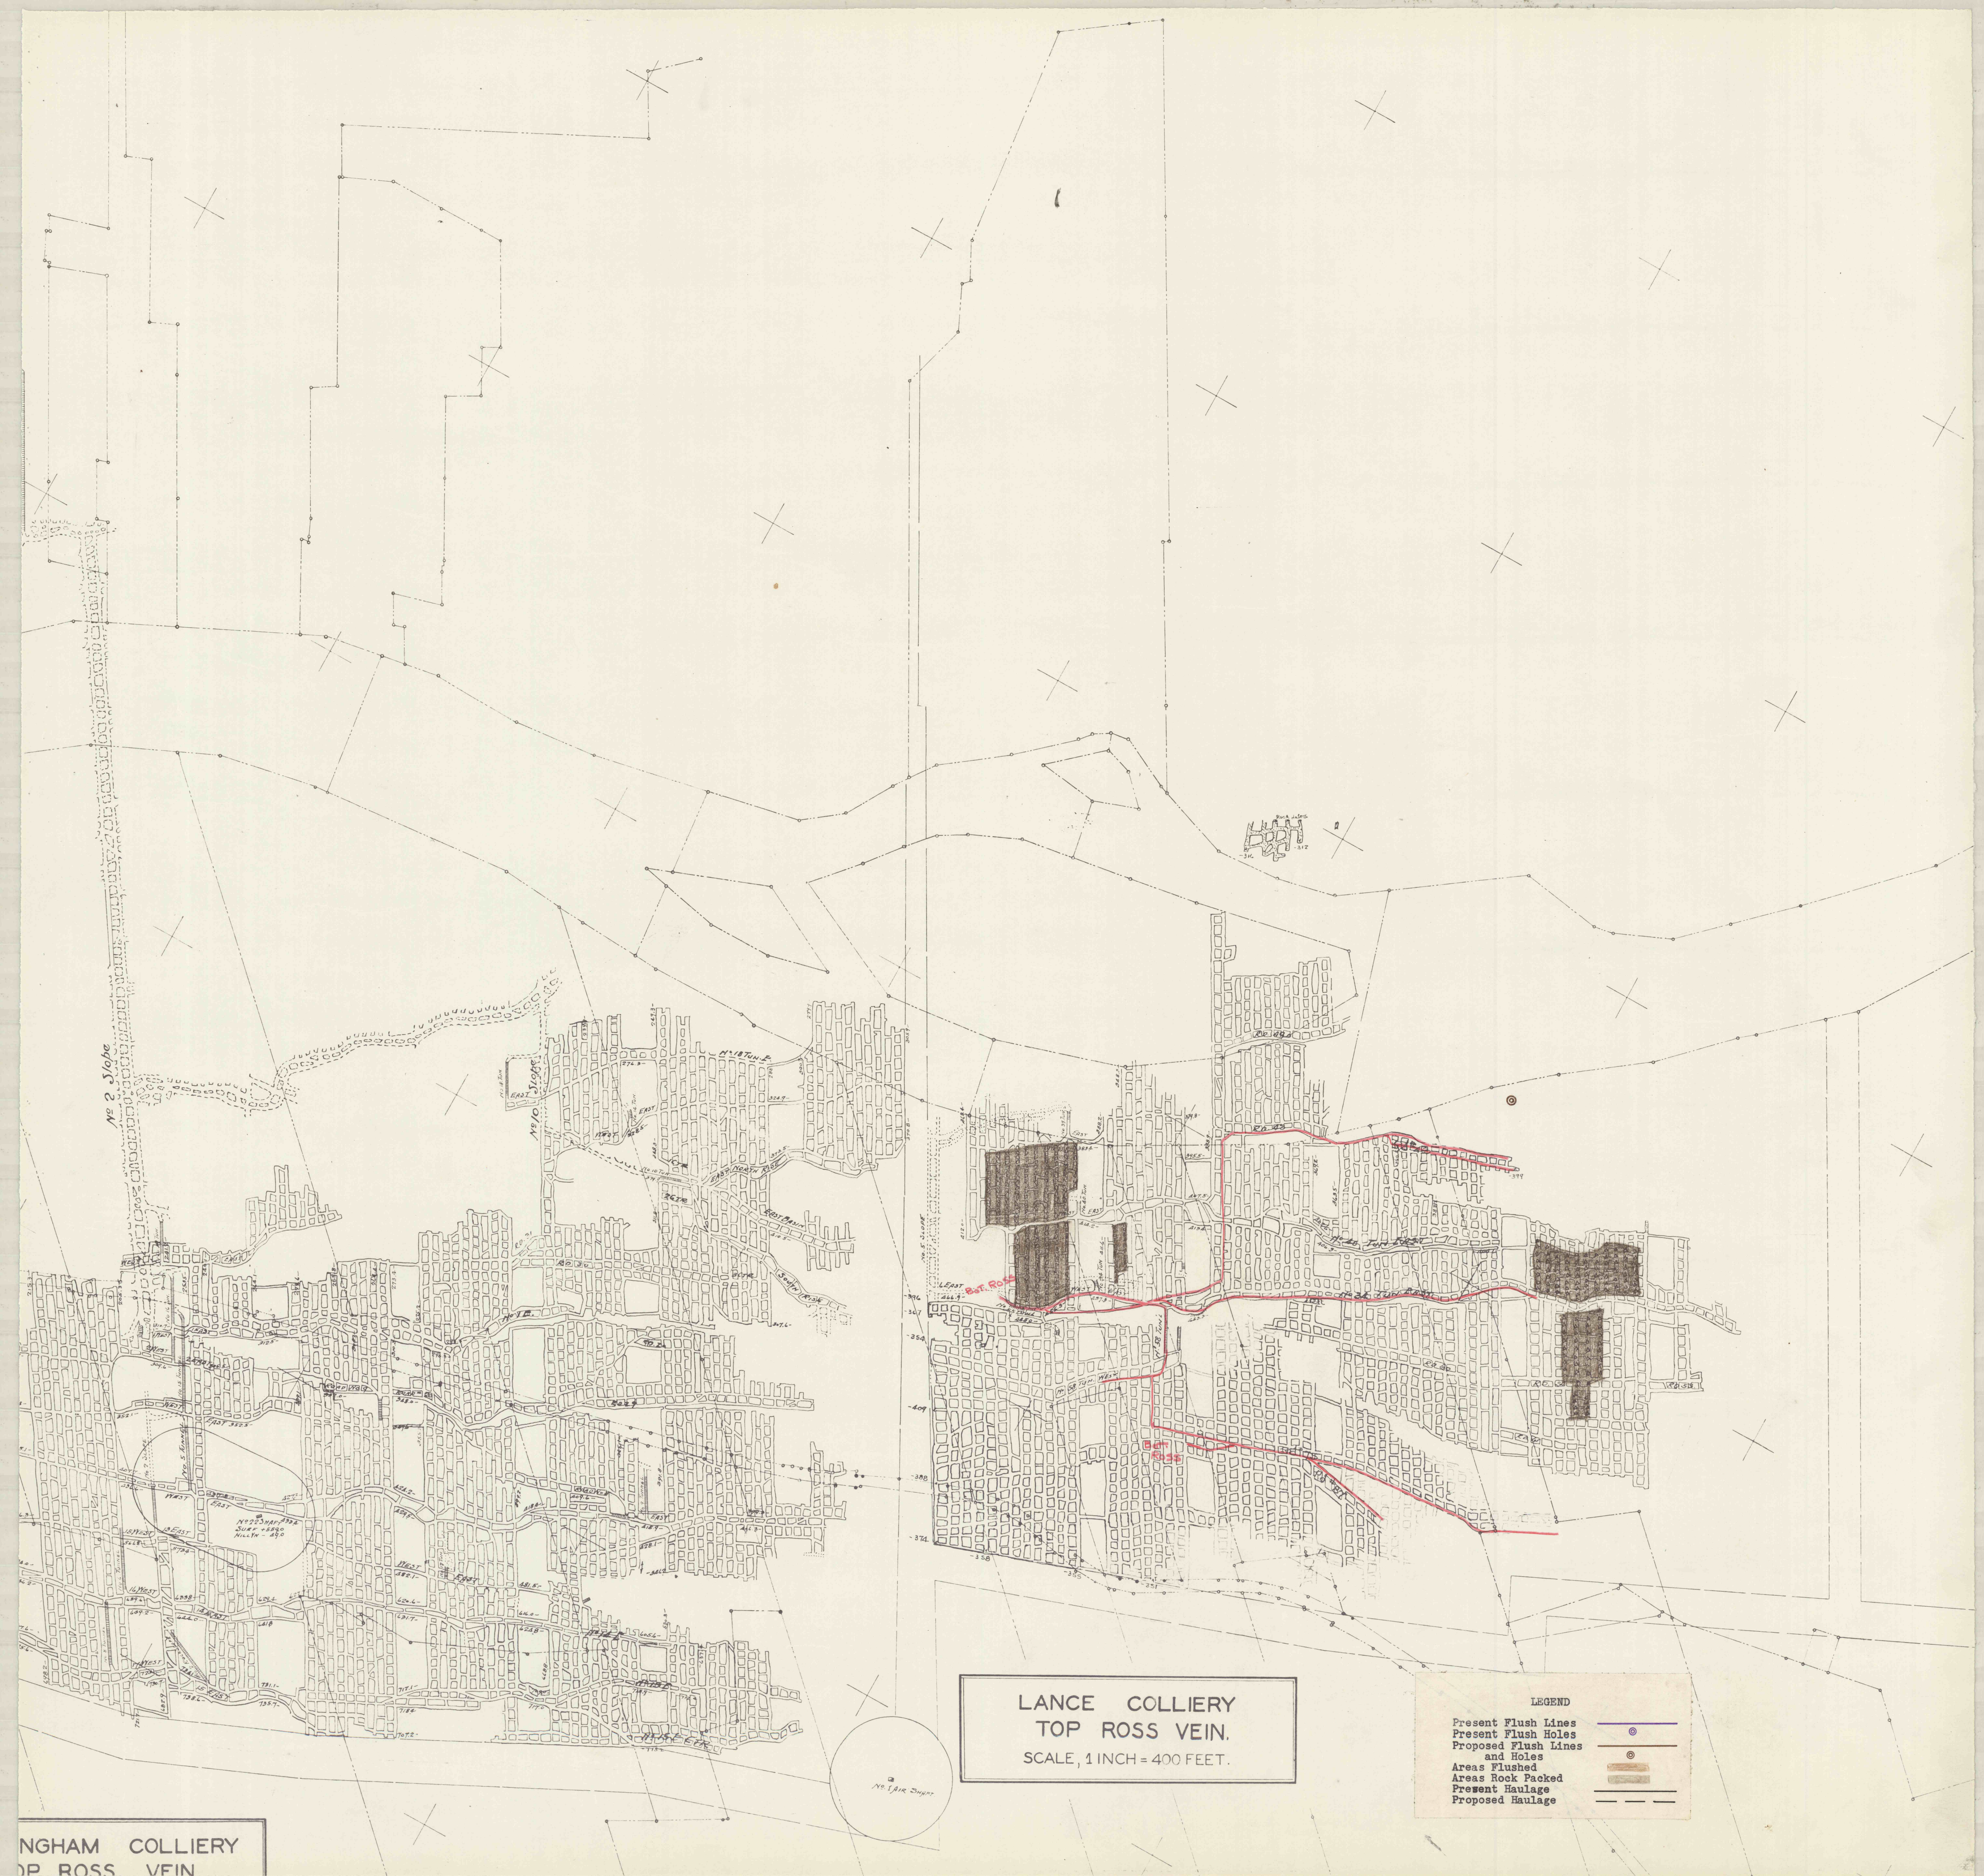

No 2 Slope

LANCE COLLIERY
TOP ROSS VEIN.
SCALE, 1 INCH = 400 FEET.

LEGEND
Present Flush Lines
Present Flush Holes
Proposed Flush Lines
and Holes
Areas Flushed
Areas Rock Packed
Present Haulage
Proposed Haulage

NGHAM COLLIERY
TOP ROSS VEIN