


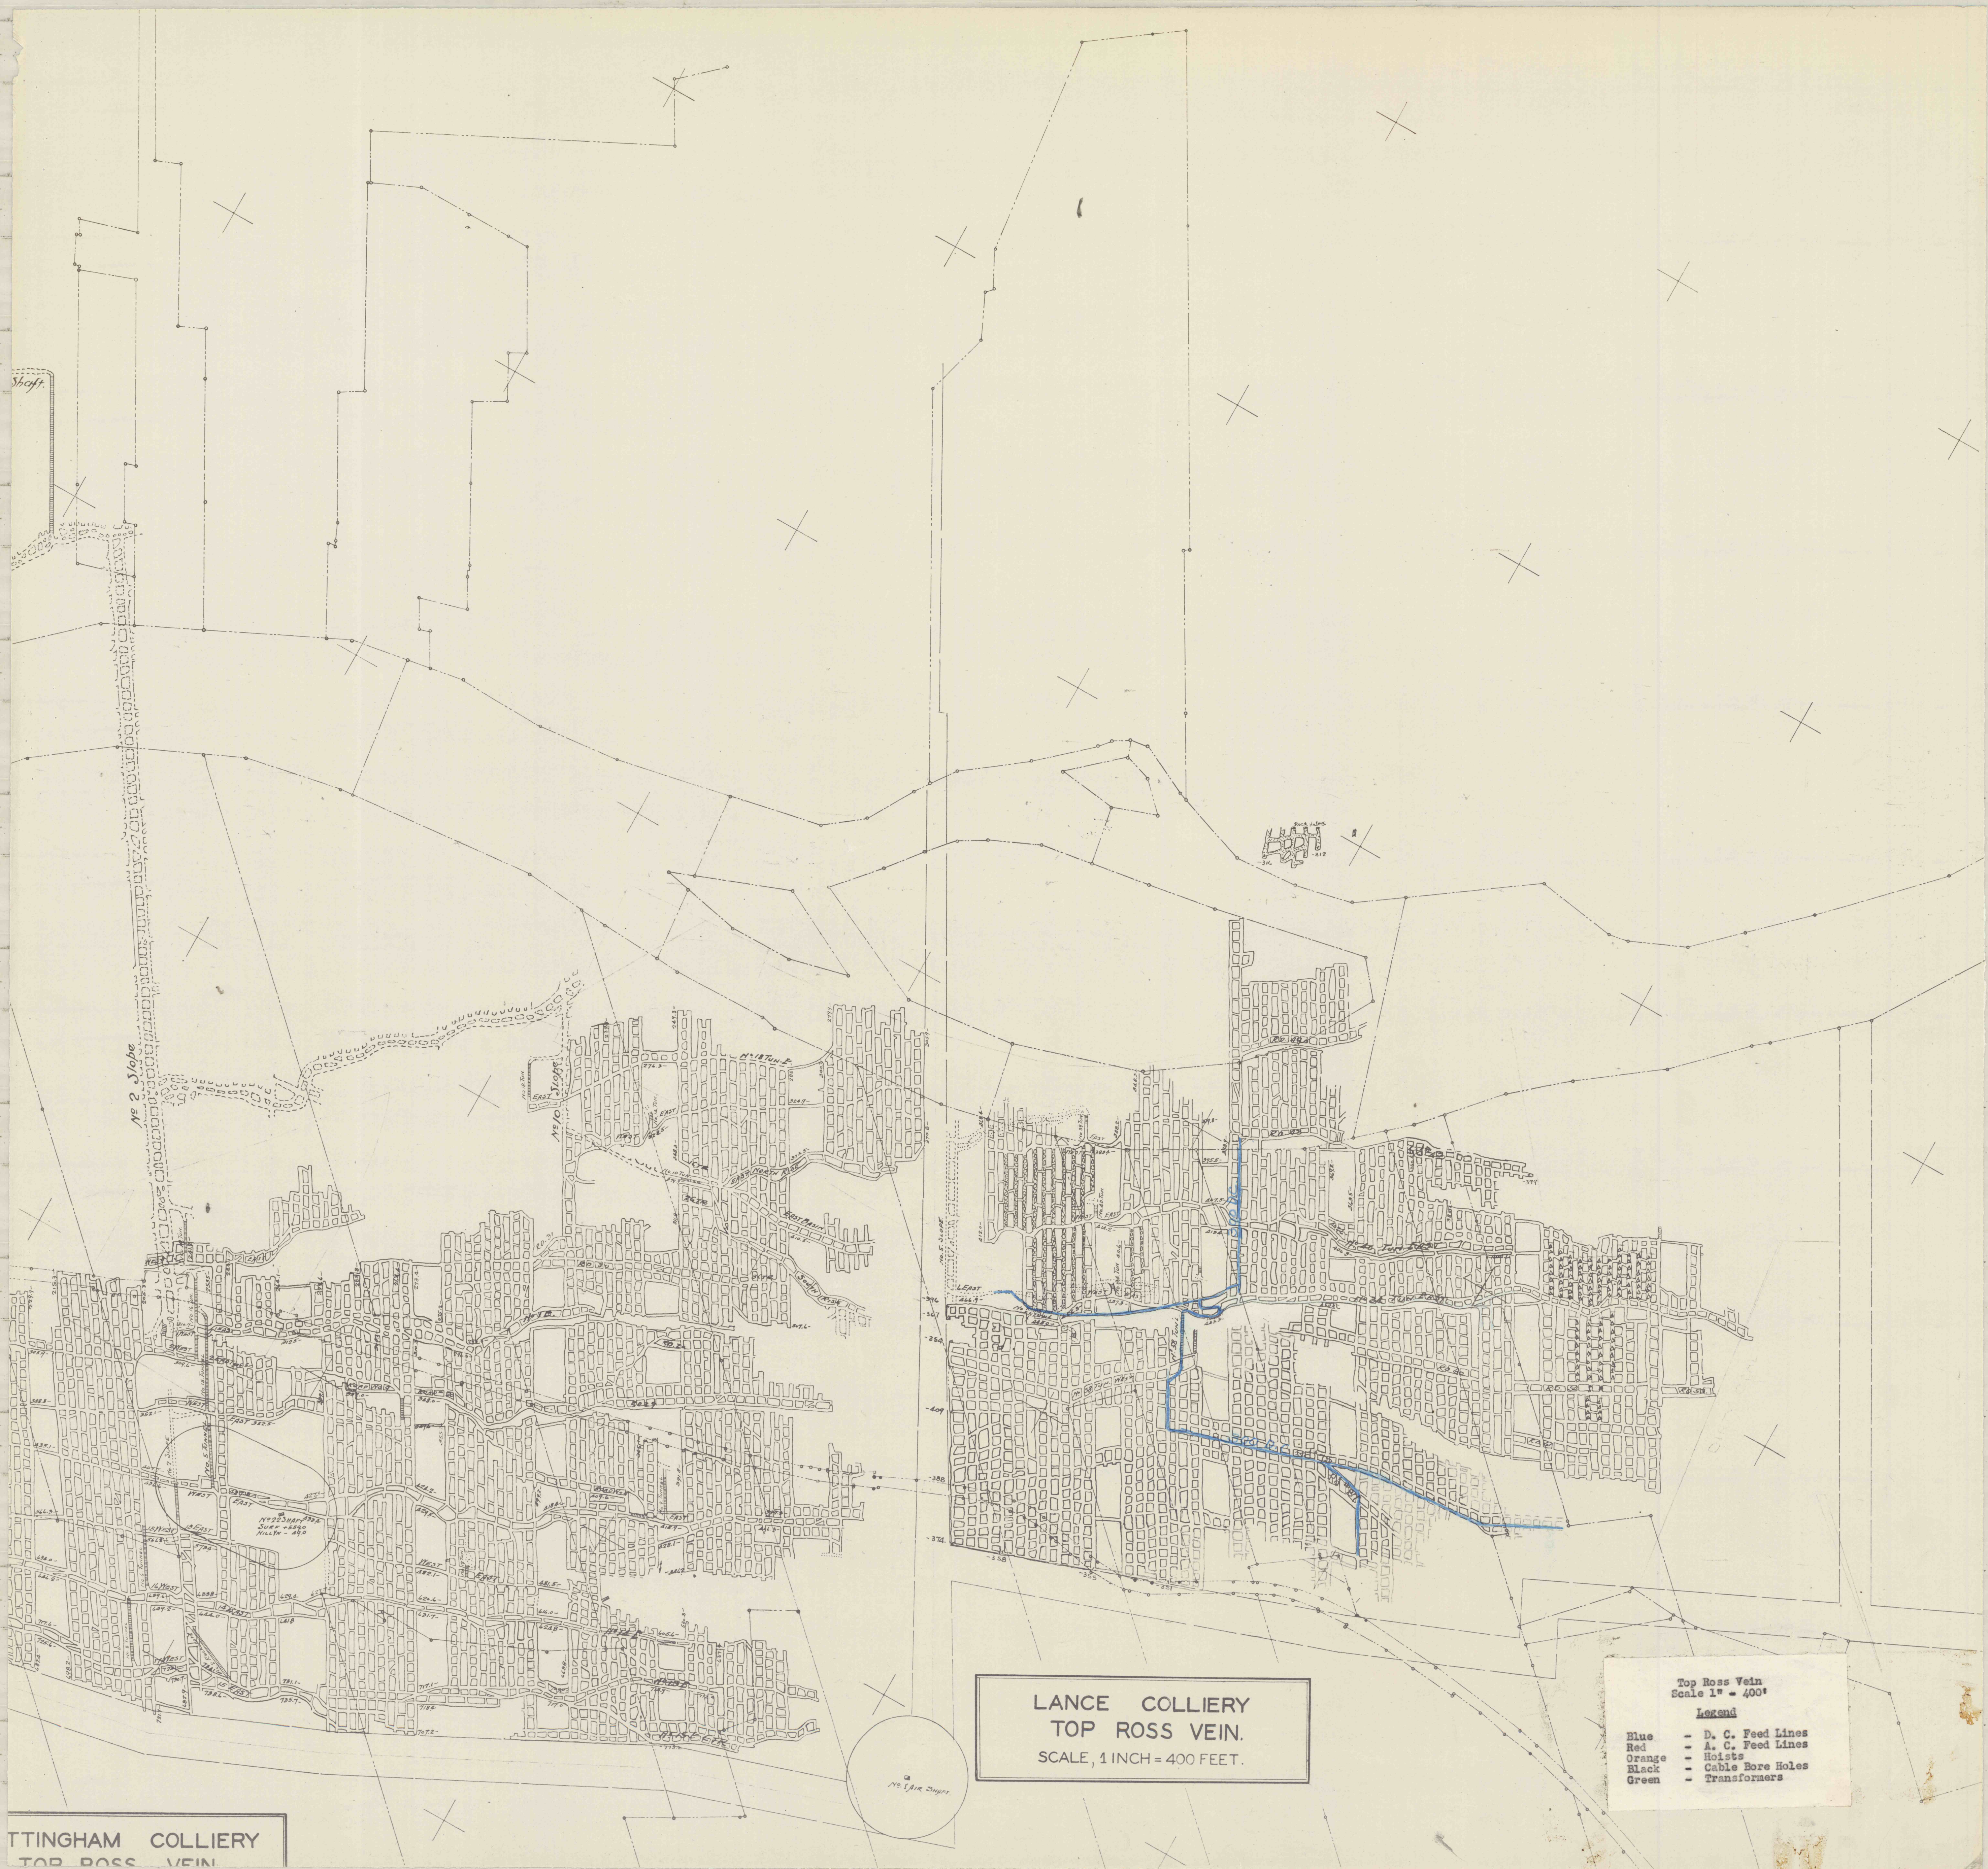

No 2 Slope

No 1 Air Shaft

LANCE COLLIERY
TOP ROSS VEIN.
SCALE, 1 INCH = 400 FEET.

Top Ross Vein
Scale 1" = 400'

Legend

Blue - D. C. Feed Lines
Red - A. C. Feed Lines
Orange - Hoists
Black - Cable Bore Holes
Green - Transformers

TINGHAM COLLIERY
TOP ROSS VEIN