


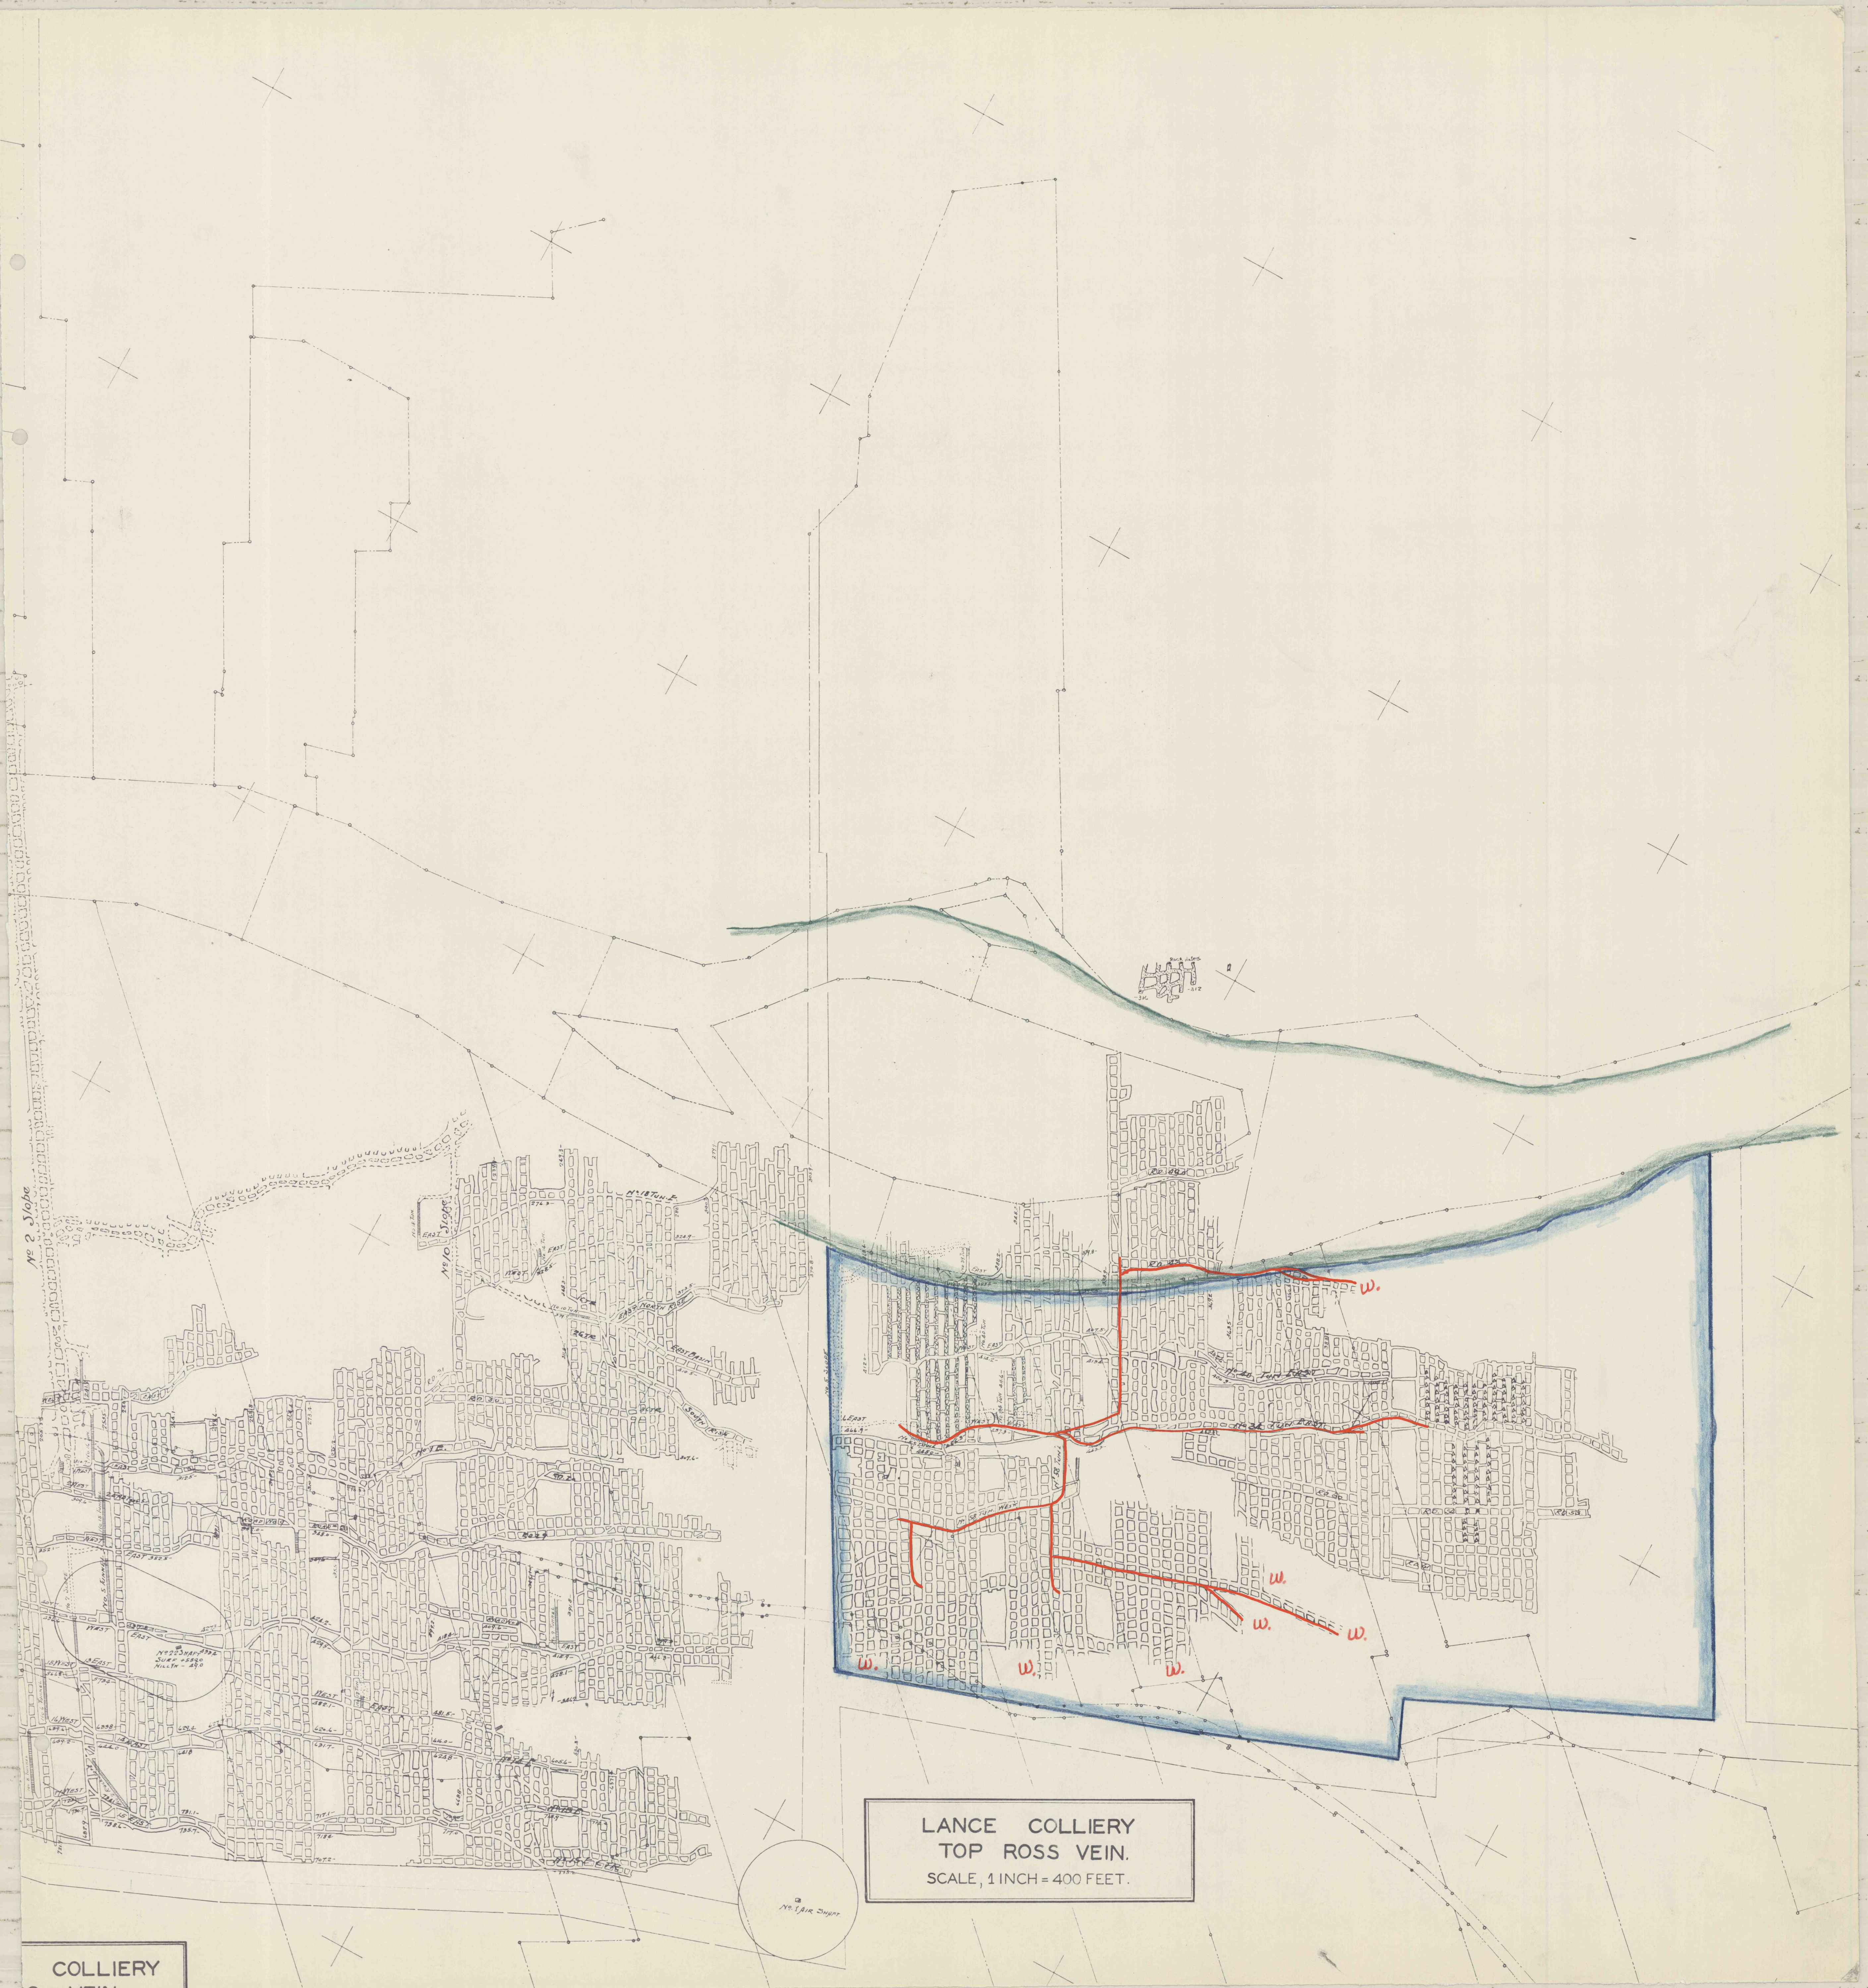

LANCE COLLIERY
TOP ROSS VEIN.
SCALE, 1 INCH = 400 FEET.

COLLIERY