


19300 N

19500 N

19200 N

19200 N

Datum 6000

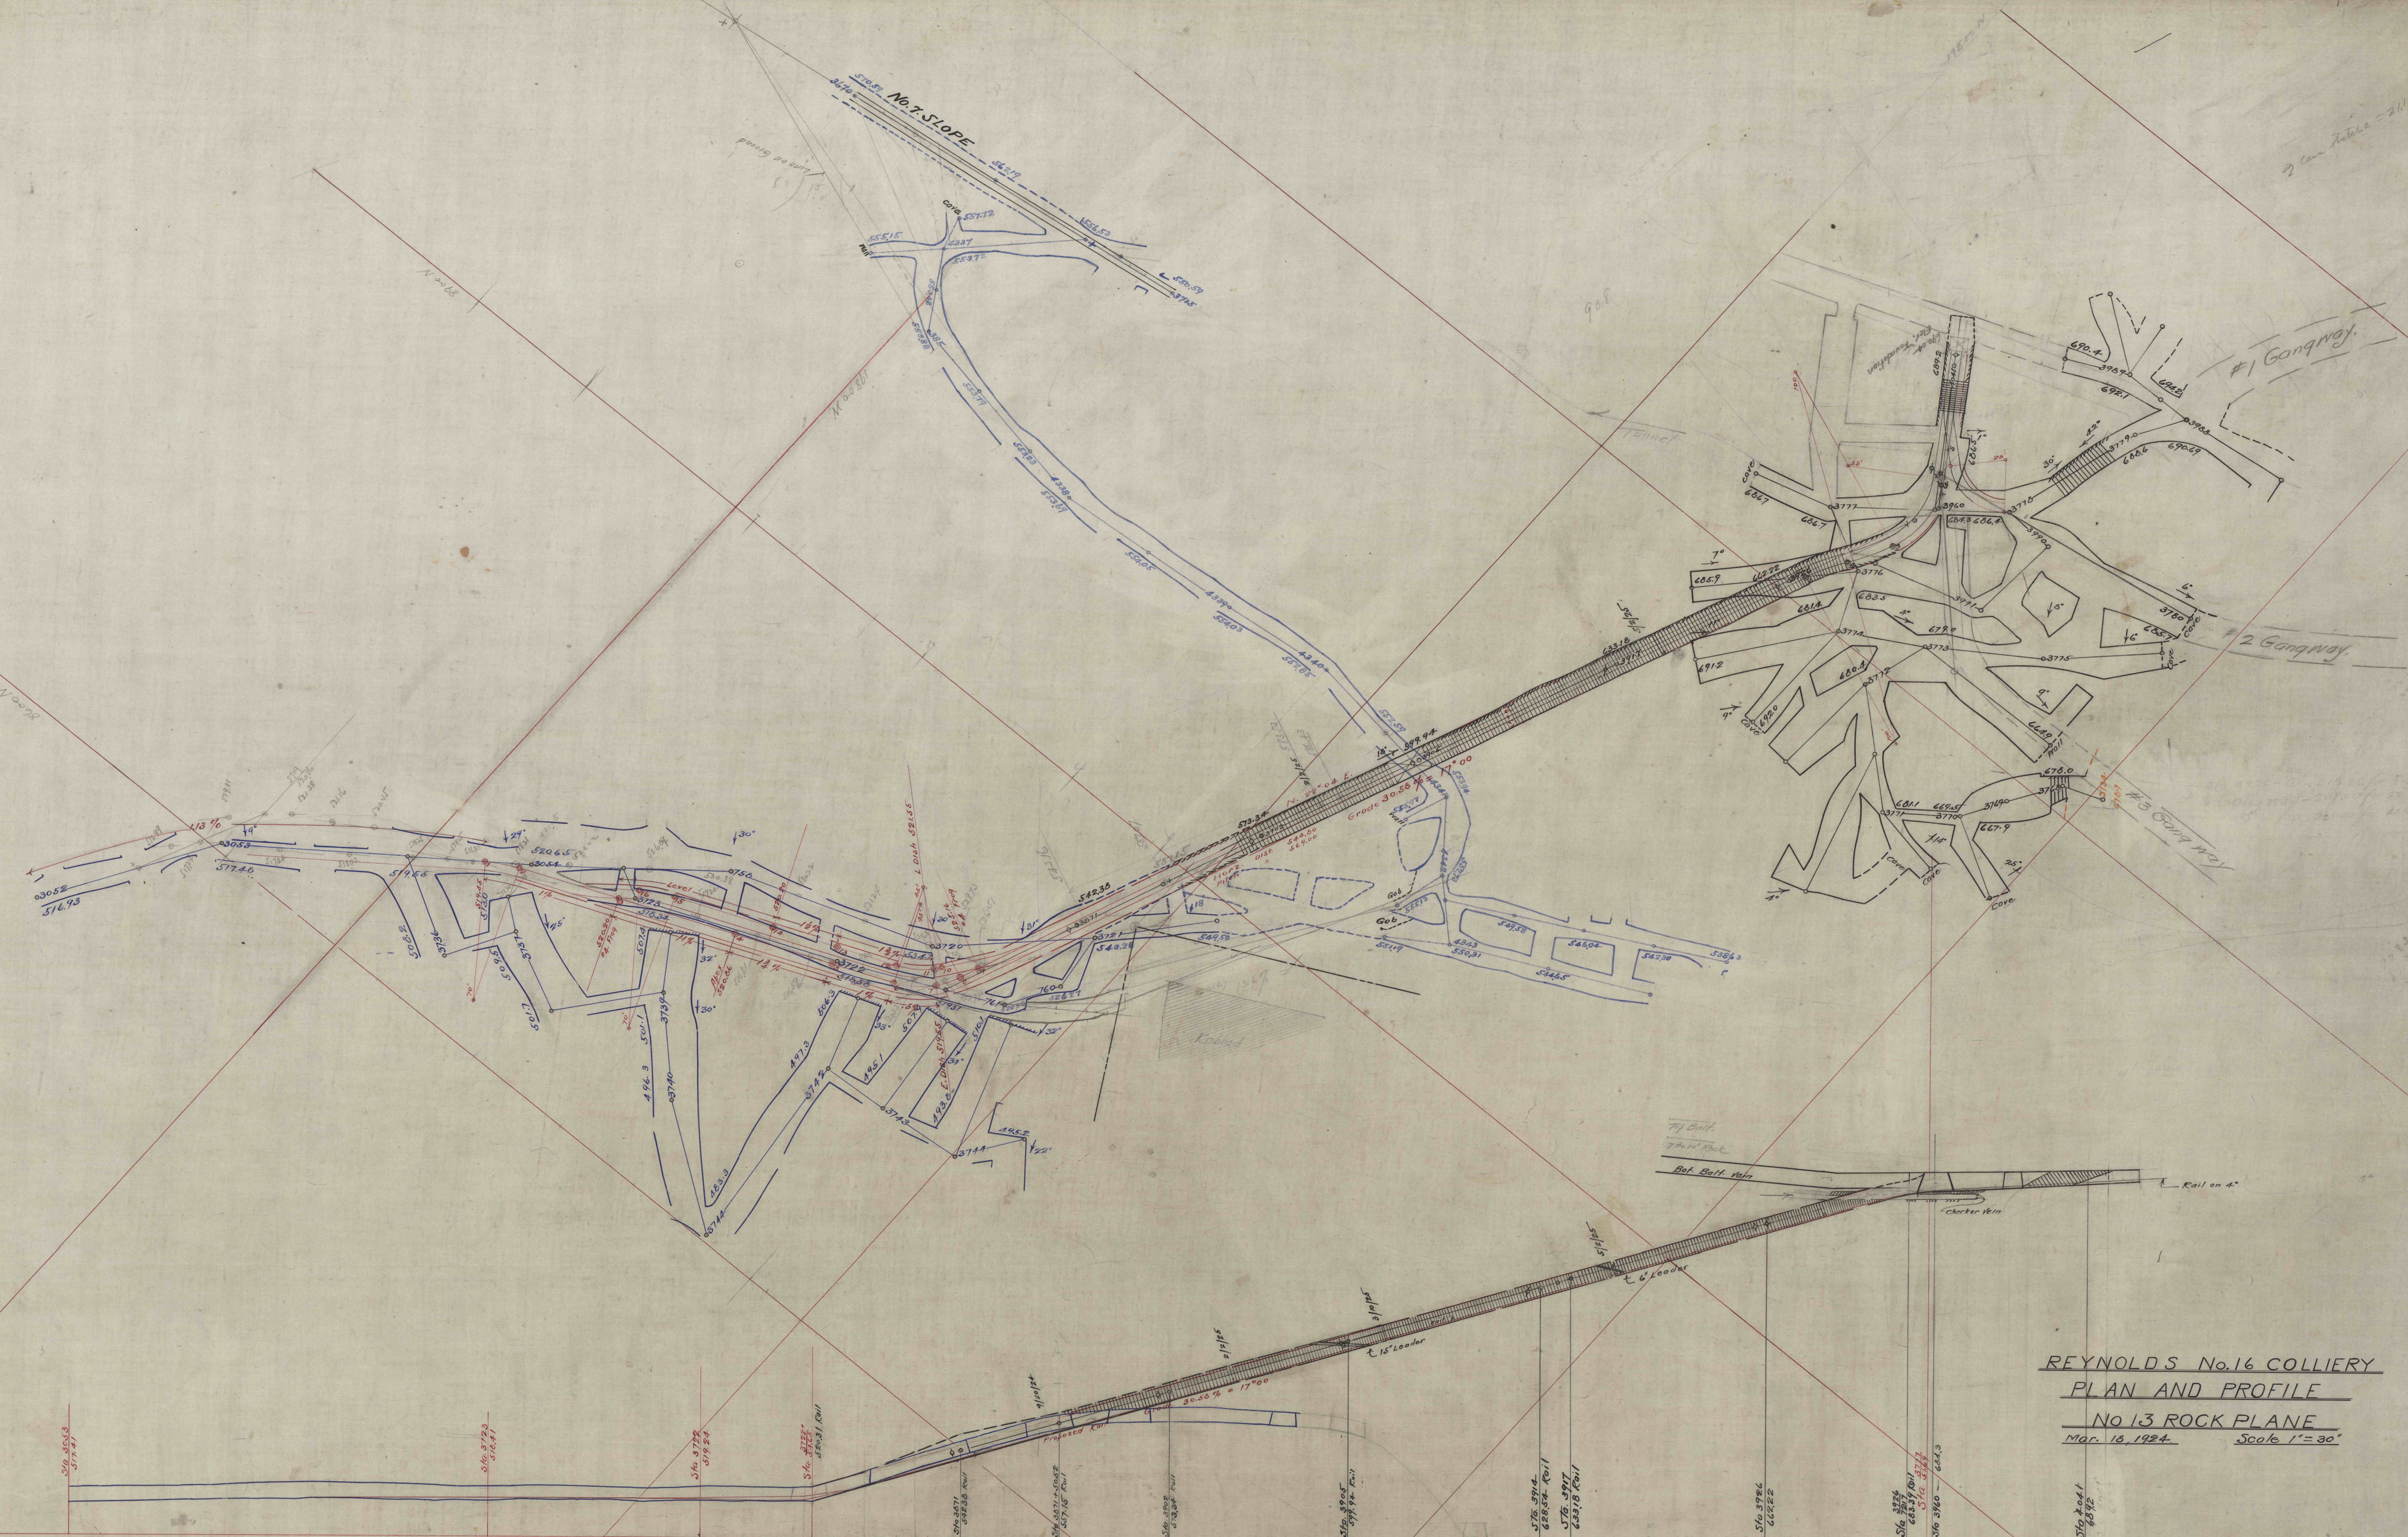

REYNOLDS No. 16 COLLIERY
PLAN AND PROFILE
No. 13 ROCK PLANE
Mar. 18, 1924. Scale 1" = 30'