


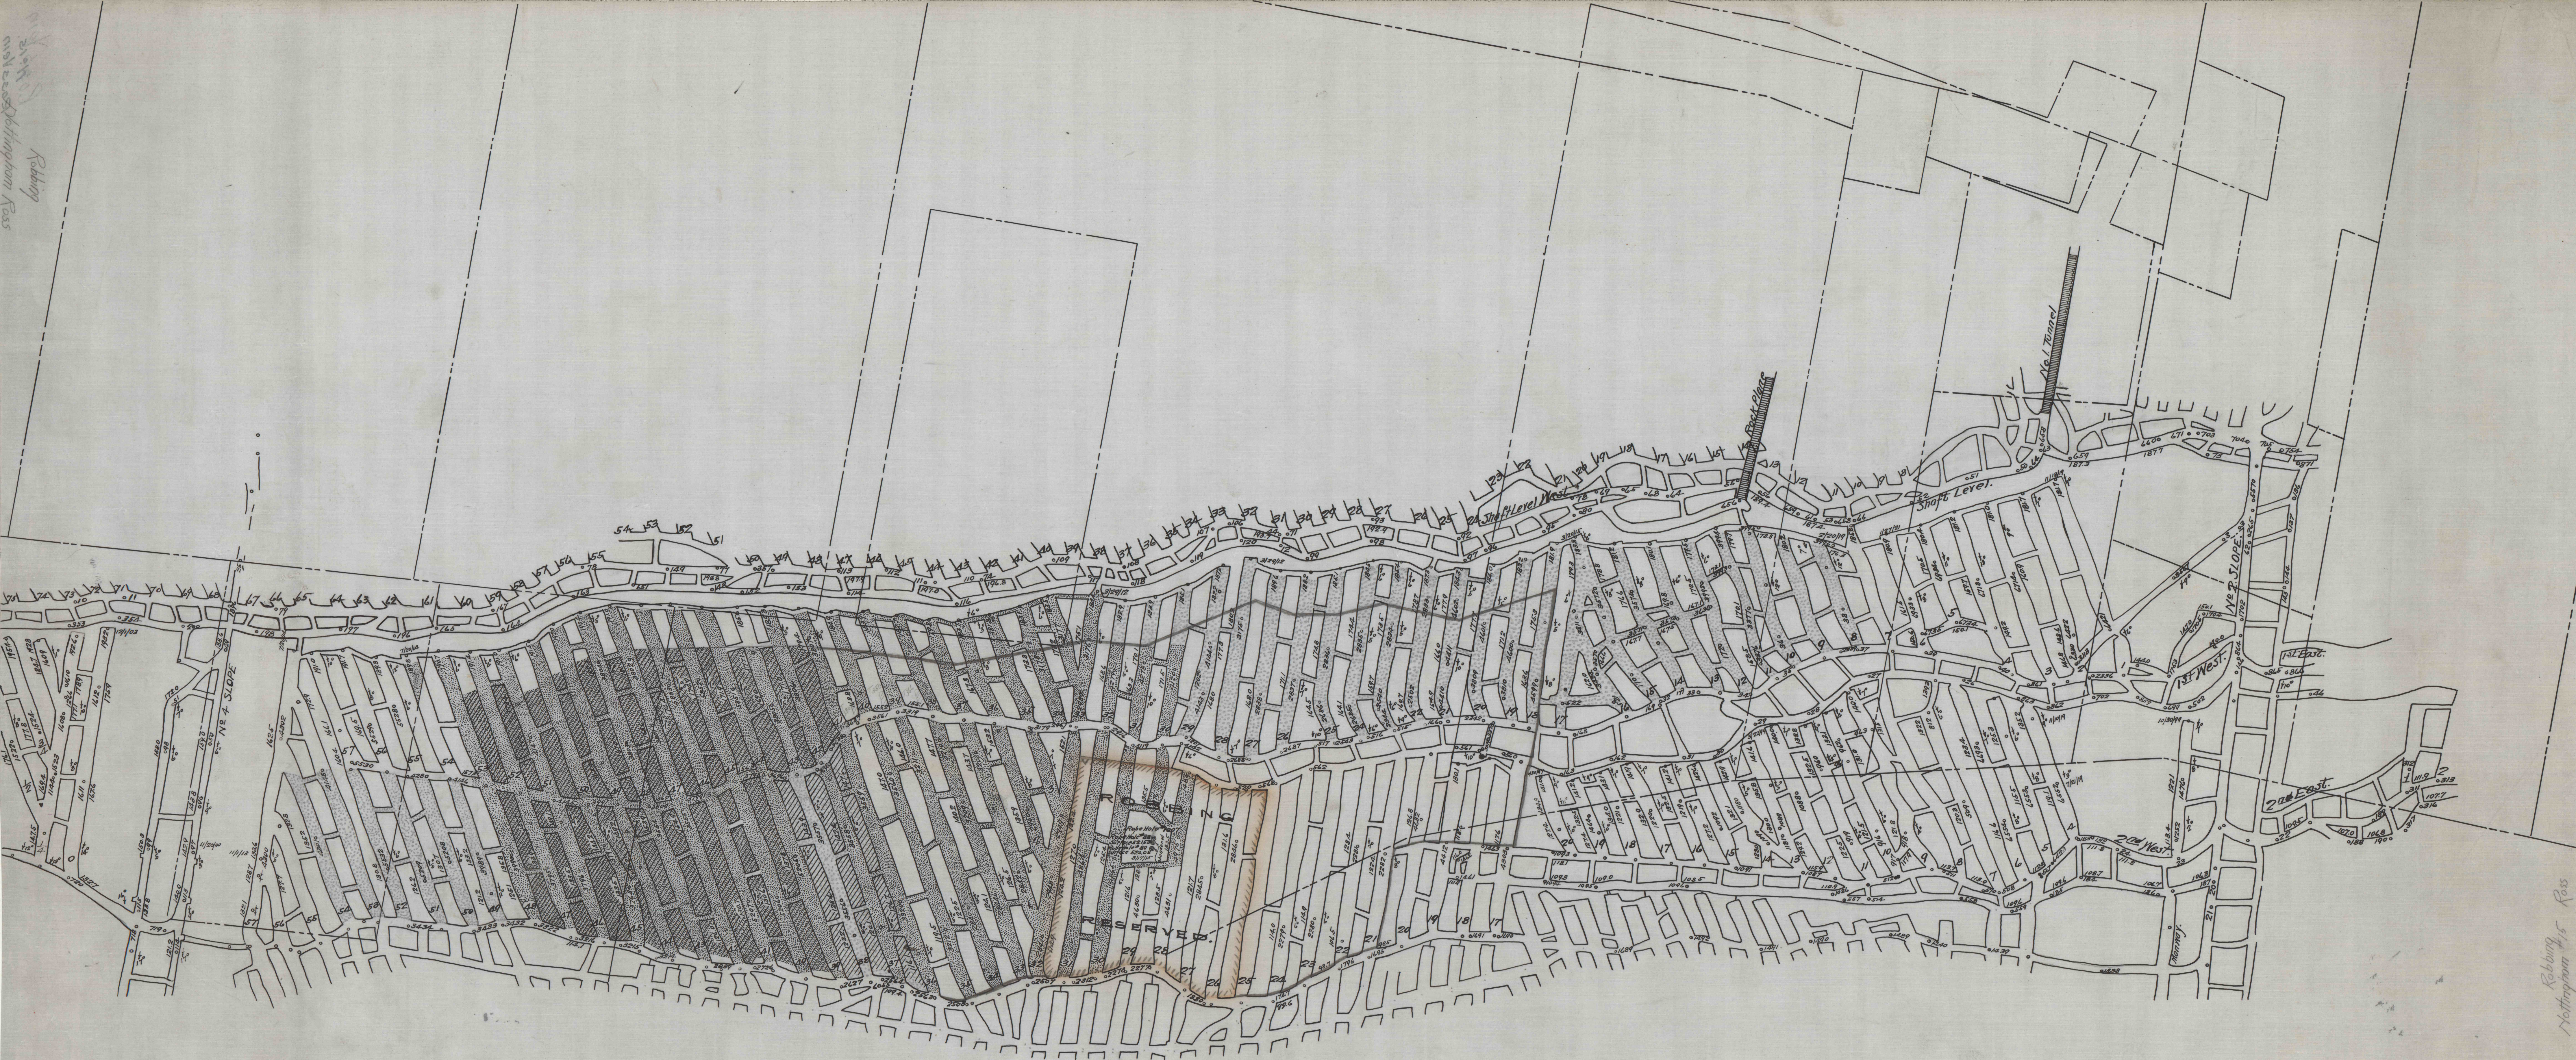

Robbing
Nottingham Ross

Robbing
Nottingham Ross

Nottingham
Ross Vein