


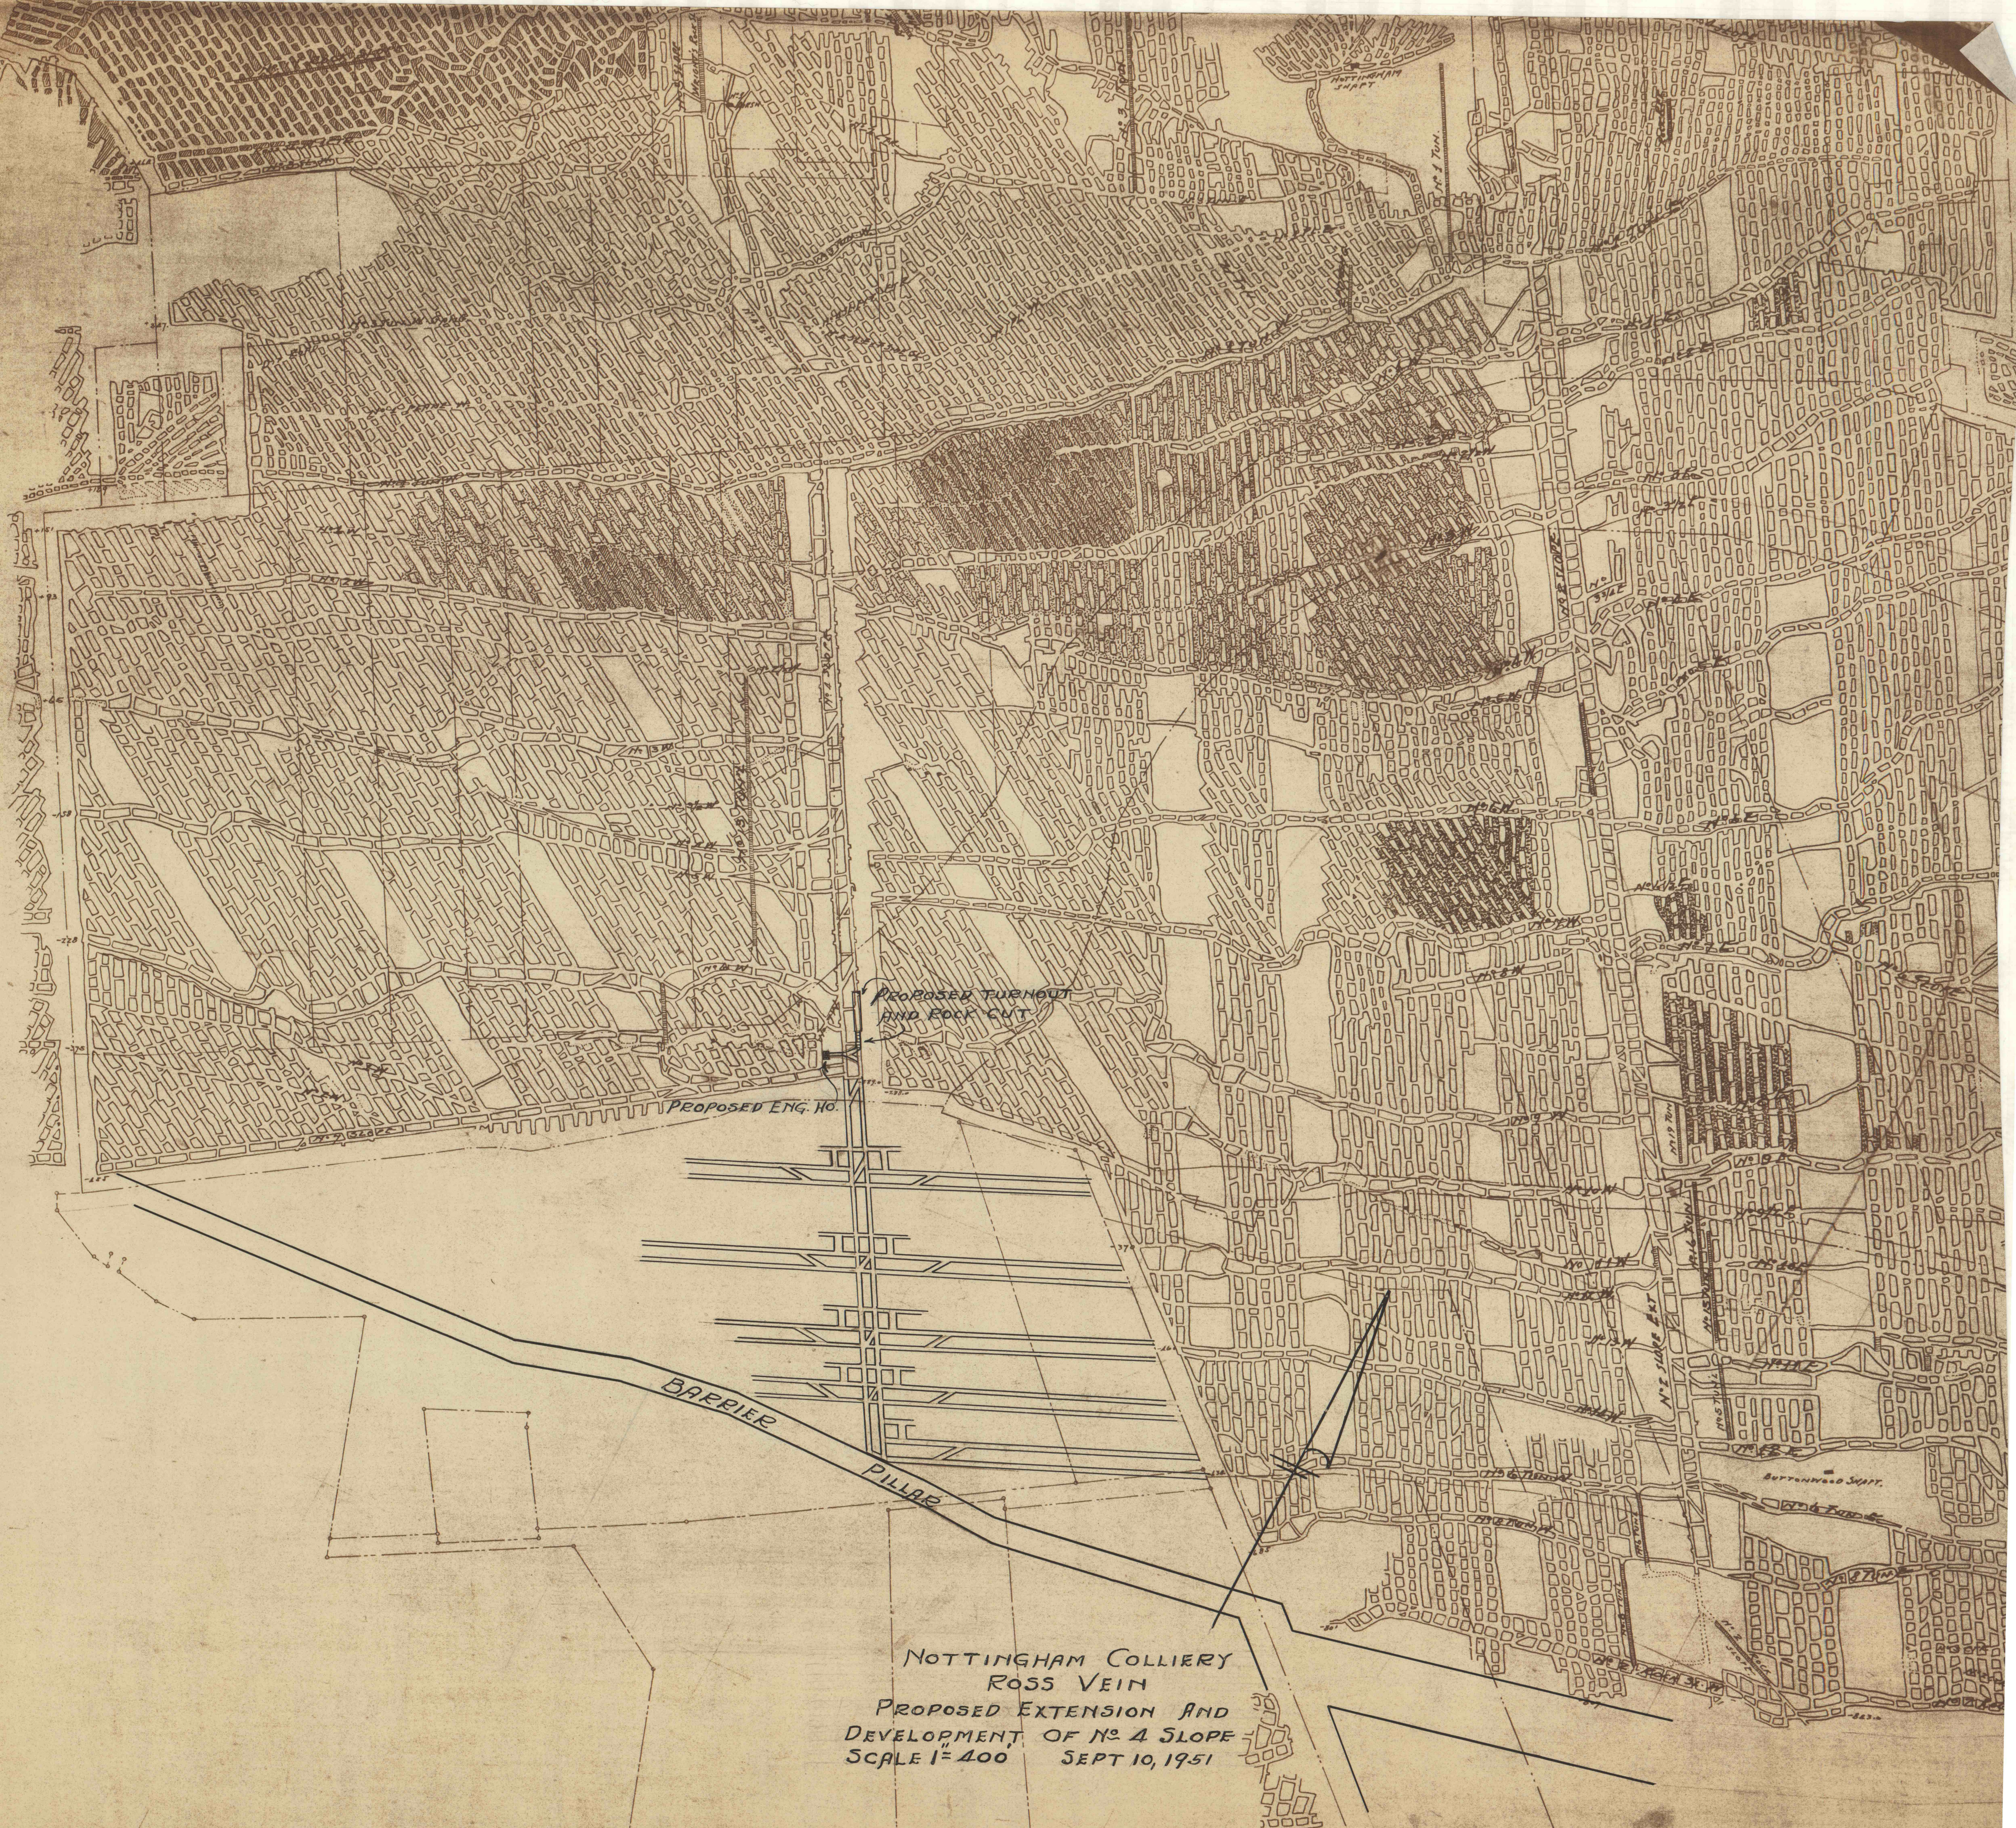

NOTTINGHAM COLLIERY
ROSS VEIN
PROPOSED EXTENSION AND
DEVELOPMENT OF NO 4 SLOPE
SCALE 1"=400 SEPT 10, 1951