


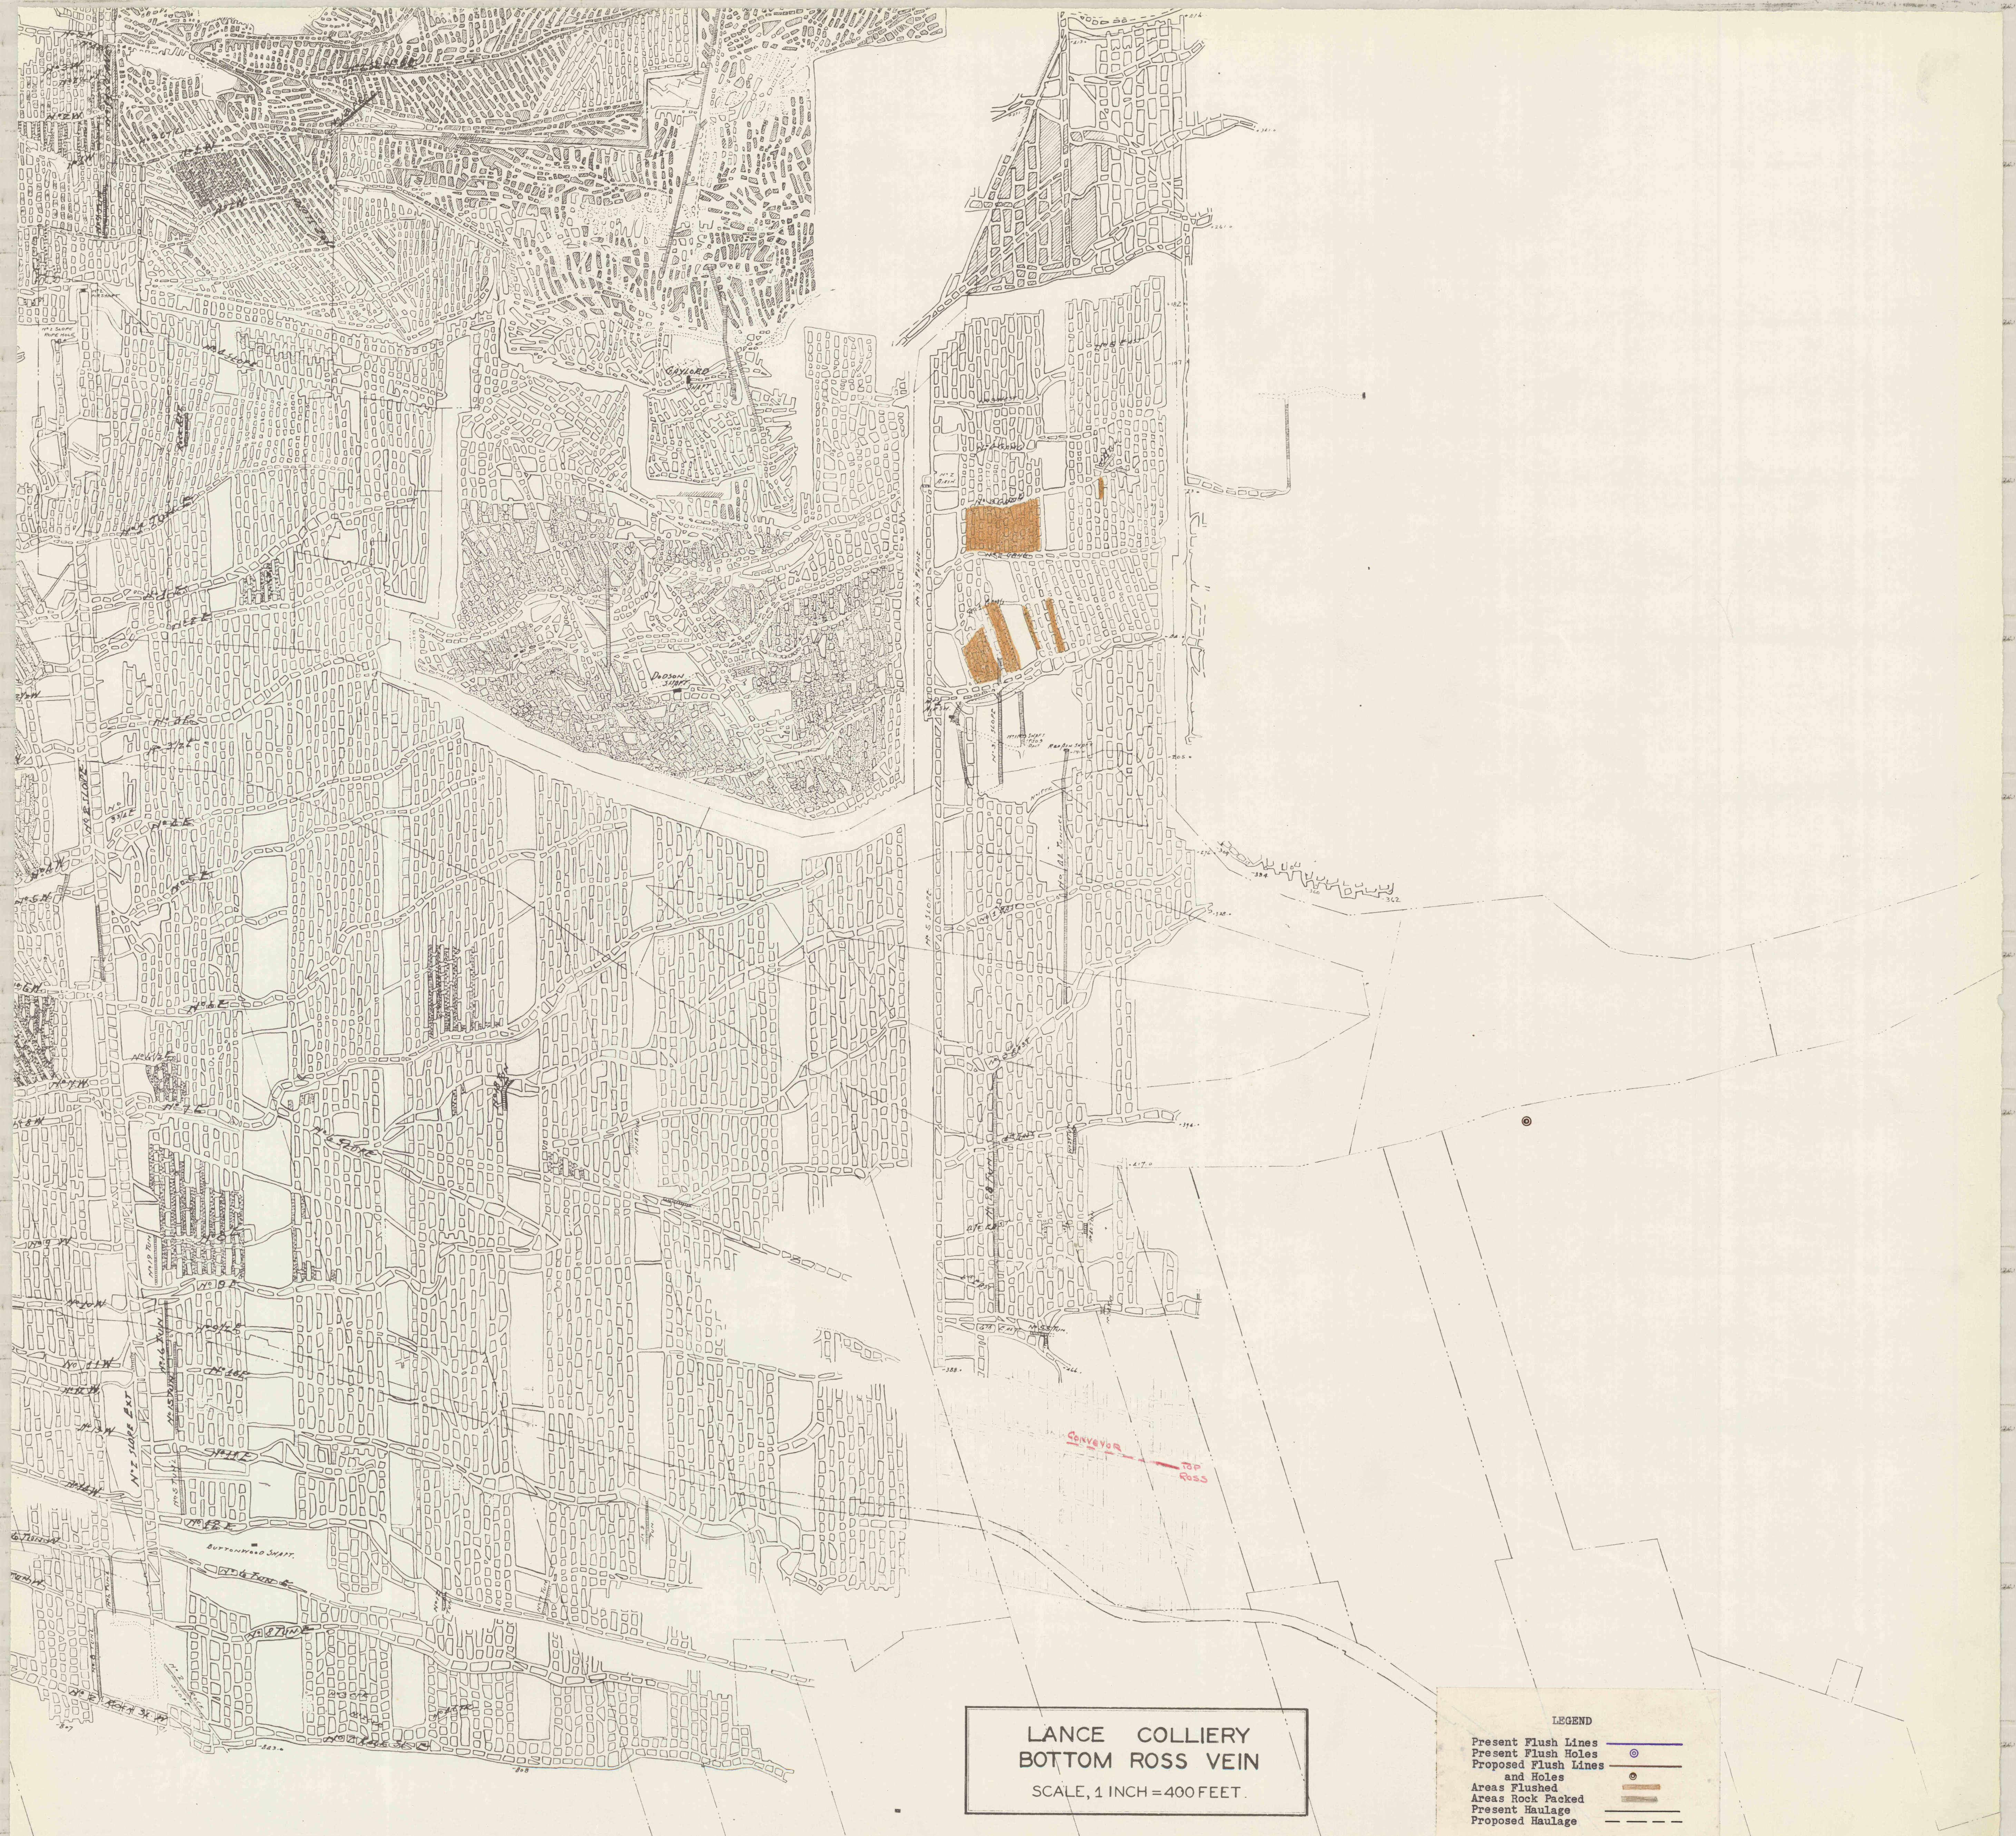

LANCE COLLIERY
BOTTOM ROSS VEIN
SCALE, 1 INCH = 400 FEET.

LEGEND

Present Flush Lines	—
Present Flush Holes	⊙
Proposed Flush Lines and Holes	⊙
Areas Flushed	—
Areas Rock Packed	—
Present Haulage	—
Proposed Haulage	---

NGHAM COLLIERY
TOM ROSS VEIN