


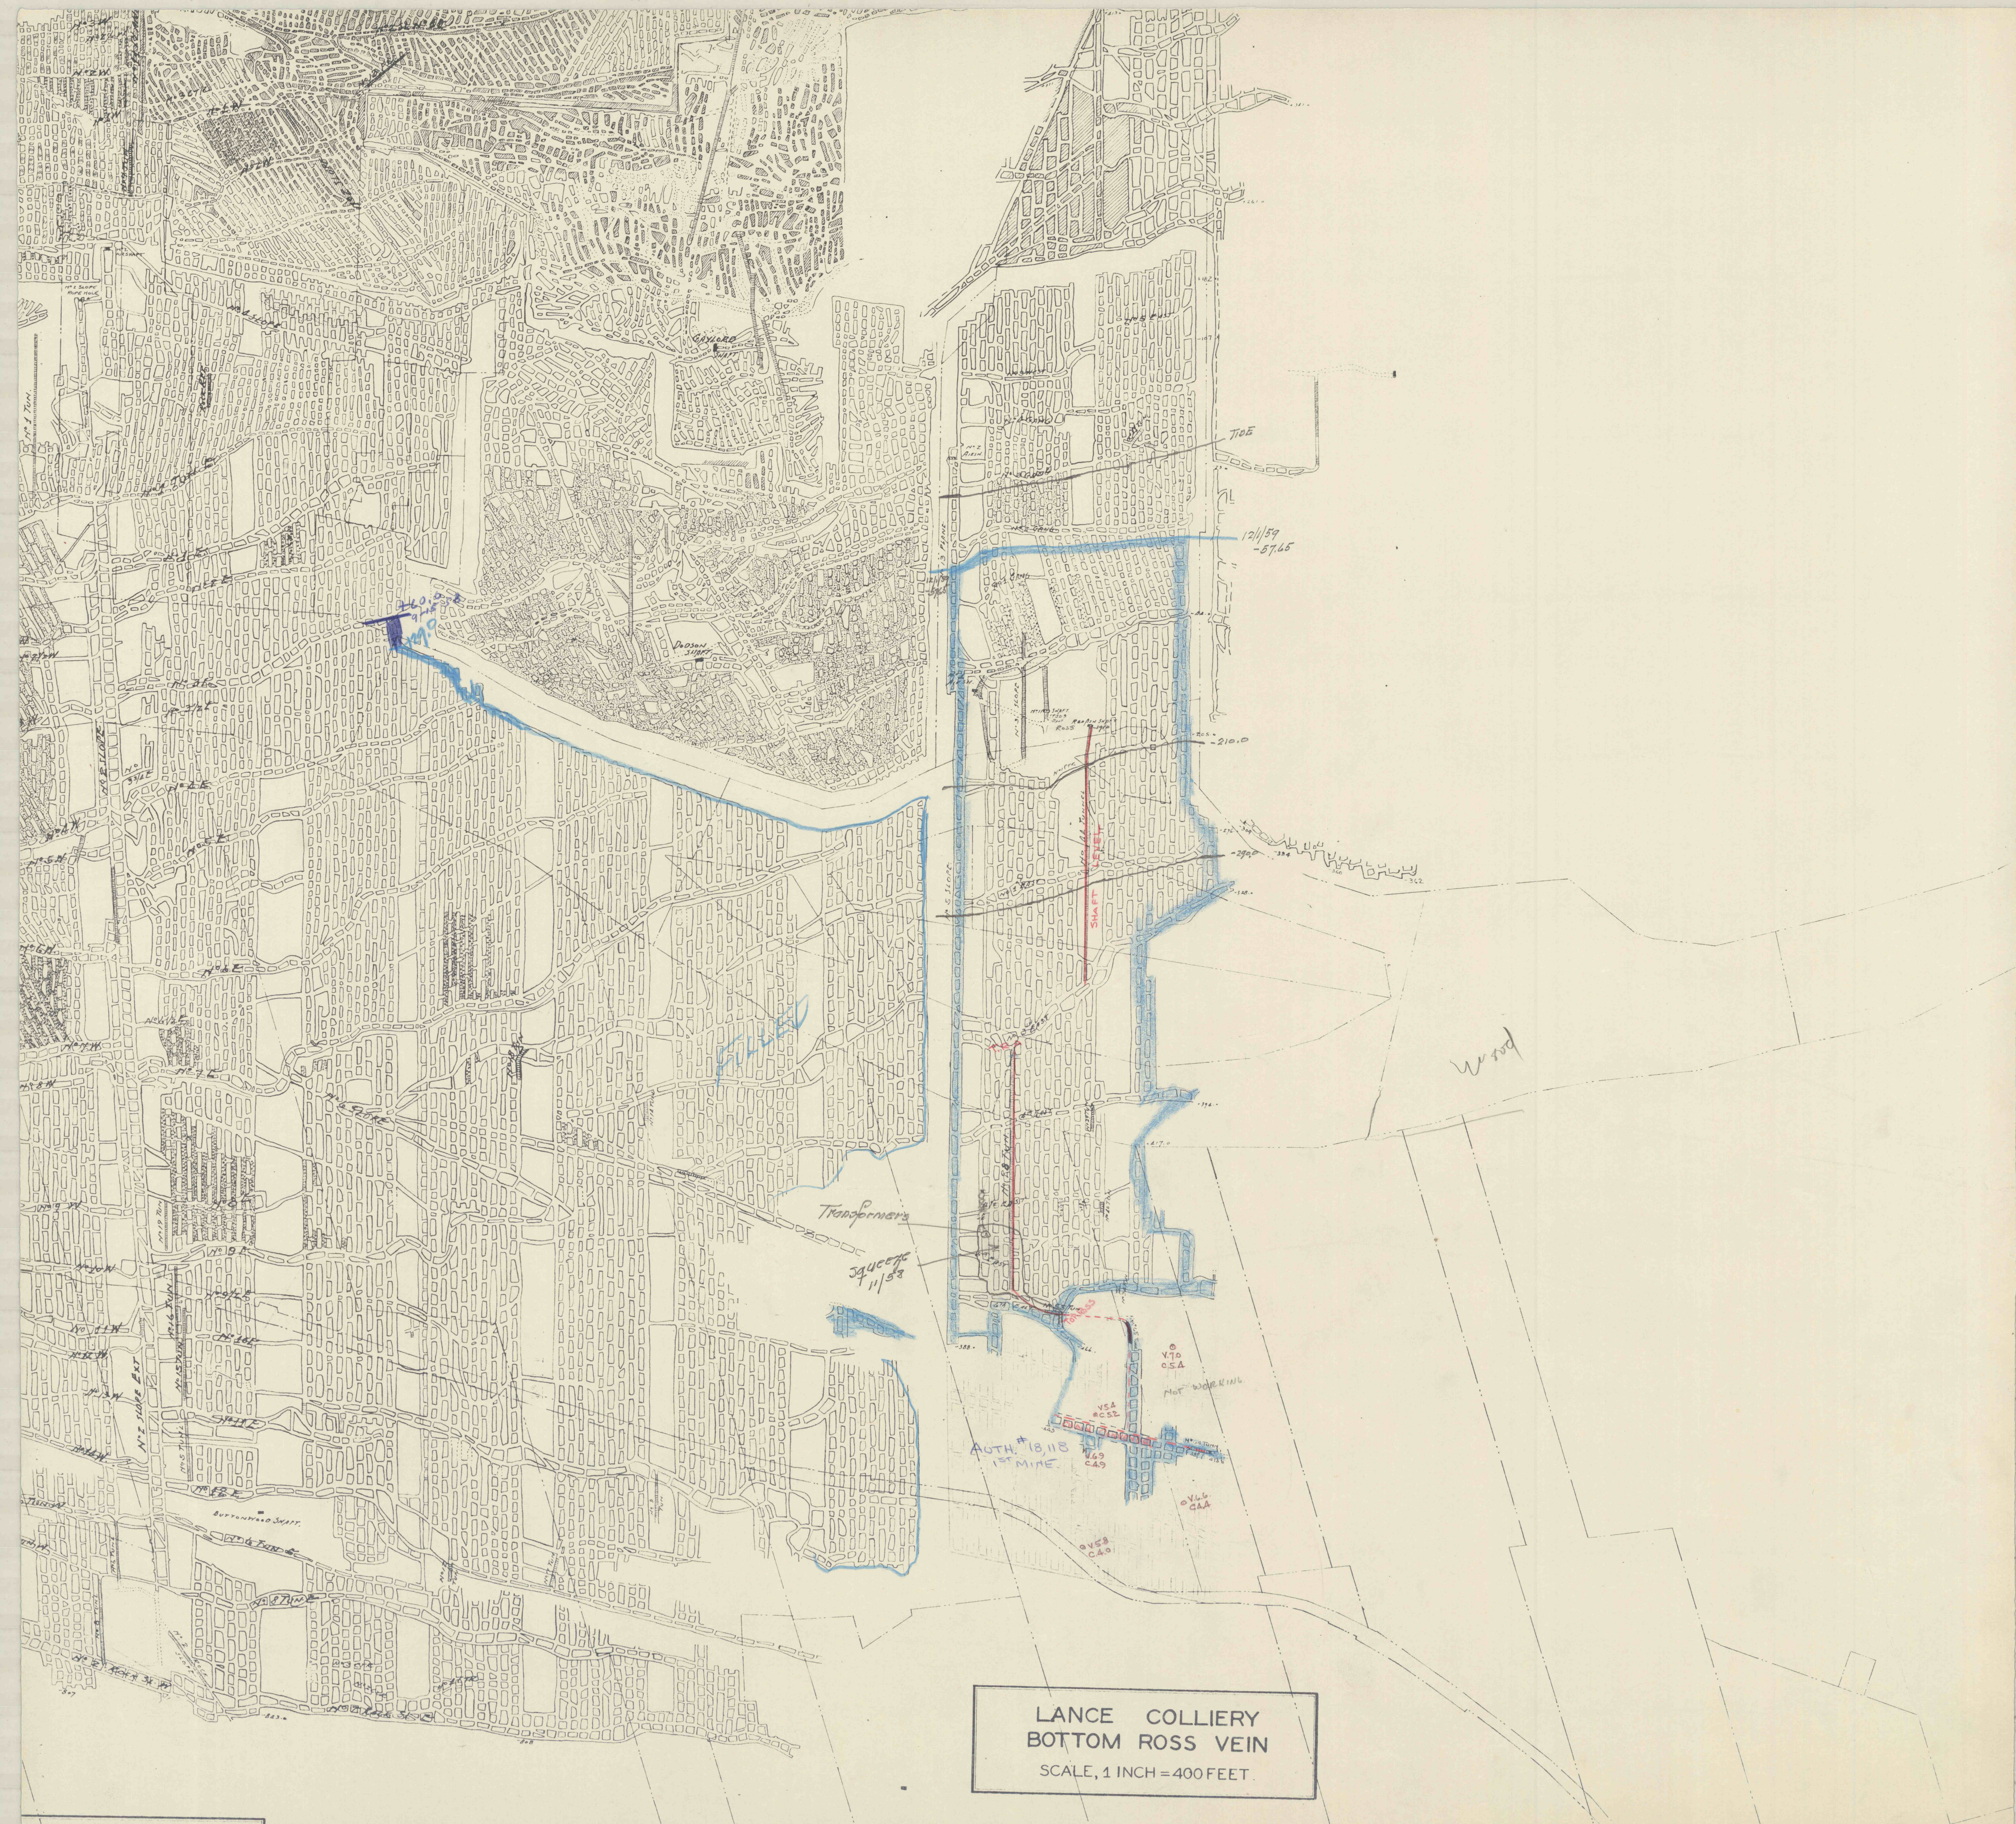

LANCE COLLIERY
BOTTOM ROSS VEIN
SCALE, 1 INCH = 400 FEET

INGHAM COLLIERY
BOTTOM ROSS VEIN
SCALE, 1 INCH = 400 FEET