


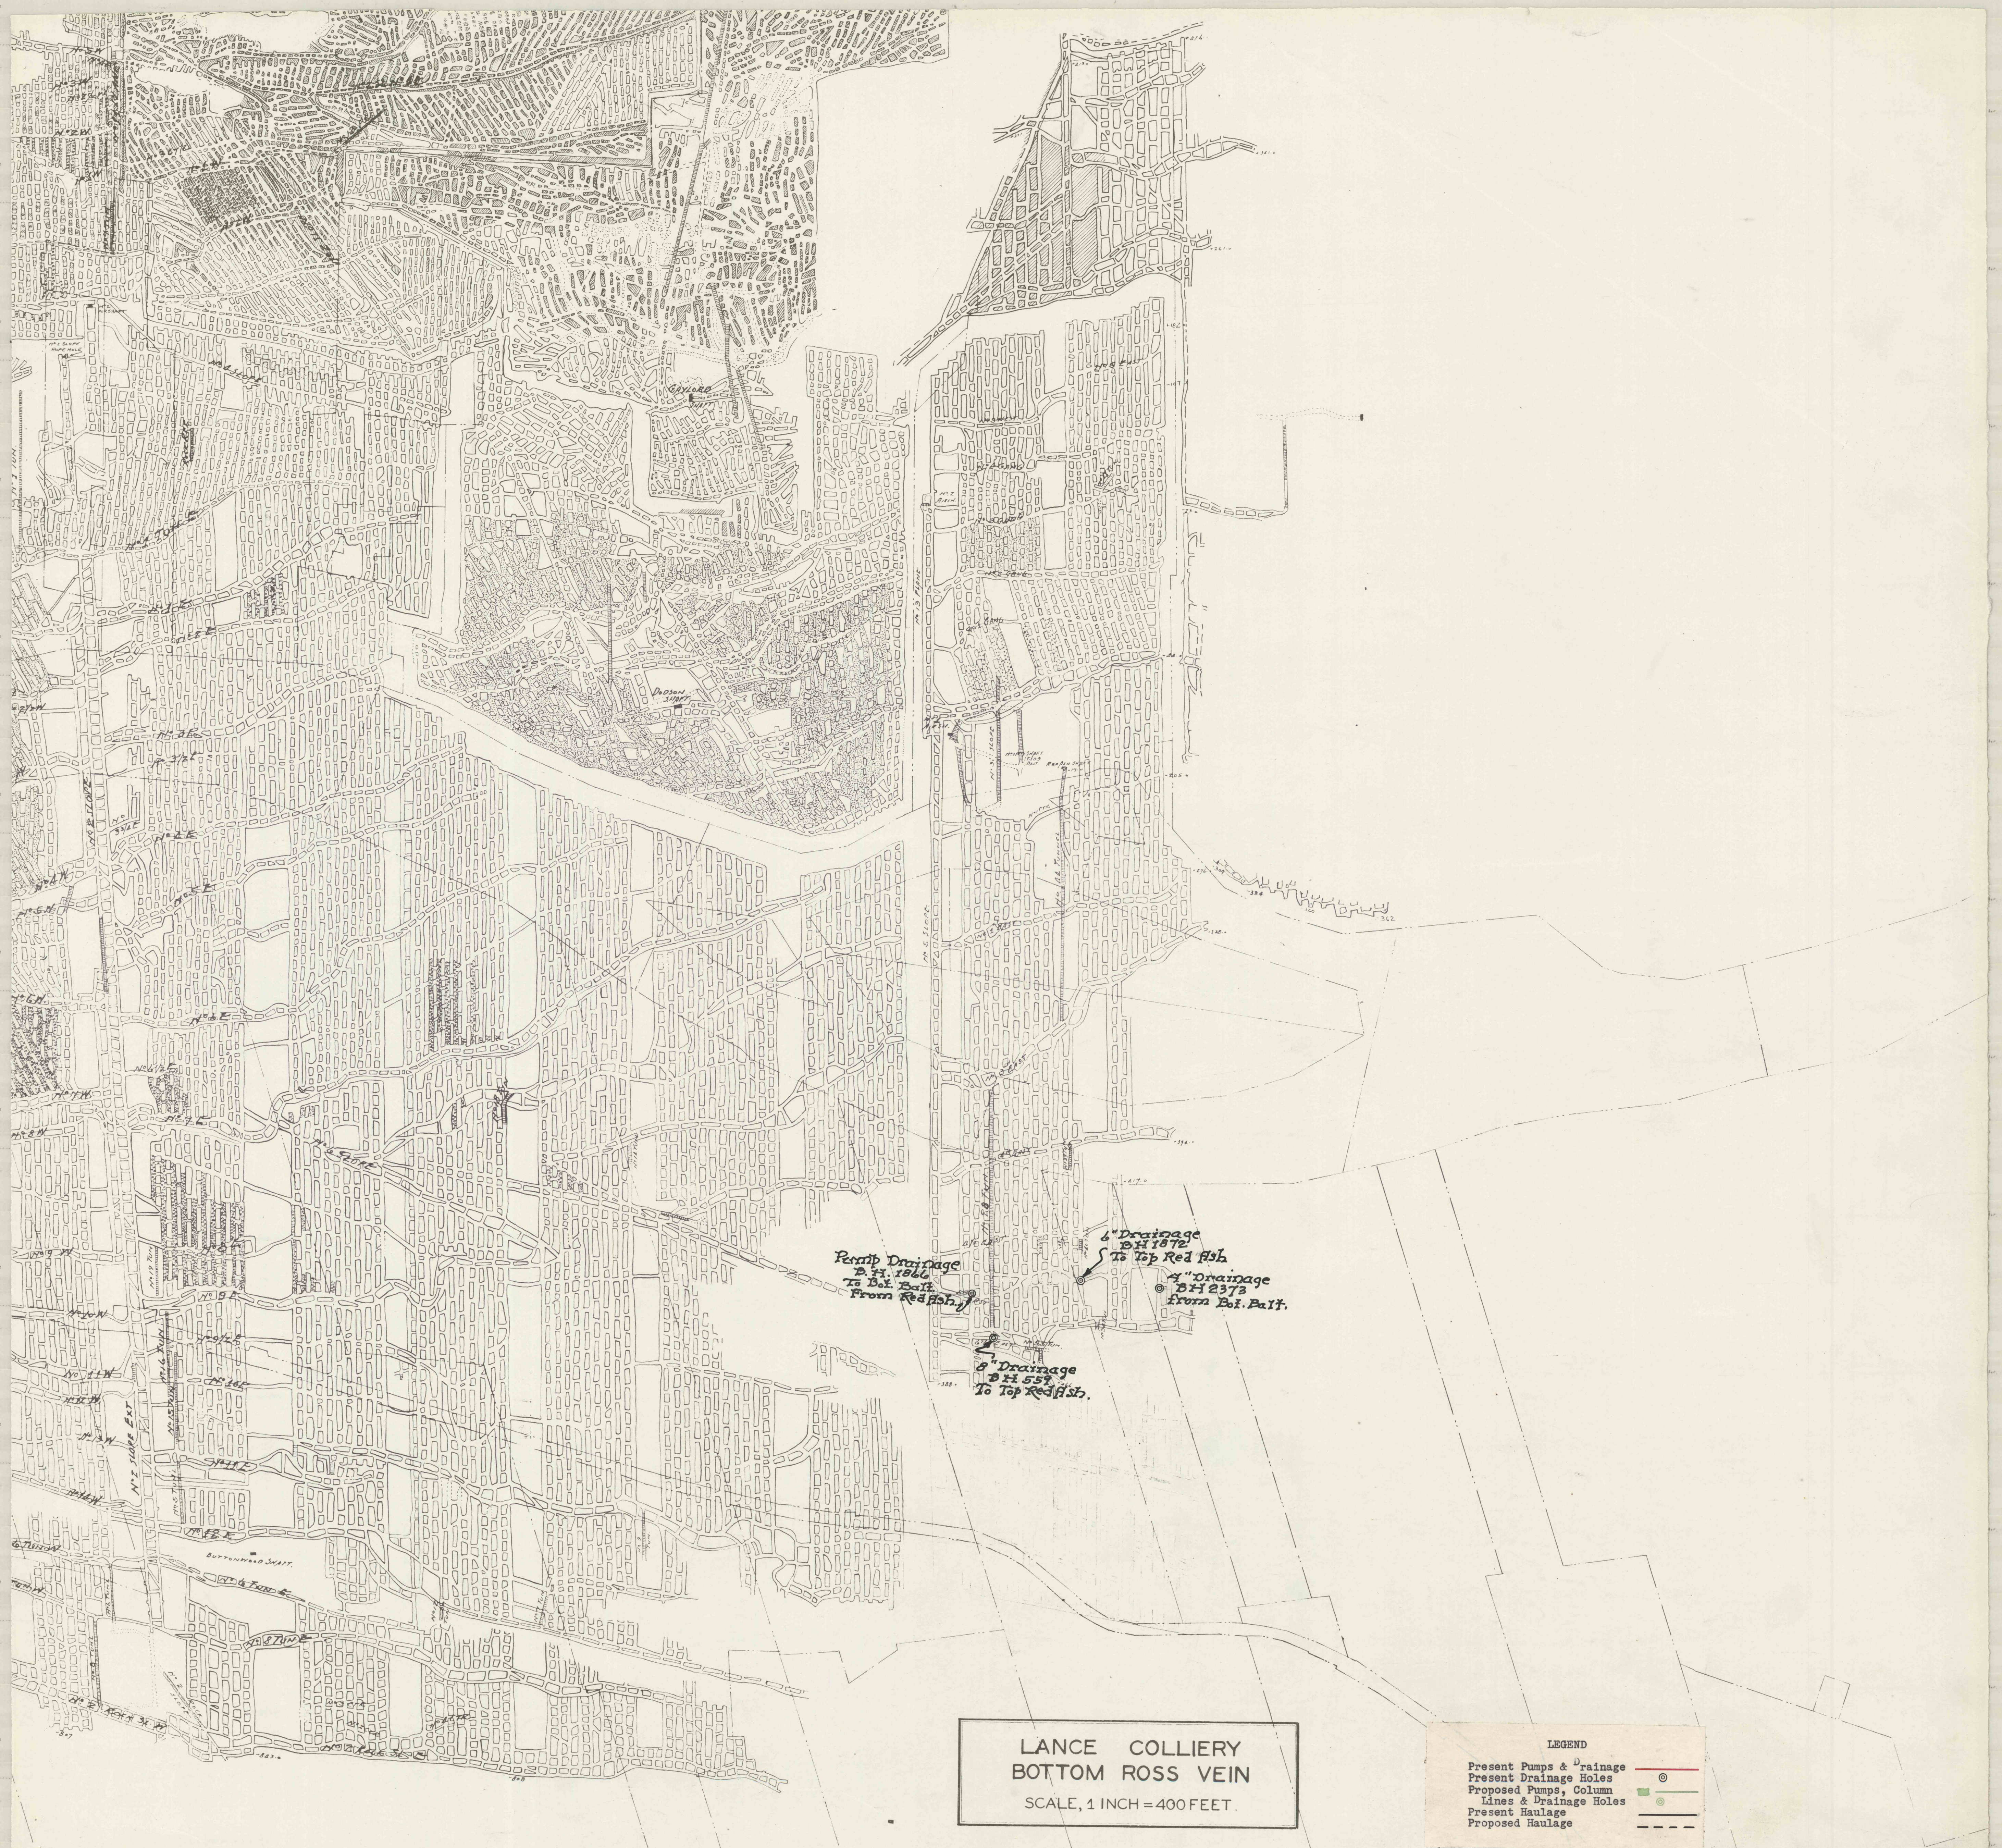

LANCE COLLIERY
BOTTOM ROSS VEIN

SCALE, 1 INCH = 400 FEET.

LEGEND

- Present Pumps & Drainage
- Present Drainage Holes
- Proposed Pumps, Column
- Lines & Drainage Holes
- Present Haulage
- Proposed Haulage

NGHAM COLLIERY
TOM ROSS VEIN