


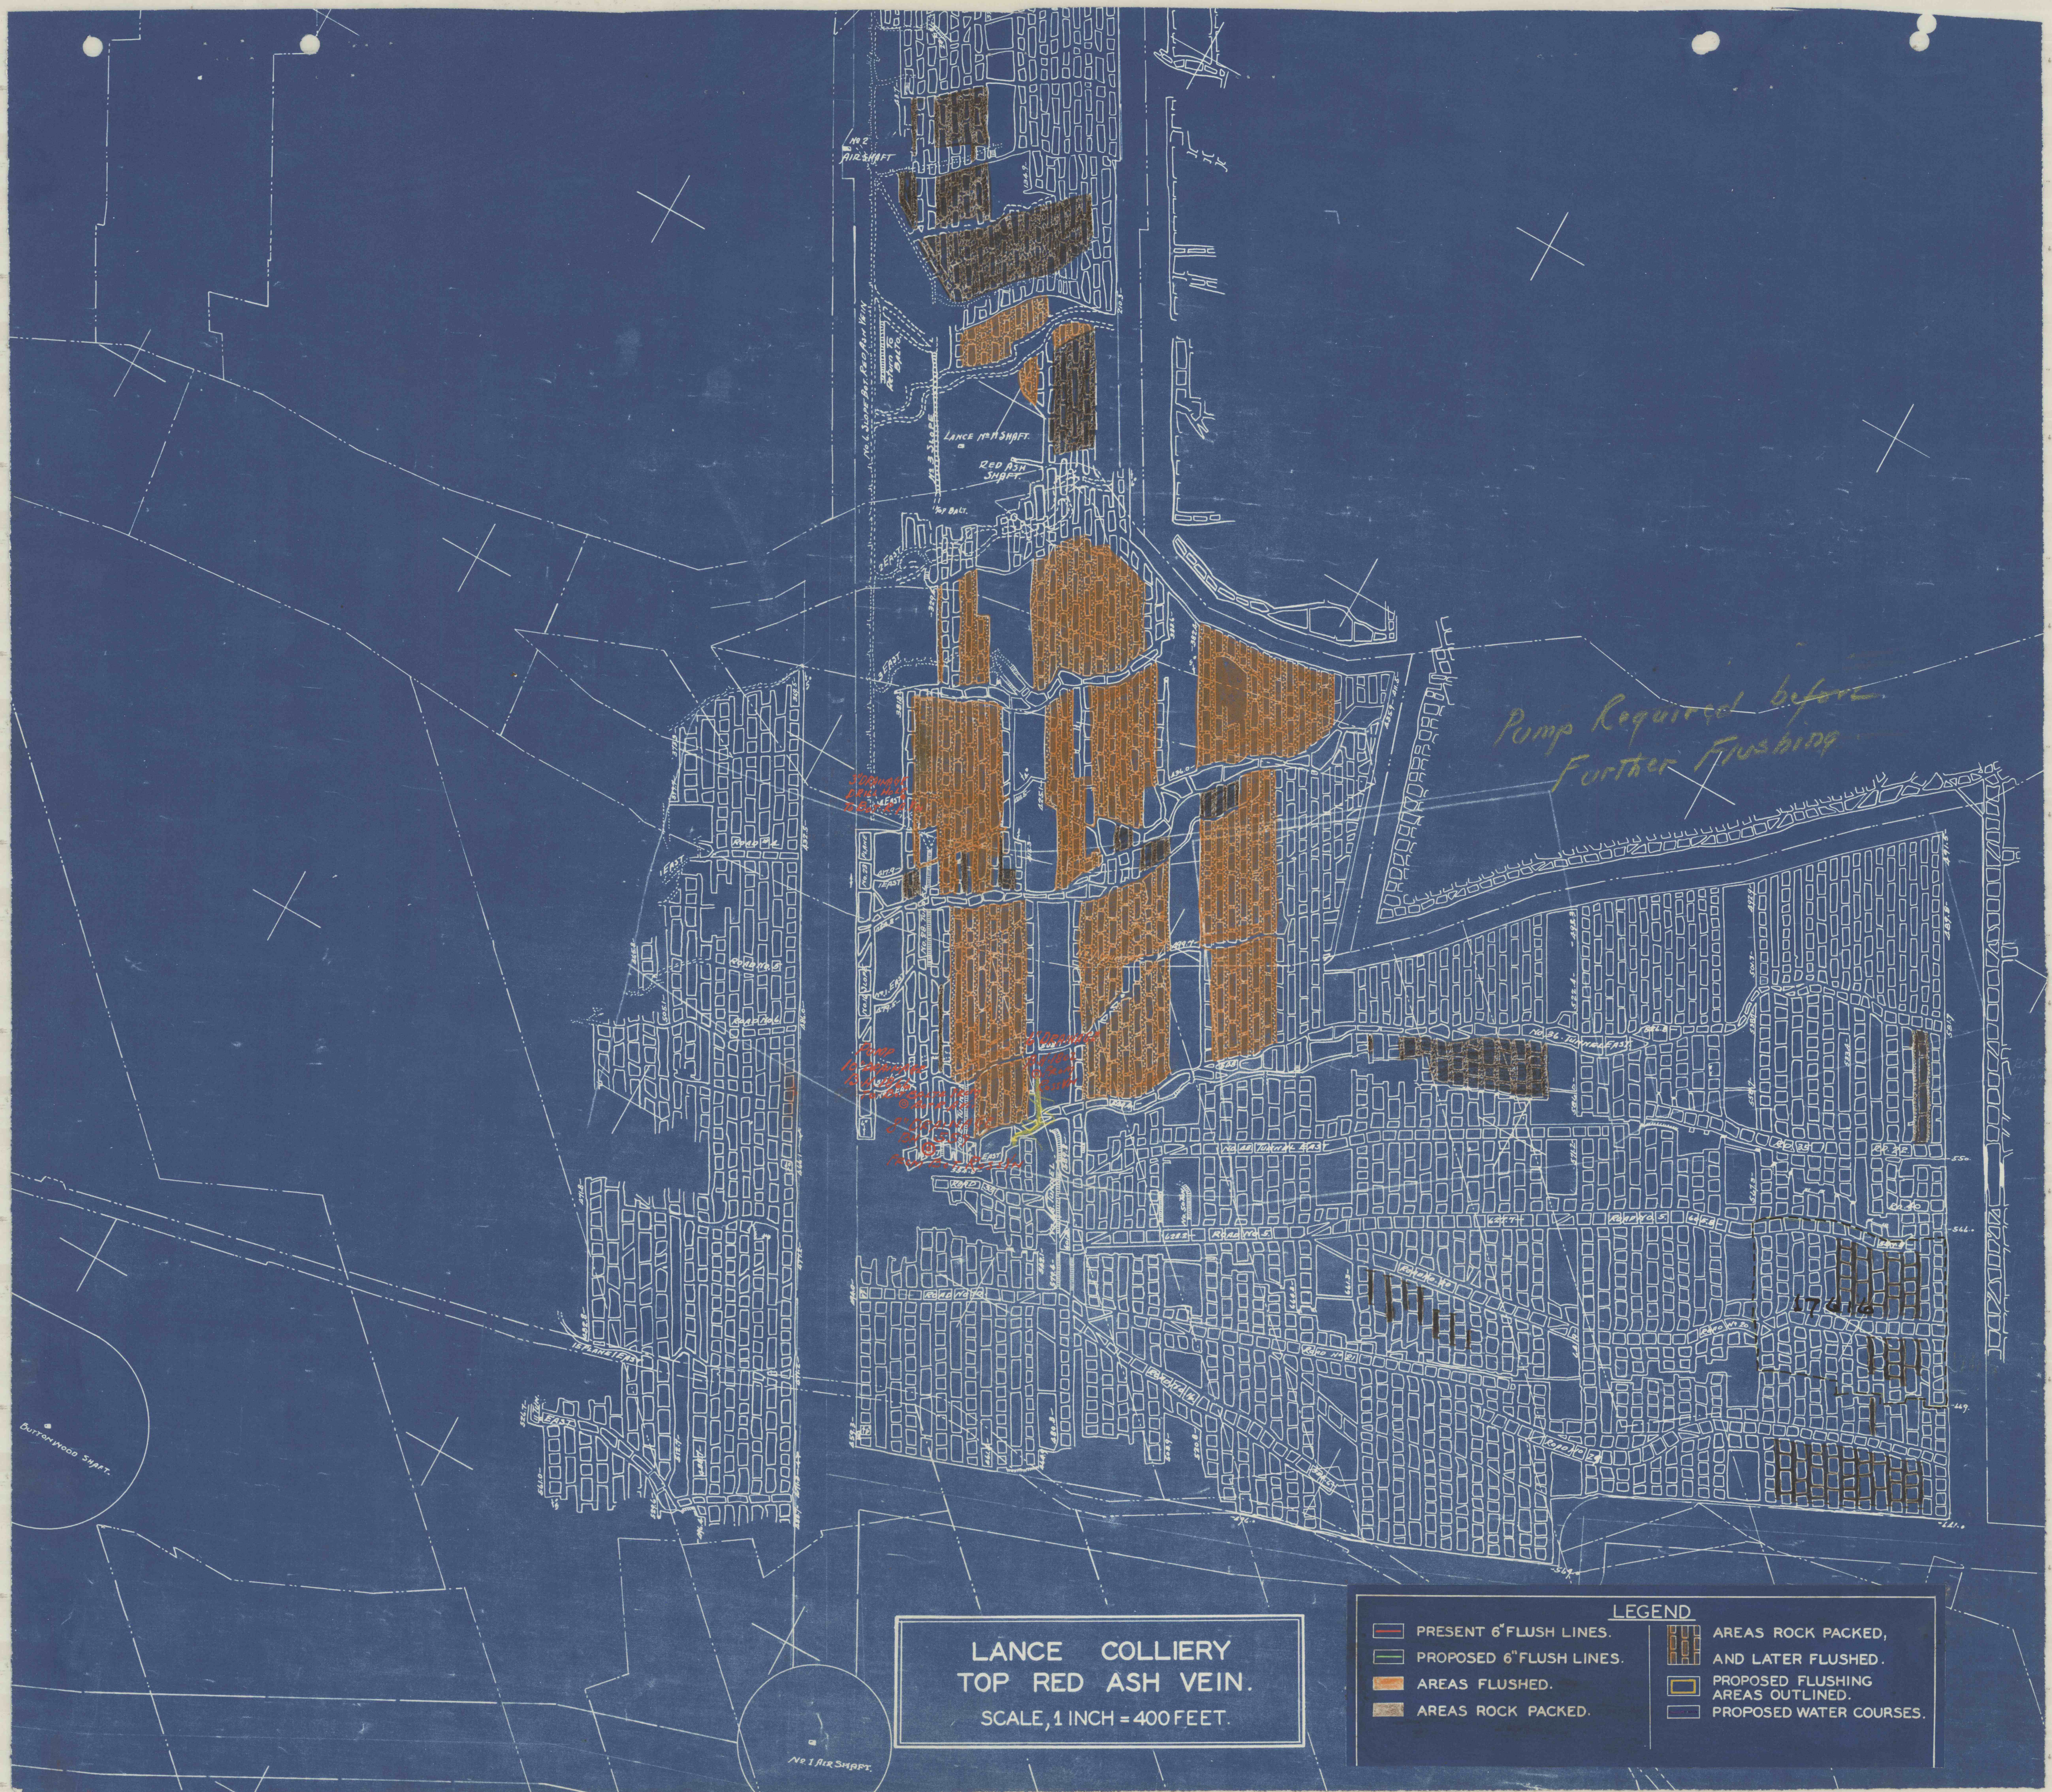

*Pump Required before
Further Flushing*

LANCE COLLIERY
TOP RED ASH VEIN.
SCALE, 1 INCH = 400 FEET.

LEGEND

 PRESENT 6" FLUSH LINES.	 AREAS ROCK PACKED, AND LATER FLUSHED.
 PROPOSED 6" FLUSH LINES.	 PROPOSED FLUSHING AREAS OUTLINED.
 AREAS FLUSHED.	 PROPOSED WATER COURSES.
 AREAS ROCK PACKED.	