


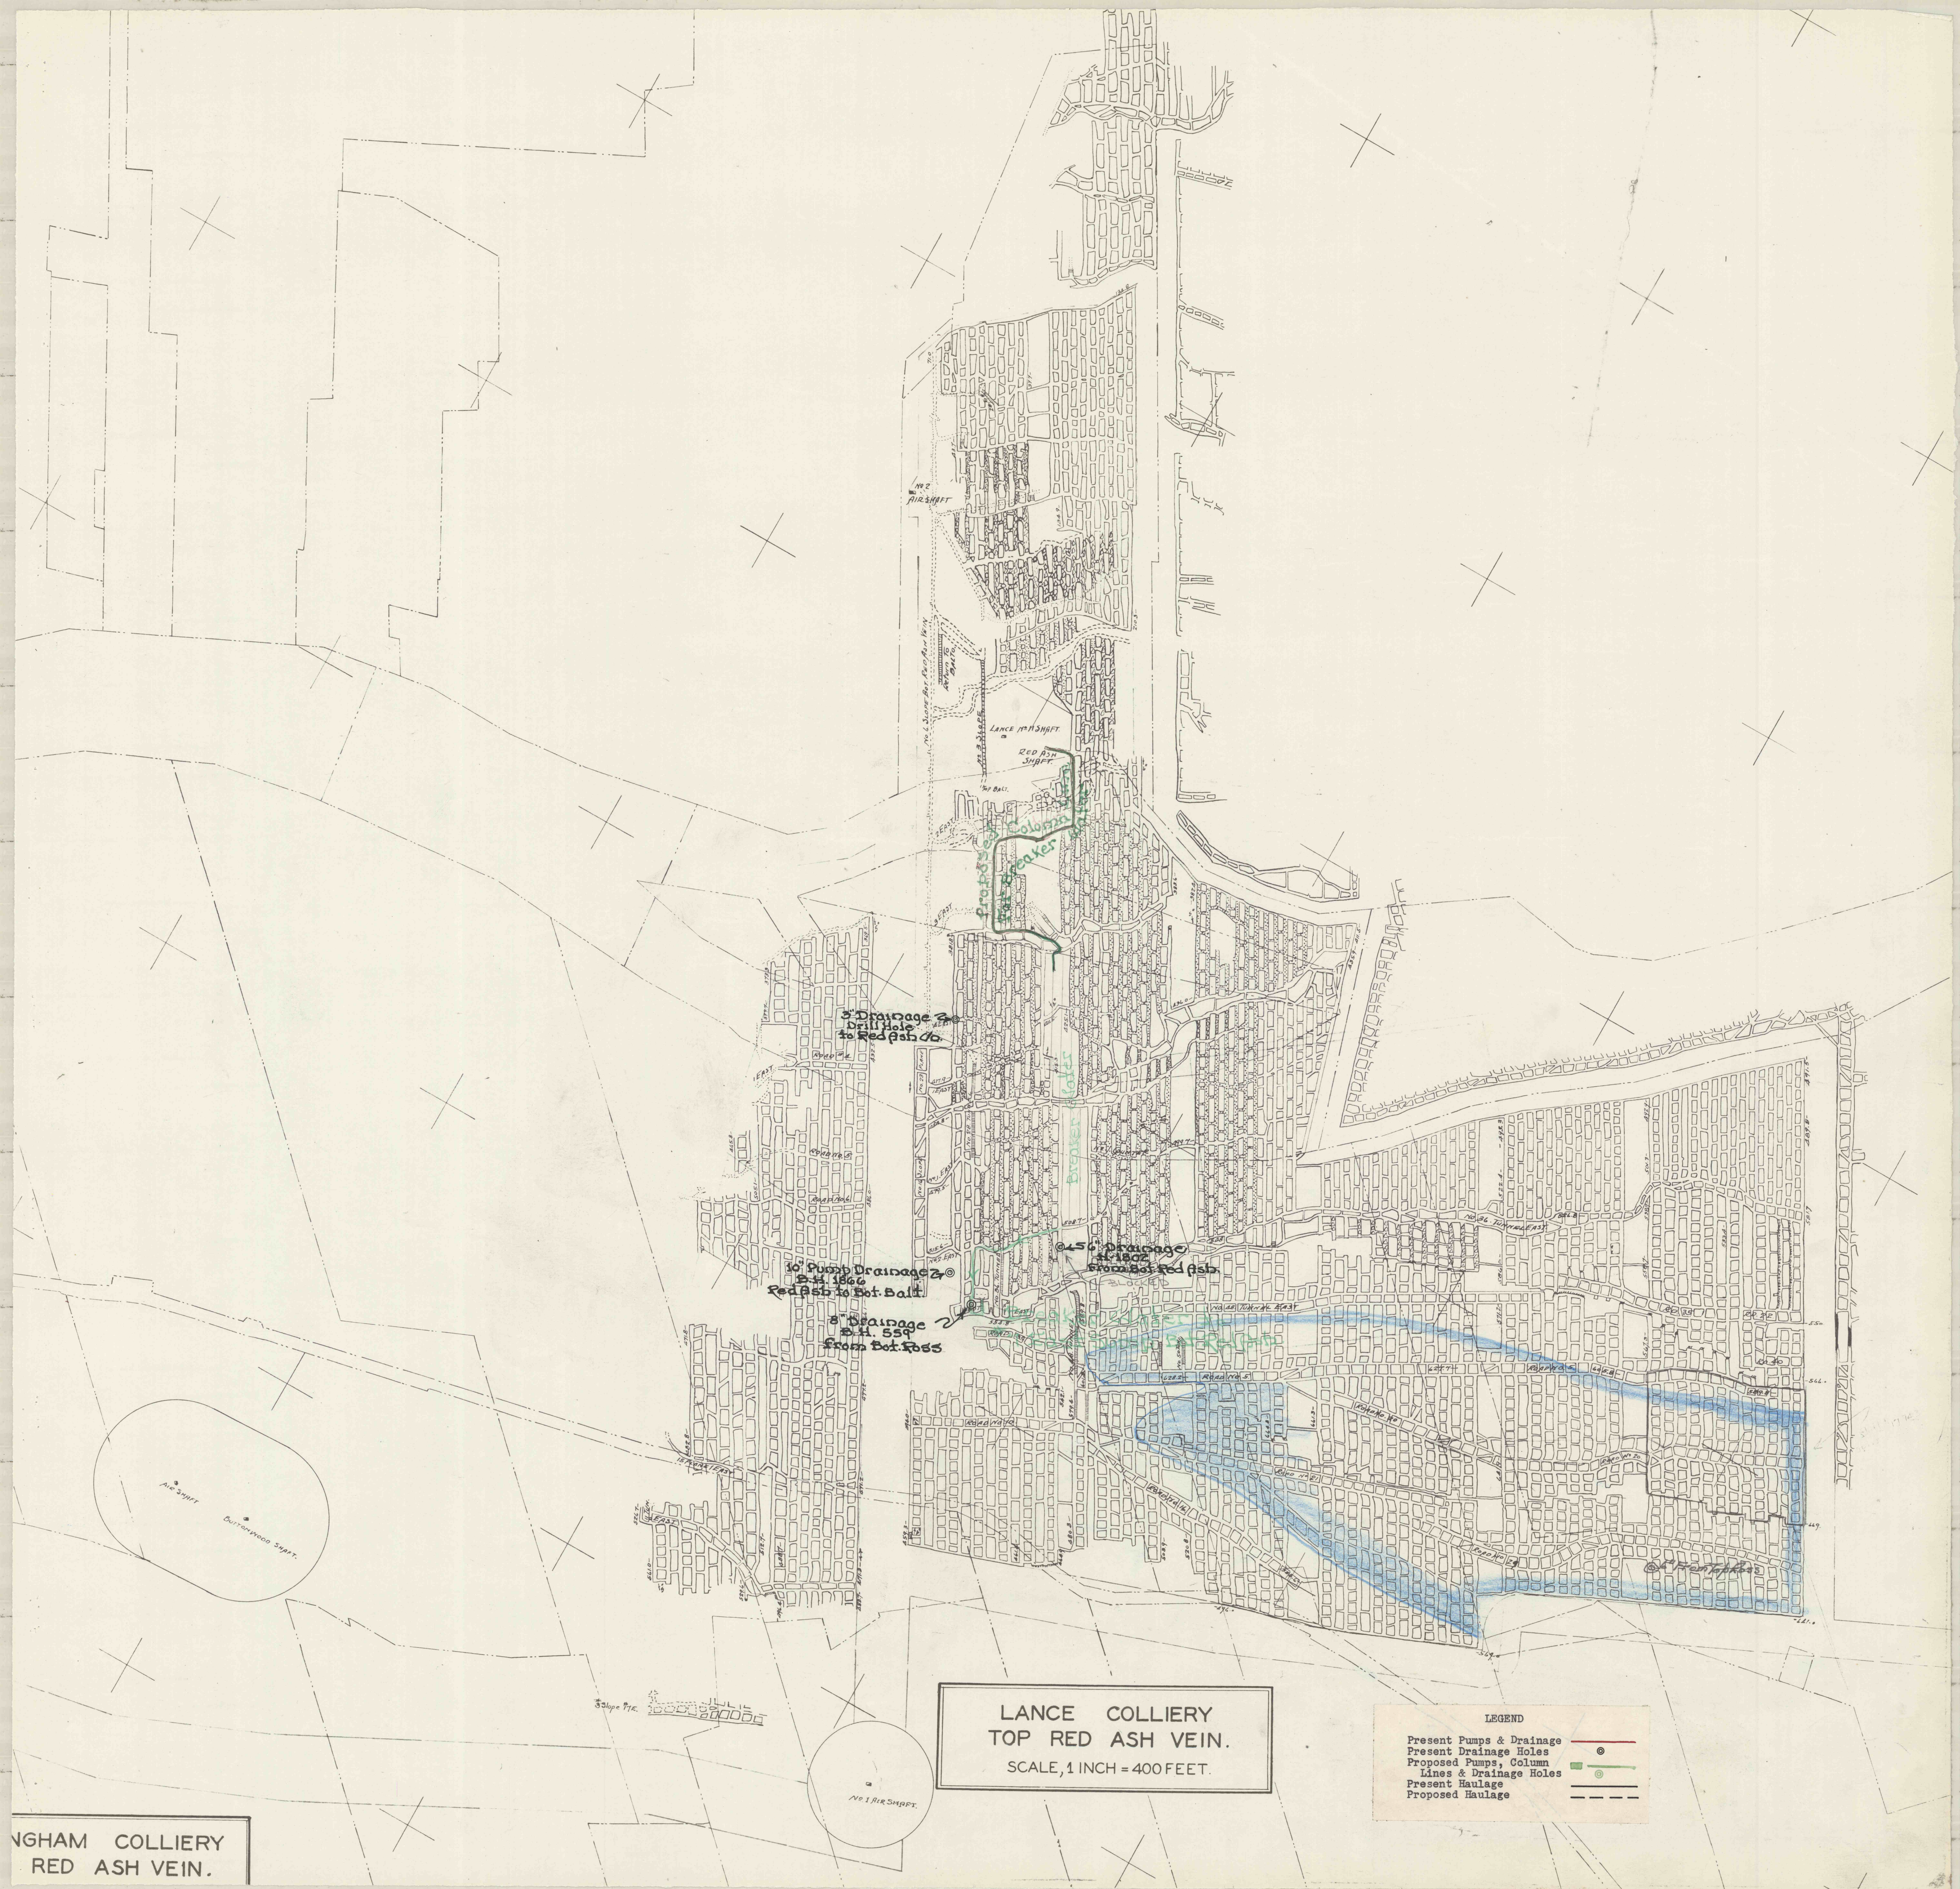

LANCE COLLIERY
TOP RED ASH VEIN.
SCALE, 1 INCH = 400 FEET.

LEGEND

Present Pumps & Drainage	—
Present Drainage Holes	⊙
Proposed Pumps, Column	—
Lines & Drainage Holes	⊙
Present Haulage	—
Proposed Haulage	—

NGHAM COLLIERY
RED ASH VEIN.