


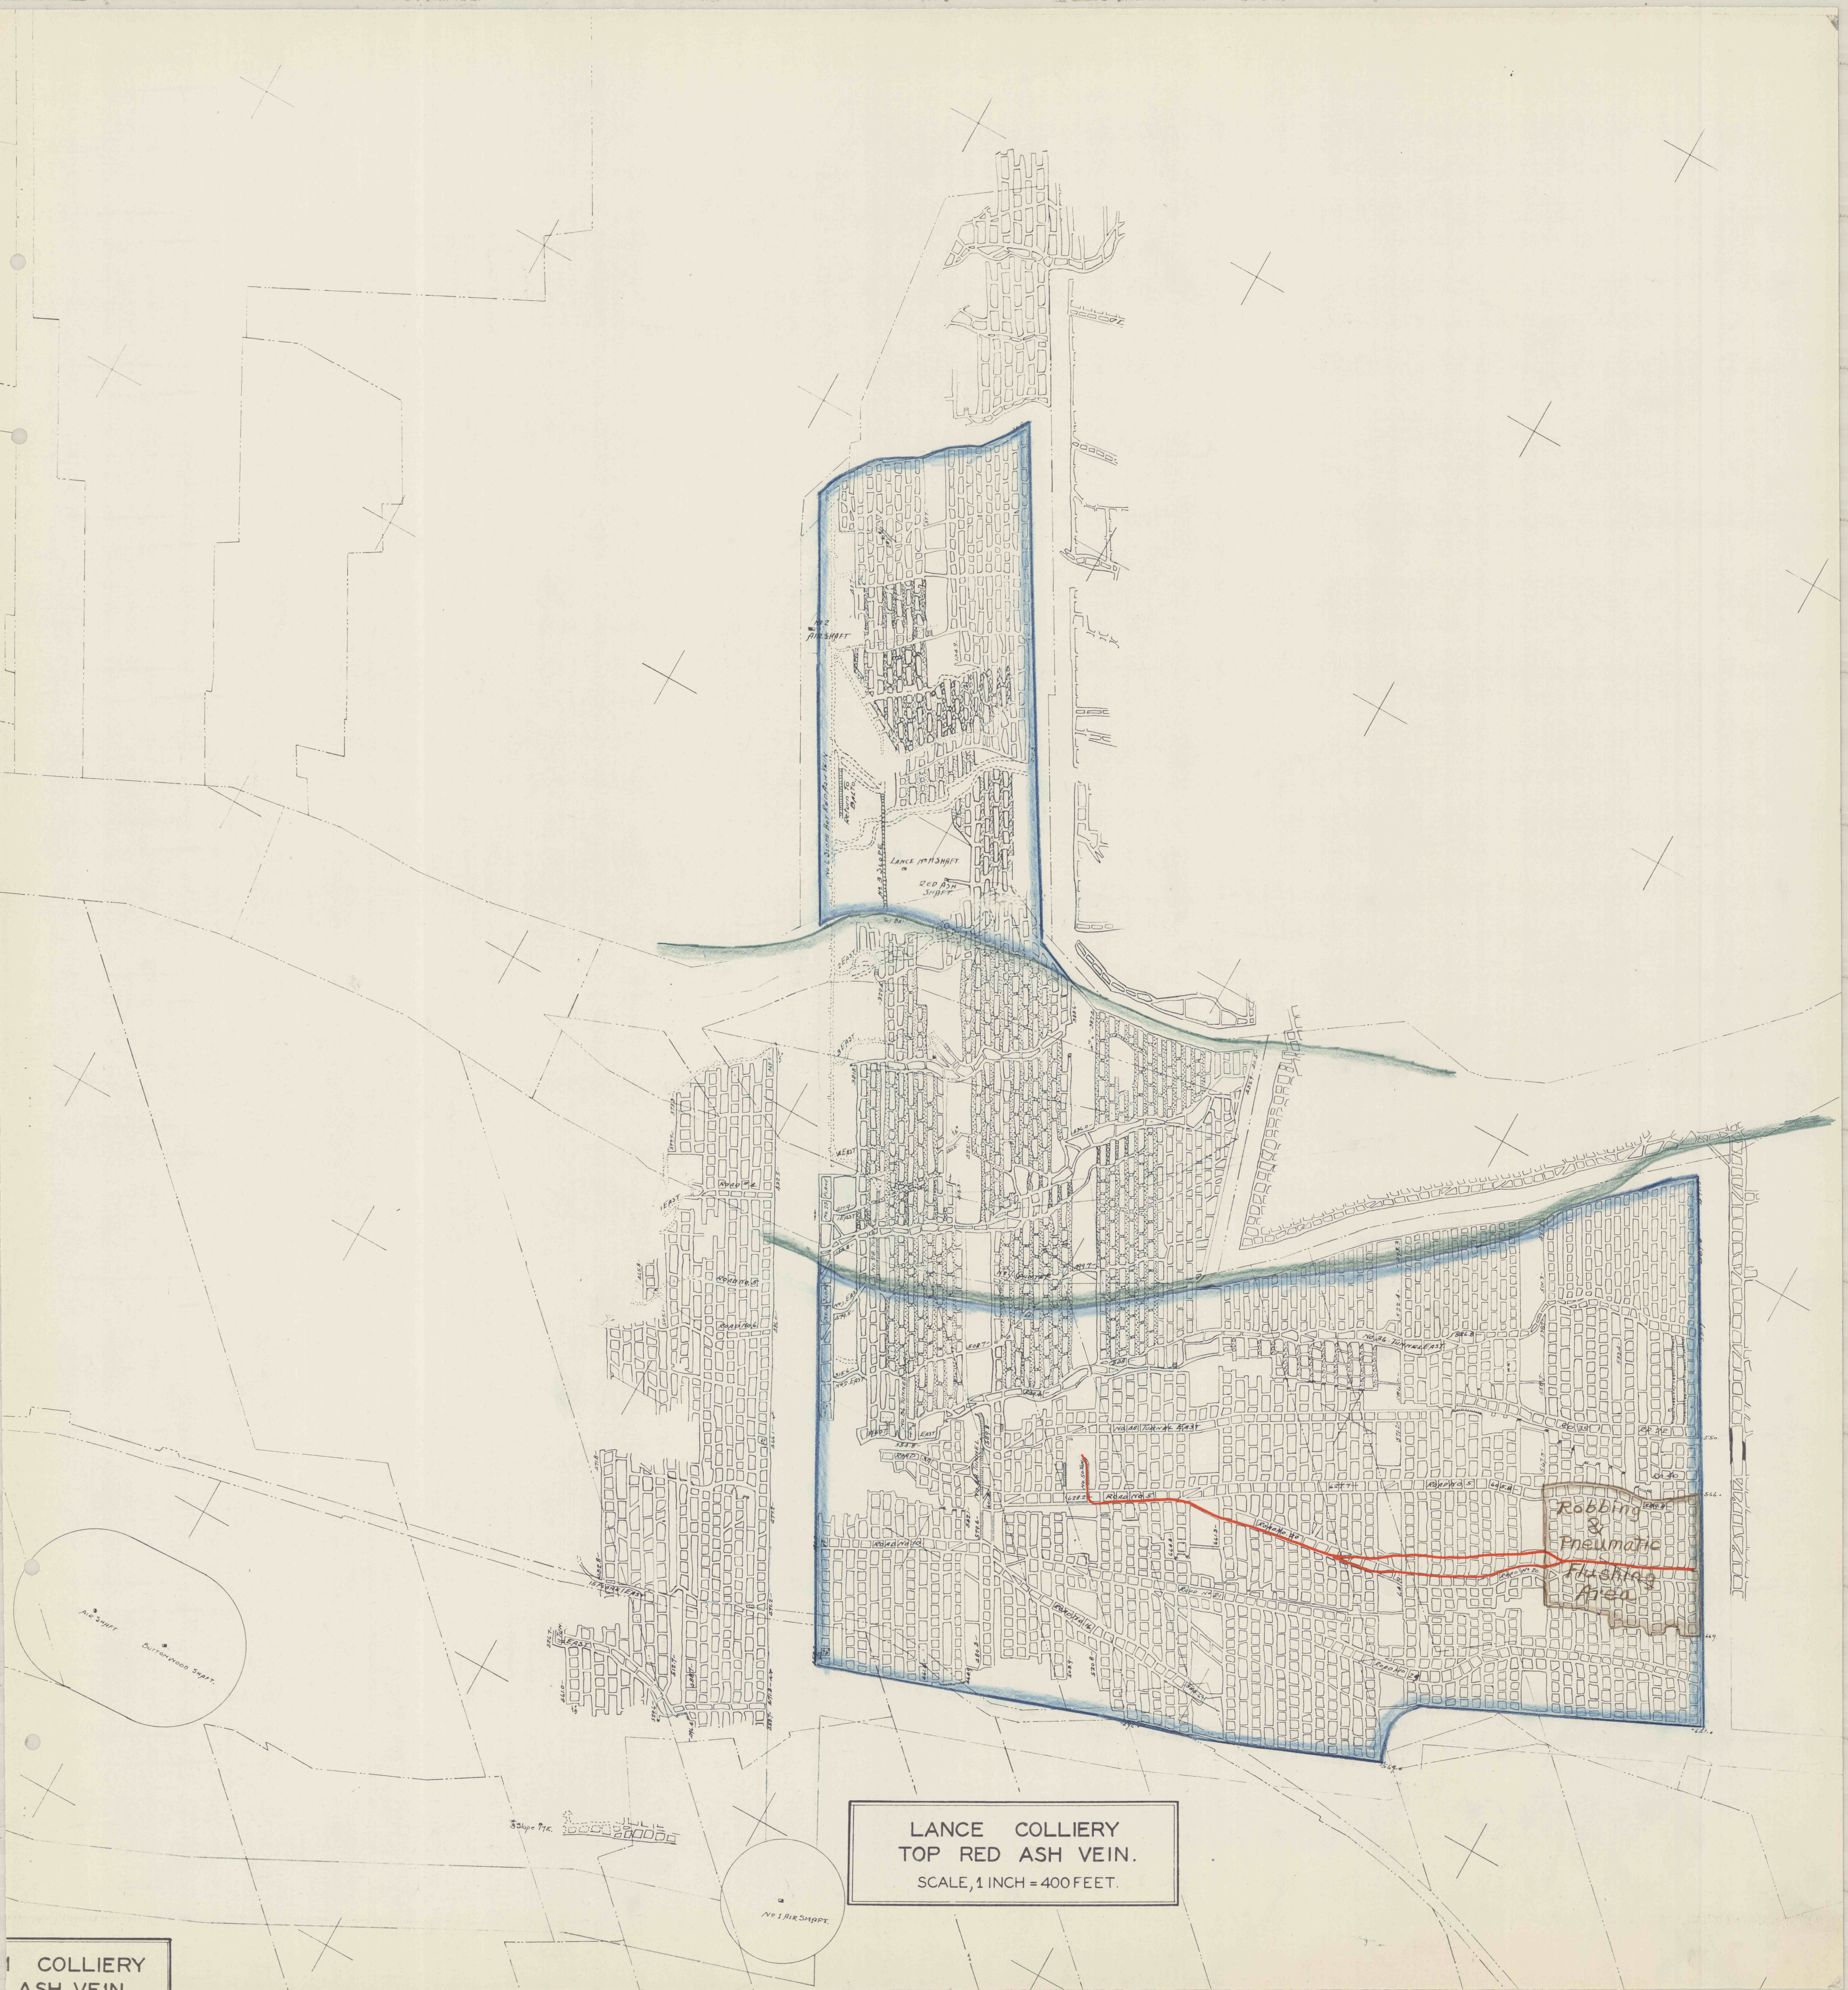

LANCE COLLIERY
TOP RED ASH VEIN.
SCALE, 1 INCH = 400 FEET.

COLLIERY
ASH VEIN