


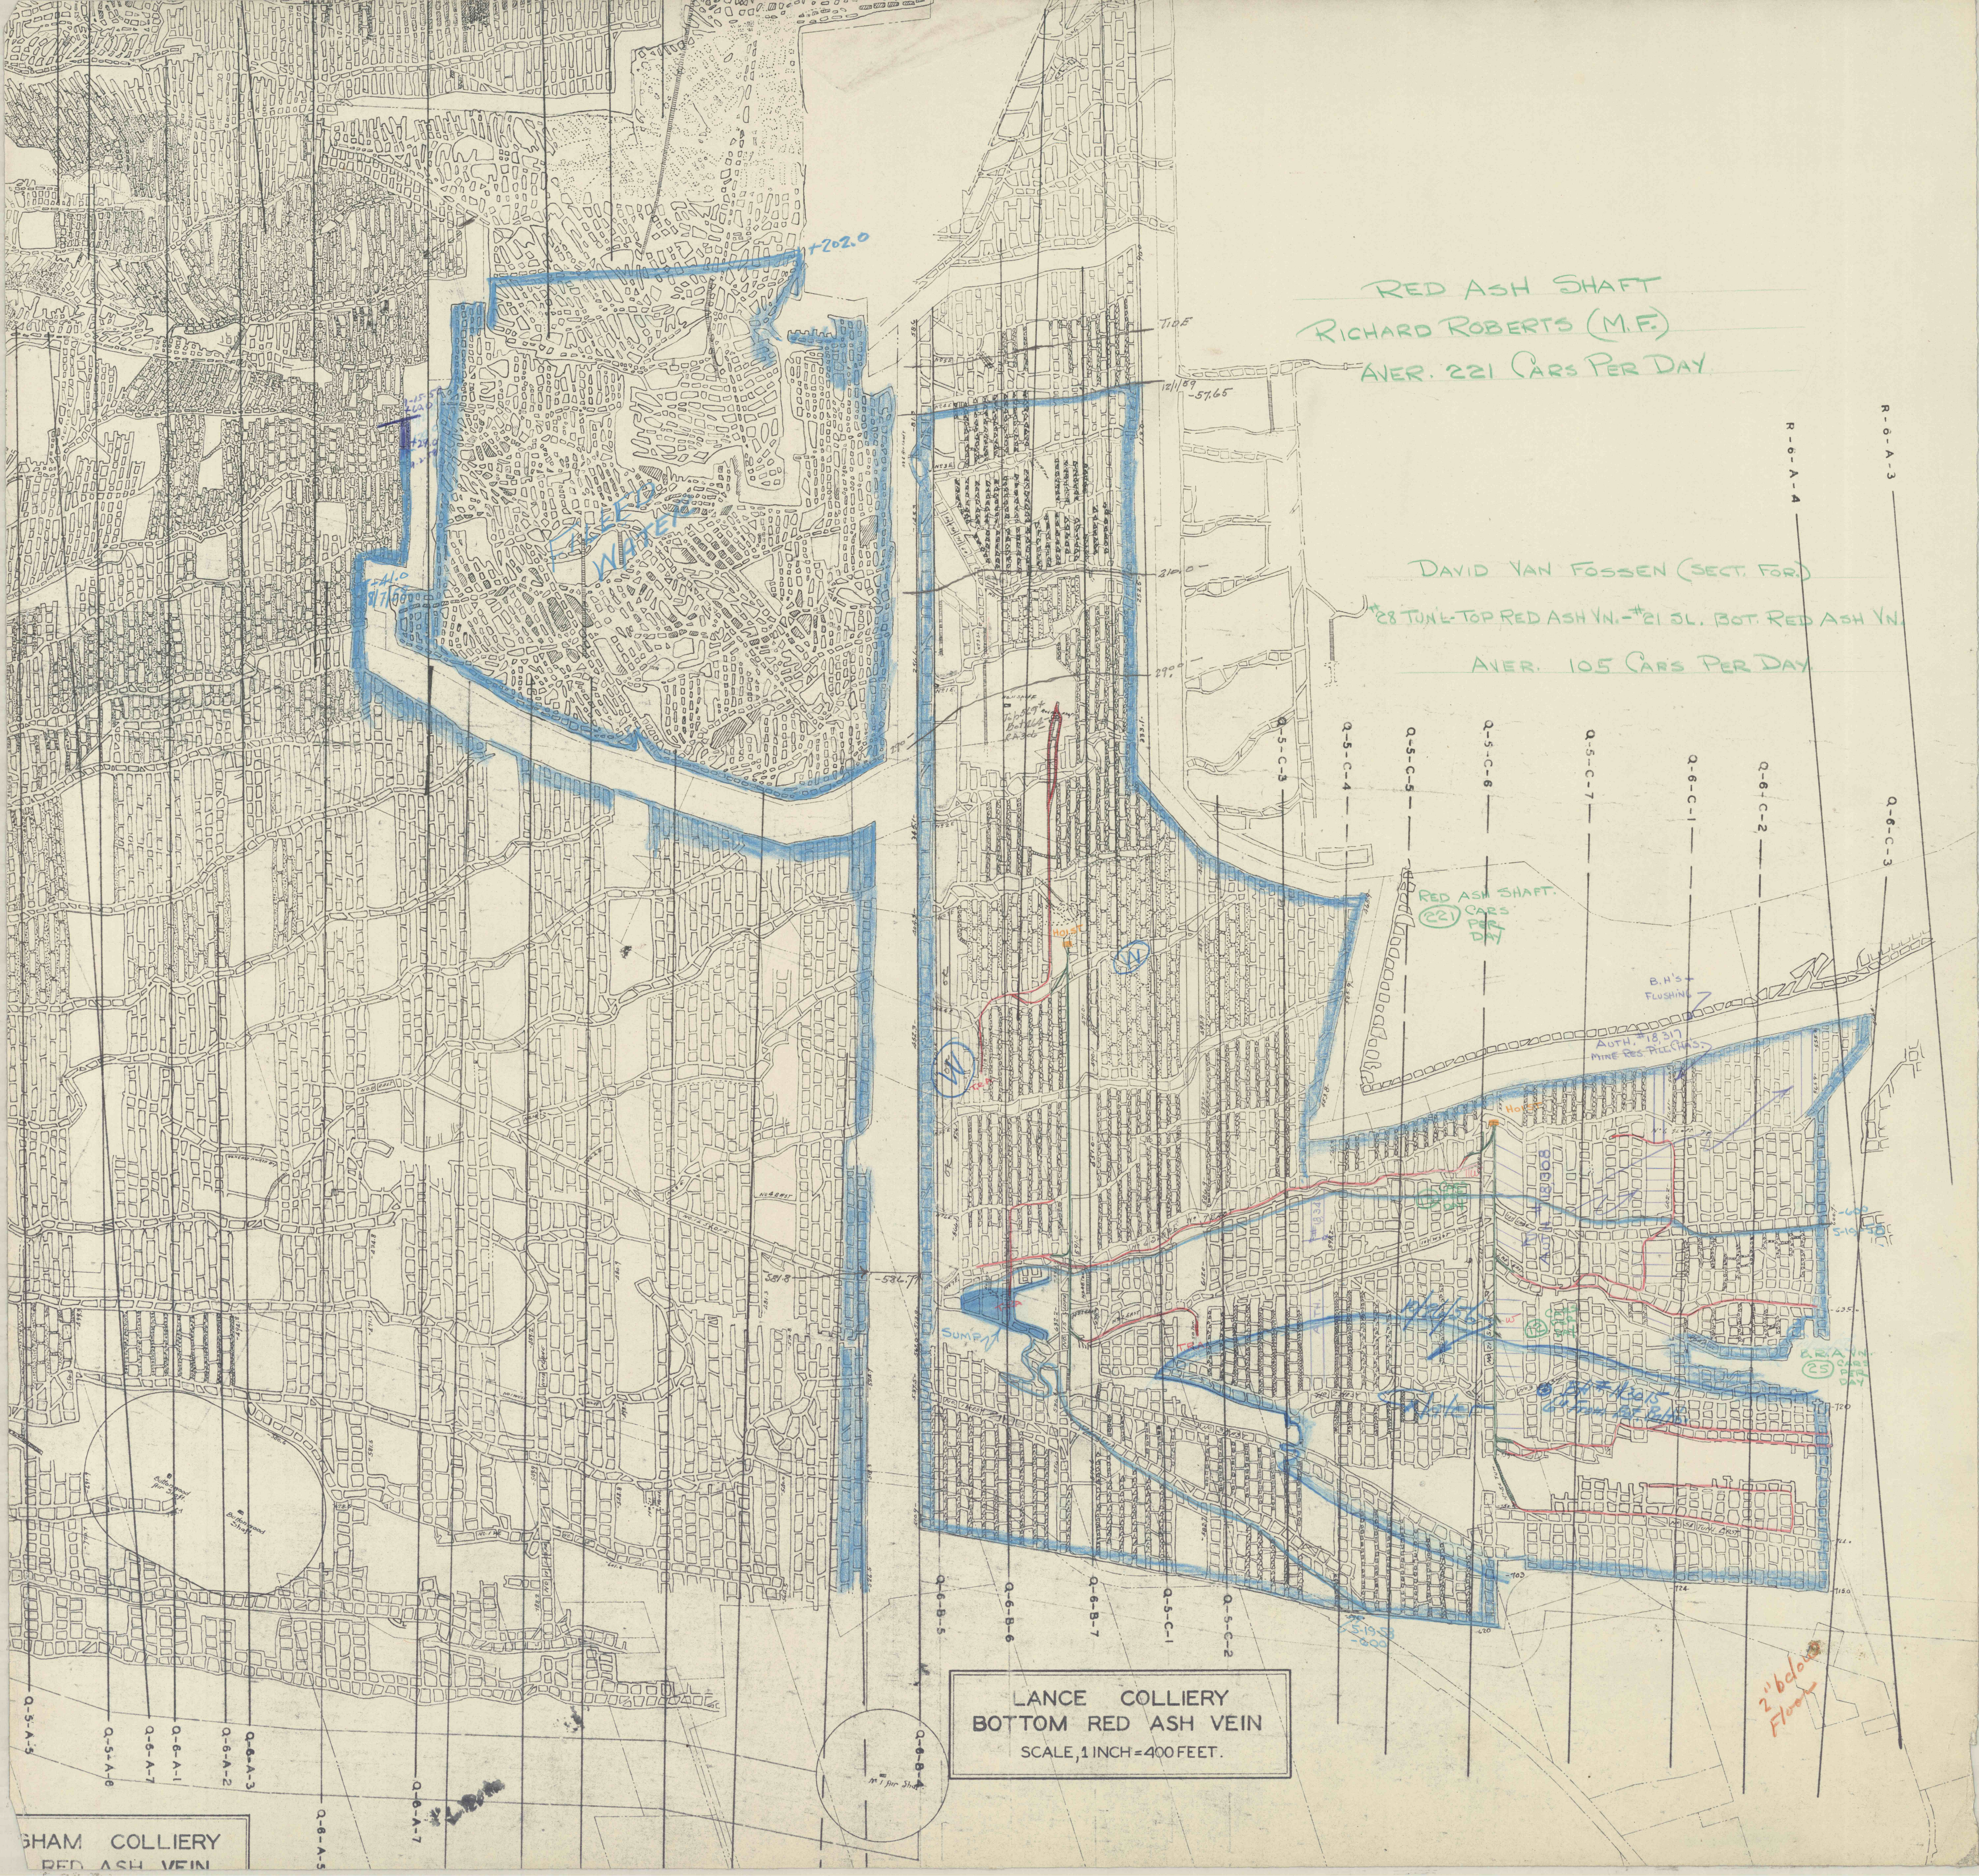

RED ASH SHAFT
RICHARD ROBERTS (M.F.)
AVER. 221 CARS PER DAY

DAVID VAN FOSSEN (SECT. FOR.)
28 TUNL-TOP RED ASH VN.-#21 SL. BOT. RED ASH VN.
AVER. 105 CARS PER DAY

RED ASH SHAFT.
(221) CARS
PER DAY

B.H.'s
FLUSHING
AUTH. 18317
MINE RES. REC. (P.A.S.)

2" below
Floor

LANCE COLLIERY
BOTTOM RED ASH VEIN
SCALE, 1 INCH=400 FEET.

SHAM COLLIERY
RED ASH VEIN