


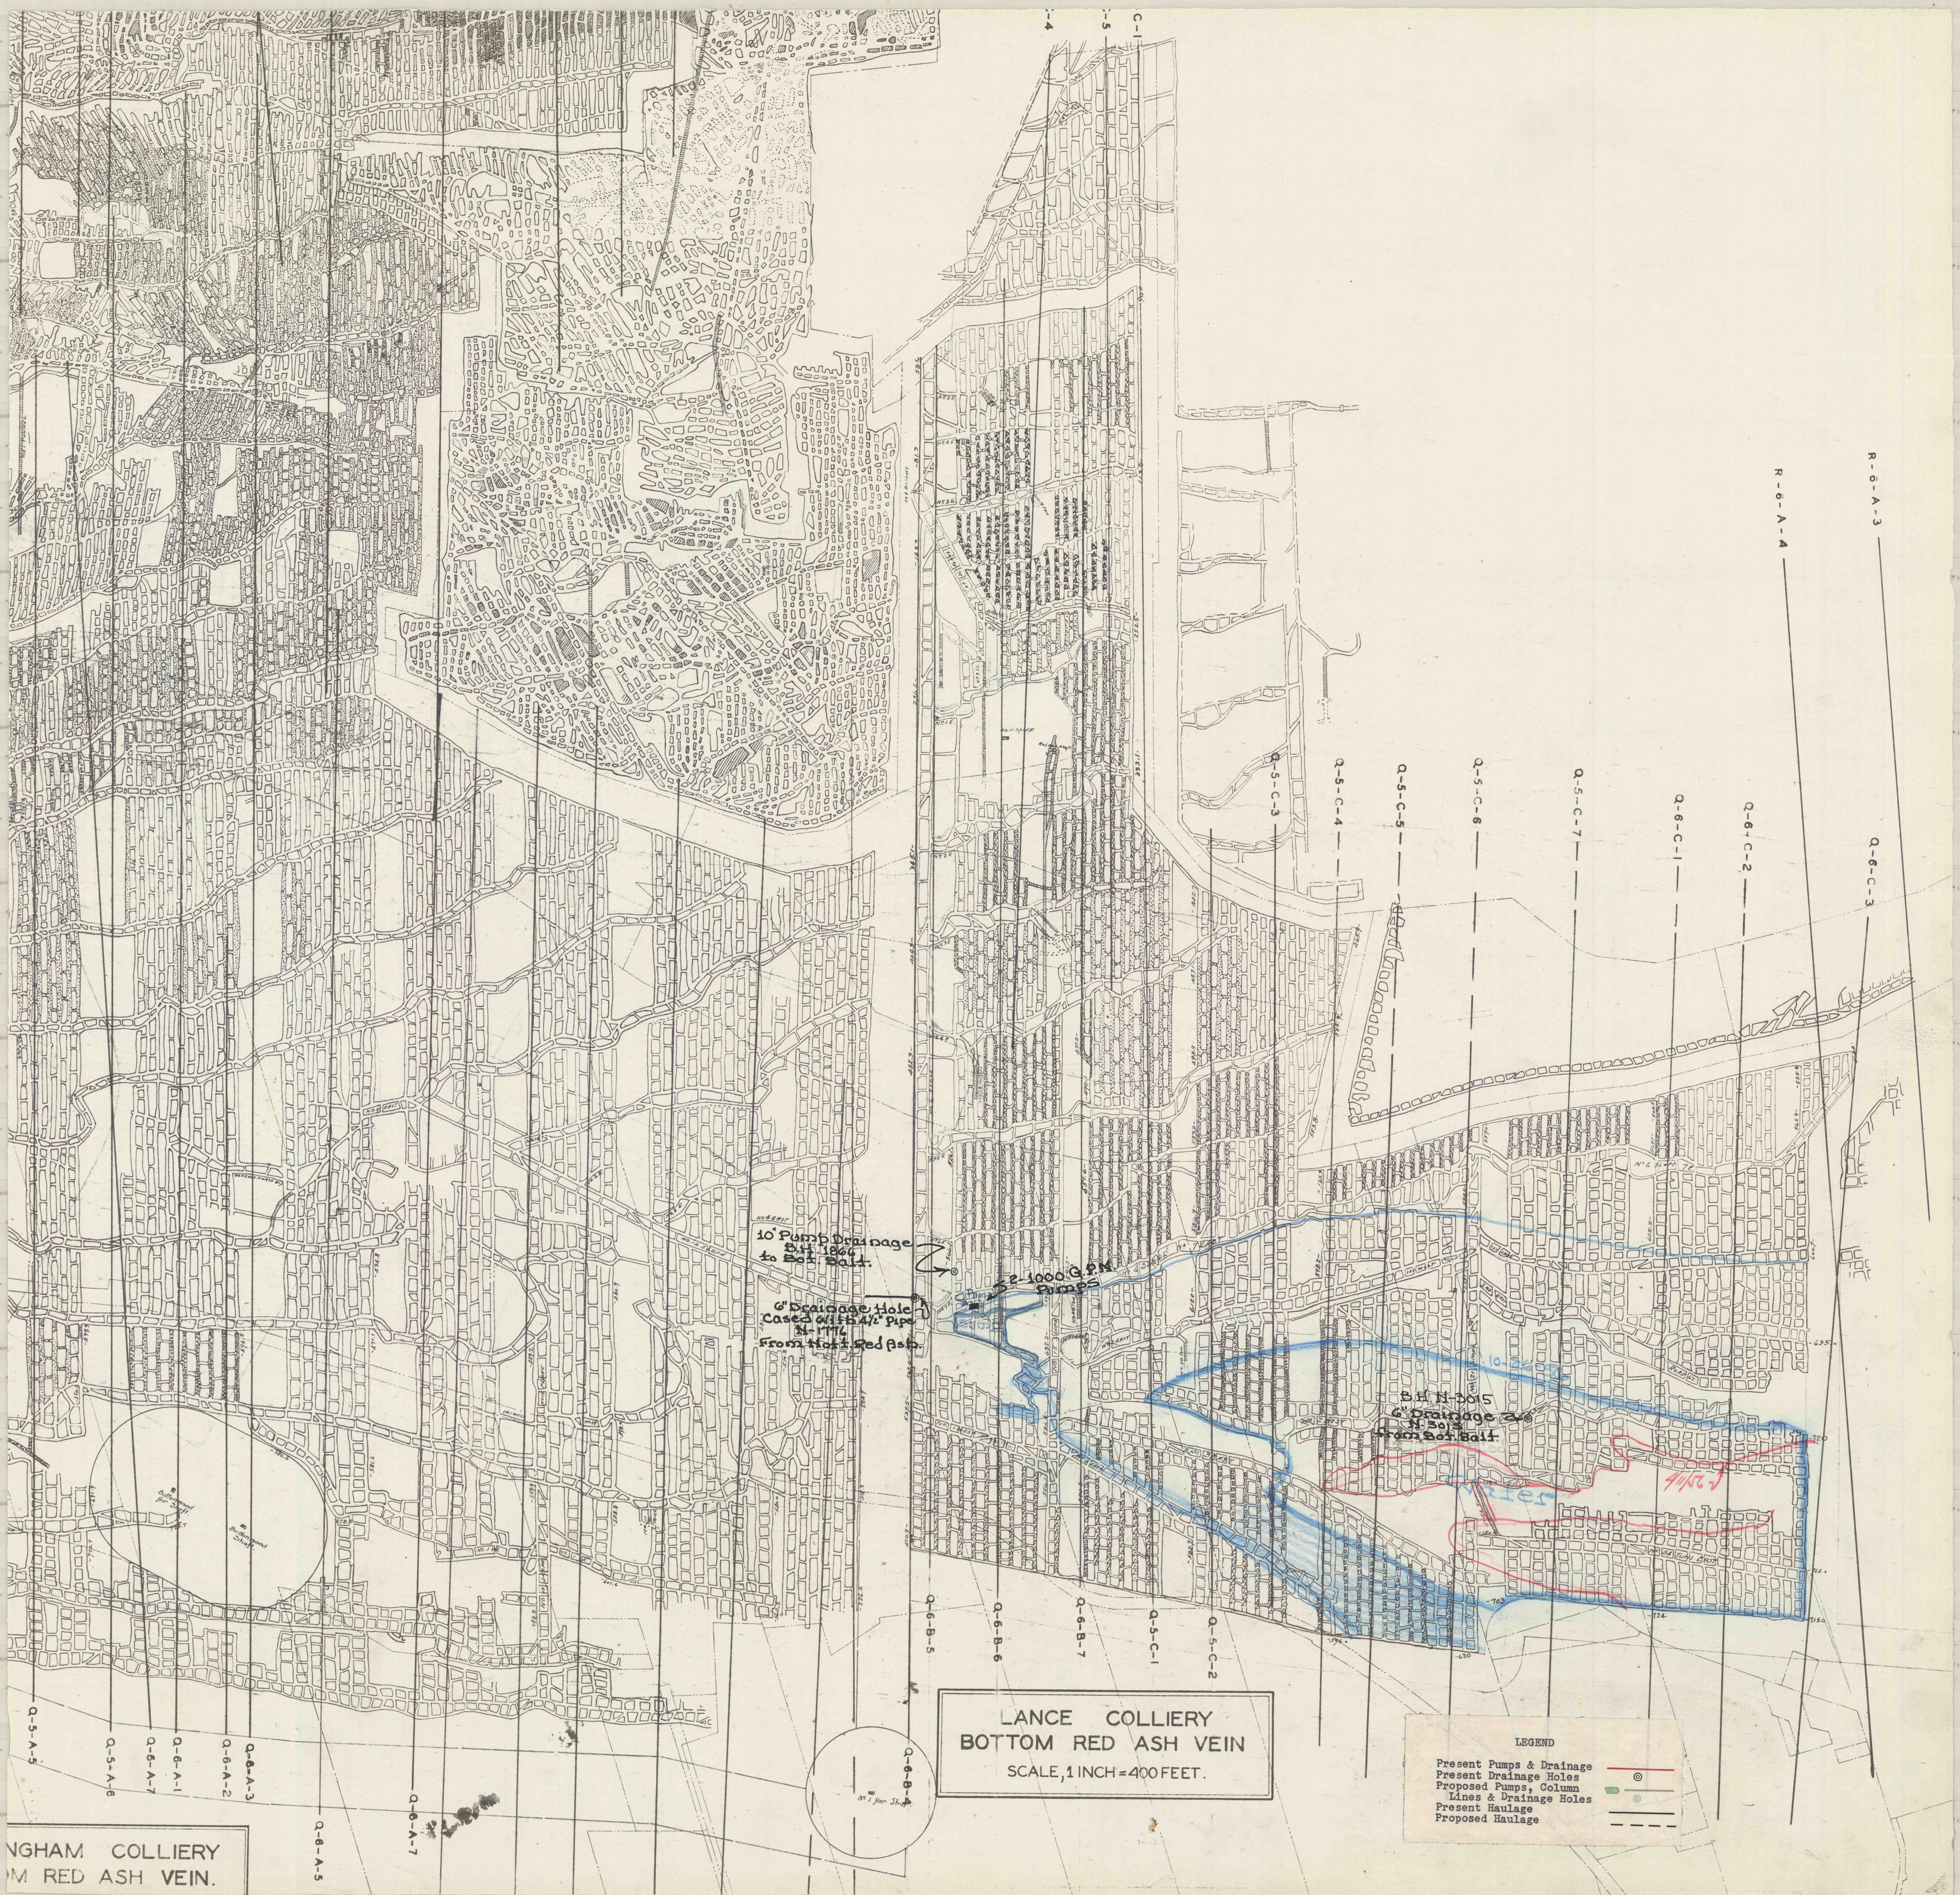

NGHAM COLLIERY
M RED ASH VEIN.

LANCE COLLIERY
BOTTOM RED ASH VEIN
SCALE, 1 INCH = 400 FEET.

LEGEND

Present Pumps & Drainage	—
Present Drainage Holes	⊙
Proposed Pumps, Column	⊙
Lines & Drainage Holes	—
Present Haulage	—
Proposed Haulage	---