# PLYMOUTH SURFACE

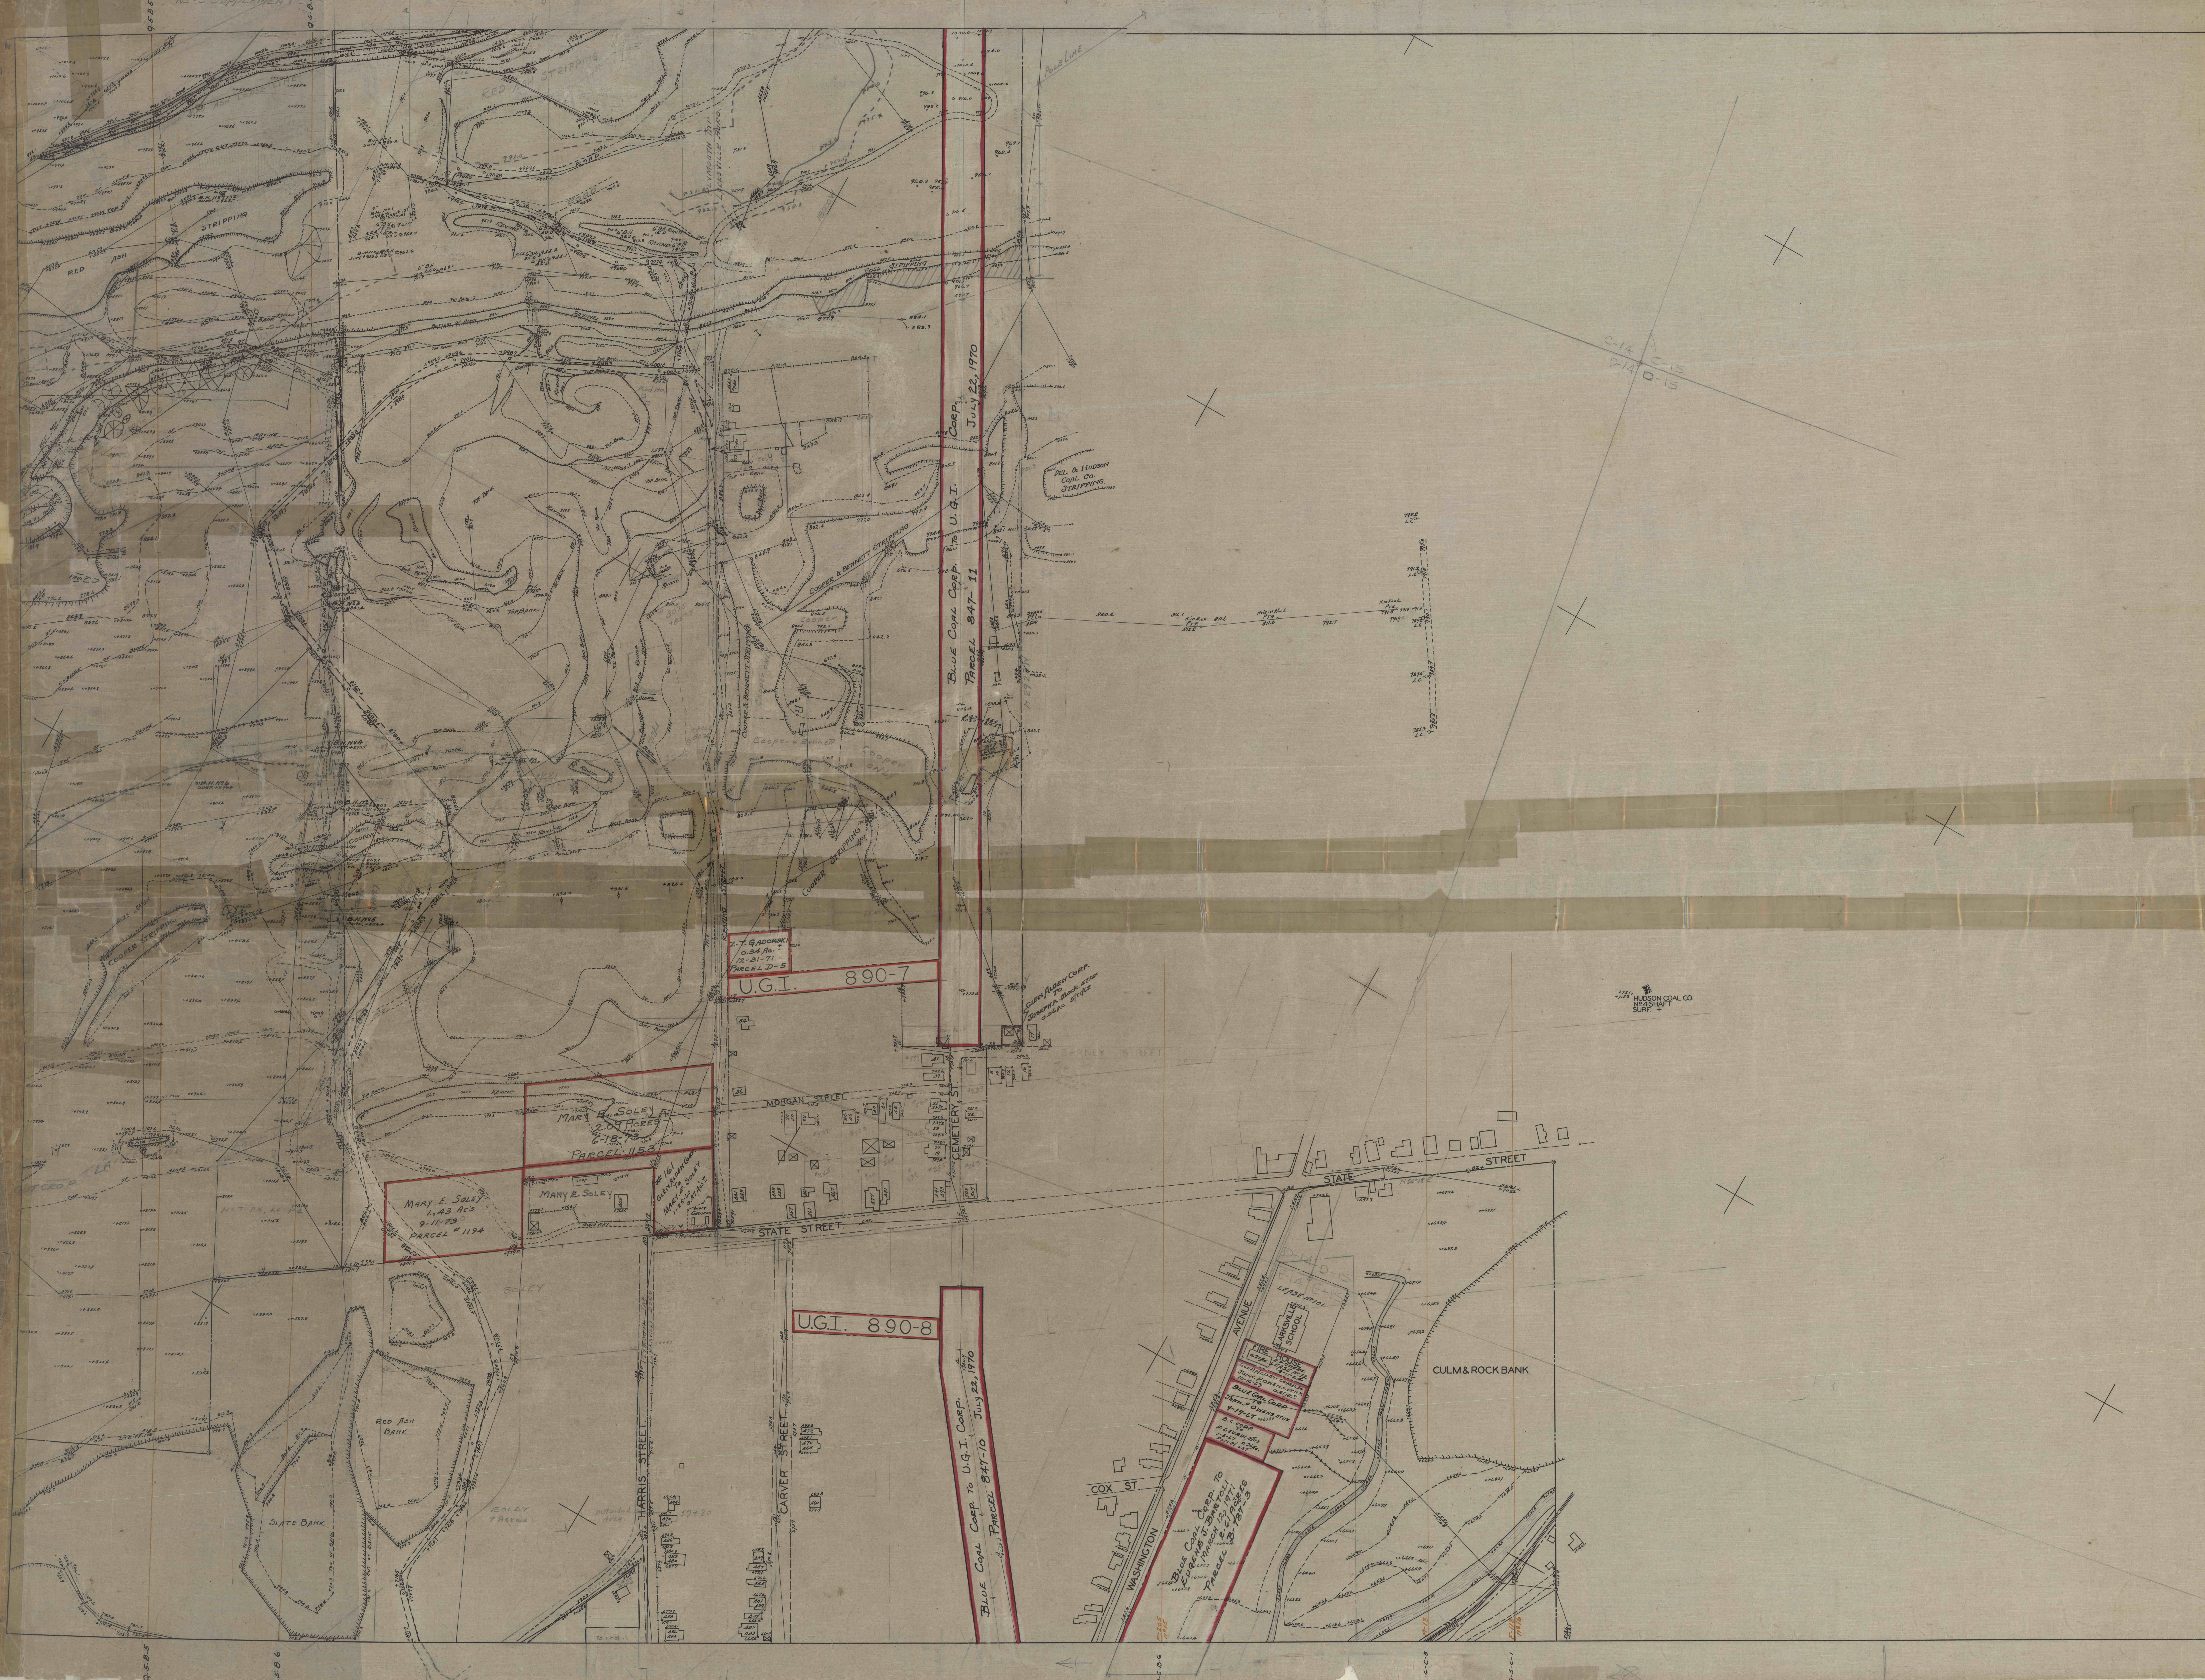

No. 3 SUPPLEMENT
RED ASH LEASE LINE
RED ASH STRIPPING
RED ASH STRIPPING
CUT
TOP OF SLOPE
BOTT.
RAVINE
TOP OF BANK
BOTTOM OF BANK
ROAD
PLYMOUTH TWP.
LARKSVILLE BORO.
B.H. No 1
B.H. No 2
B.H. No 3
B.H. No 4
B.H. No 5
B.H. No 6
ROSS STRIPPING
POLE LINE
DEL. & HUDSON COAL CO. STRIPPING
COOPER & BENNETT STRIPPING
Cooper & Bennett
Cooper only
COOPER STRIPPING
FAULT
CHANGE OF SLOPE
OUTCROP
FIVE FOOT
NOT BK. 44 P4
C-14
C-15
D-14
D-15
E-14
E-15
BLUE COAL CORP. TO U.G.I. CORP. JULY 22, 1970 PARCEL 847-11
Z.T. GADOMSKI 0.34 Ac.± 12-31-71 PARCEL D-5
U.G.I. 890-7
GLEN ALDEN CORP. TO JOSEPH A. MOCK. ET UX 0.21 Ac. 5/11/62
BARNEY STREET
KEATING STREET
MORGAN STREET
CEMETERY ST.
STATE STREET
MARY E. SOLEY 2.09 ACRES 6-18-73 PARCEL 1153
MARY E. SOLEY 1.43 Ac's 9-11-73 PARCEL # 1194
MARY E. SOLEY
#161 GLEN ALDEN CORP. TO MARY E. SOLEY 1-26-60 0.87 Ac's ±
QUOIT GROUNDS
ROADWAY
SOLEY
SOLEY 9 Acres
Disturbed Area
RED ASH BANK
SLATE BANK
STRIPPING
EDGE
TOP OF BANK
BOT. OF BANK
HARRIS STREET
CARVER STREET
57+80
Bird
U.G.I. 890-8
BLUE COAL CORP TO U.G.I. CORP. JULY 22, 1970 PARCEL 847-10
HUDSON COAL CO. No 4 SHAFT SURF.
N 54° 18' E
LEASE No 101
LARKSVILLE SCHOOL
FIRE HOUSE 0.21 Ac.
GLEN ALDEN CORP. TO JOHN P. OWENS ET UX 10-16-63 0.21 Ac.
BLUE COAL CORP. TO JOHN P. OWENS ET UX 9-19-67
B. C. CORP. TO F. GEURIN ET UX 1-5-67 0.24 Ac. Parcel 637
BLUE COAL CORP. TO EUGENE J. BARTOLI MARCH 12, 1971 2.61 ACRES PARCEL B-187-3
WASHINGTON AVENUE
COX ST
CULM & ROCK BANK
F-205 No 15
M-18
F-118 No 16
Q.5.B.5
5.B.6
6-B-6
6-C-5
5-C-1

PLYMOUTH SURFACE