


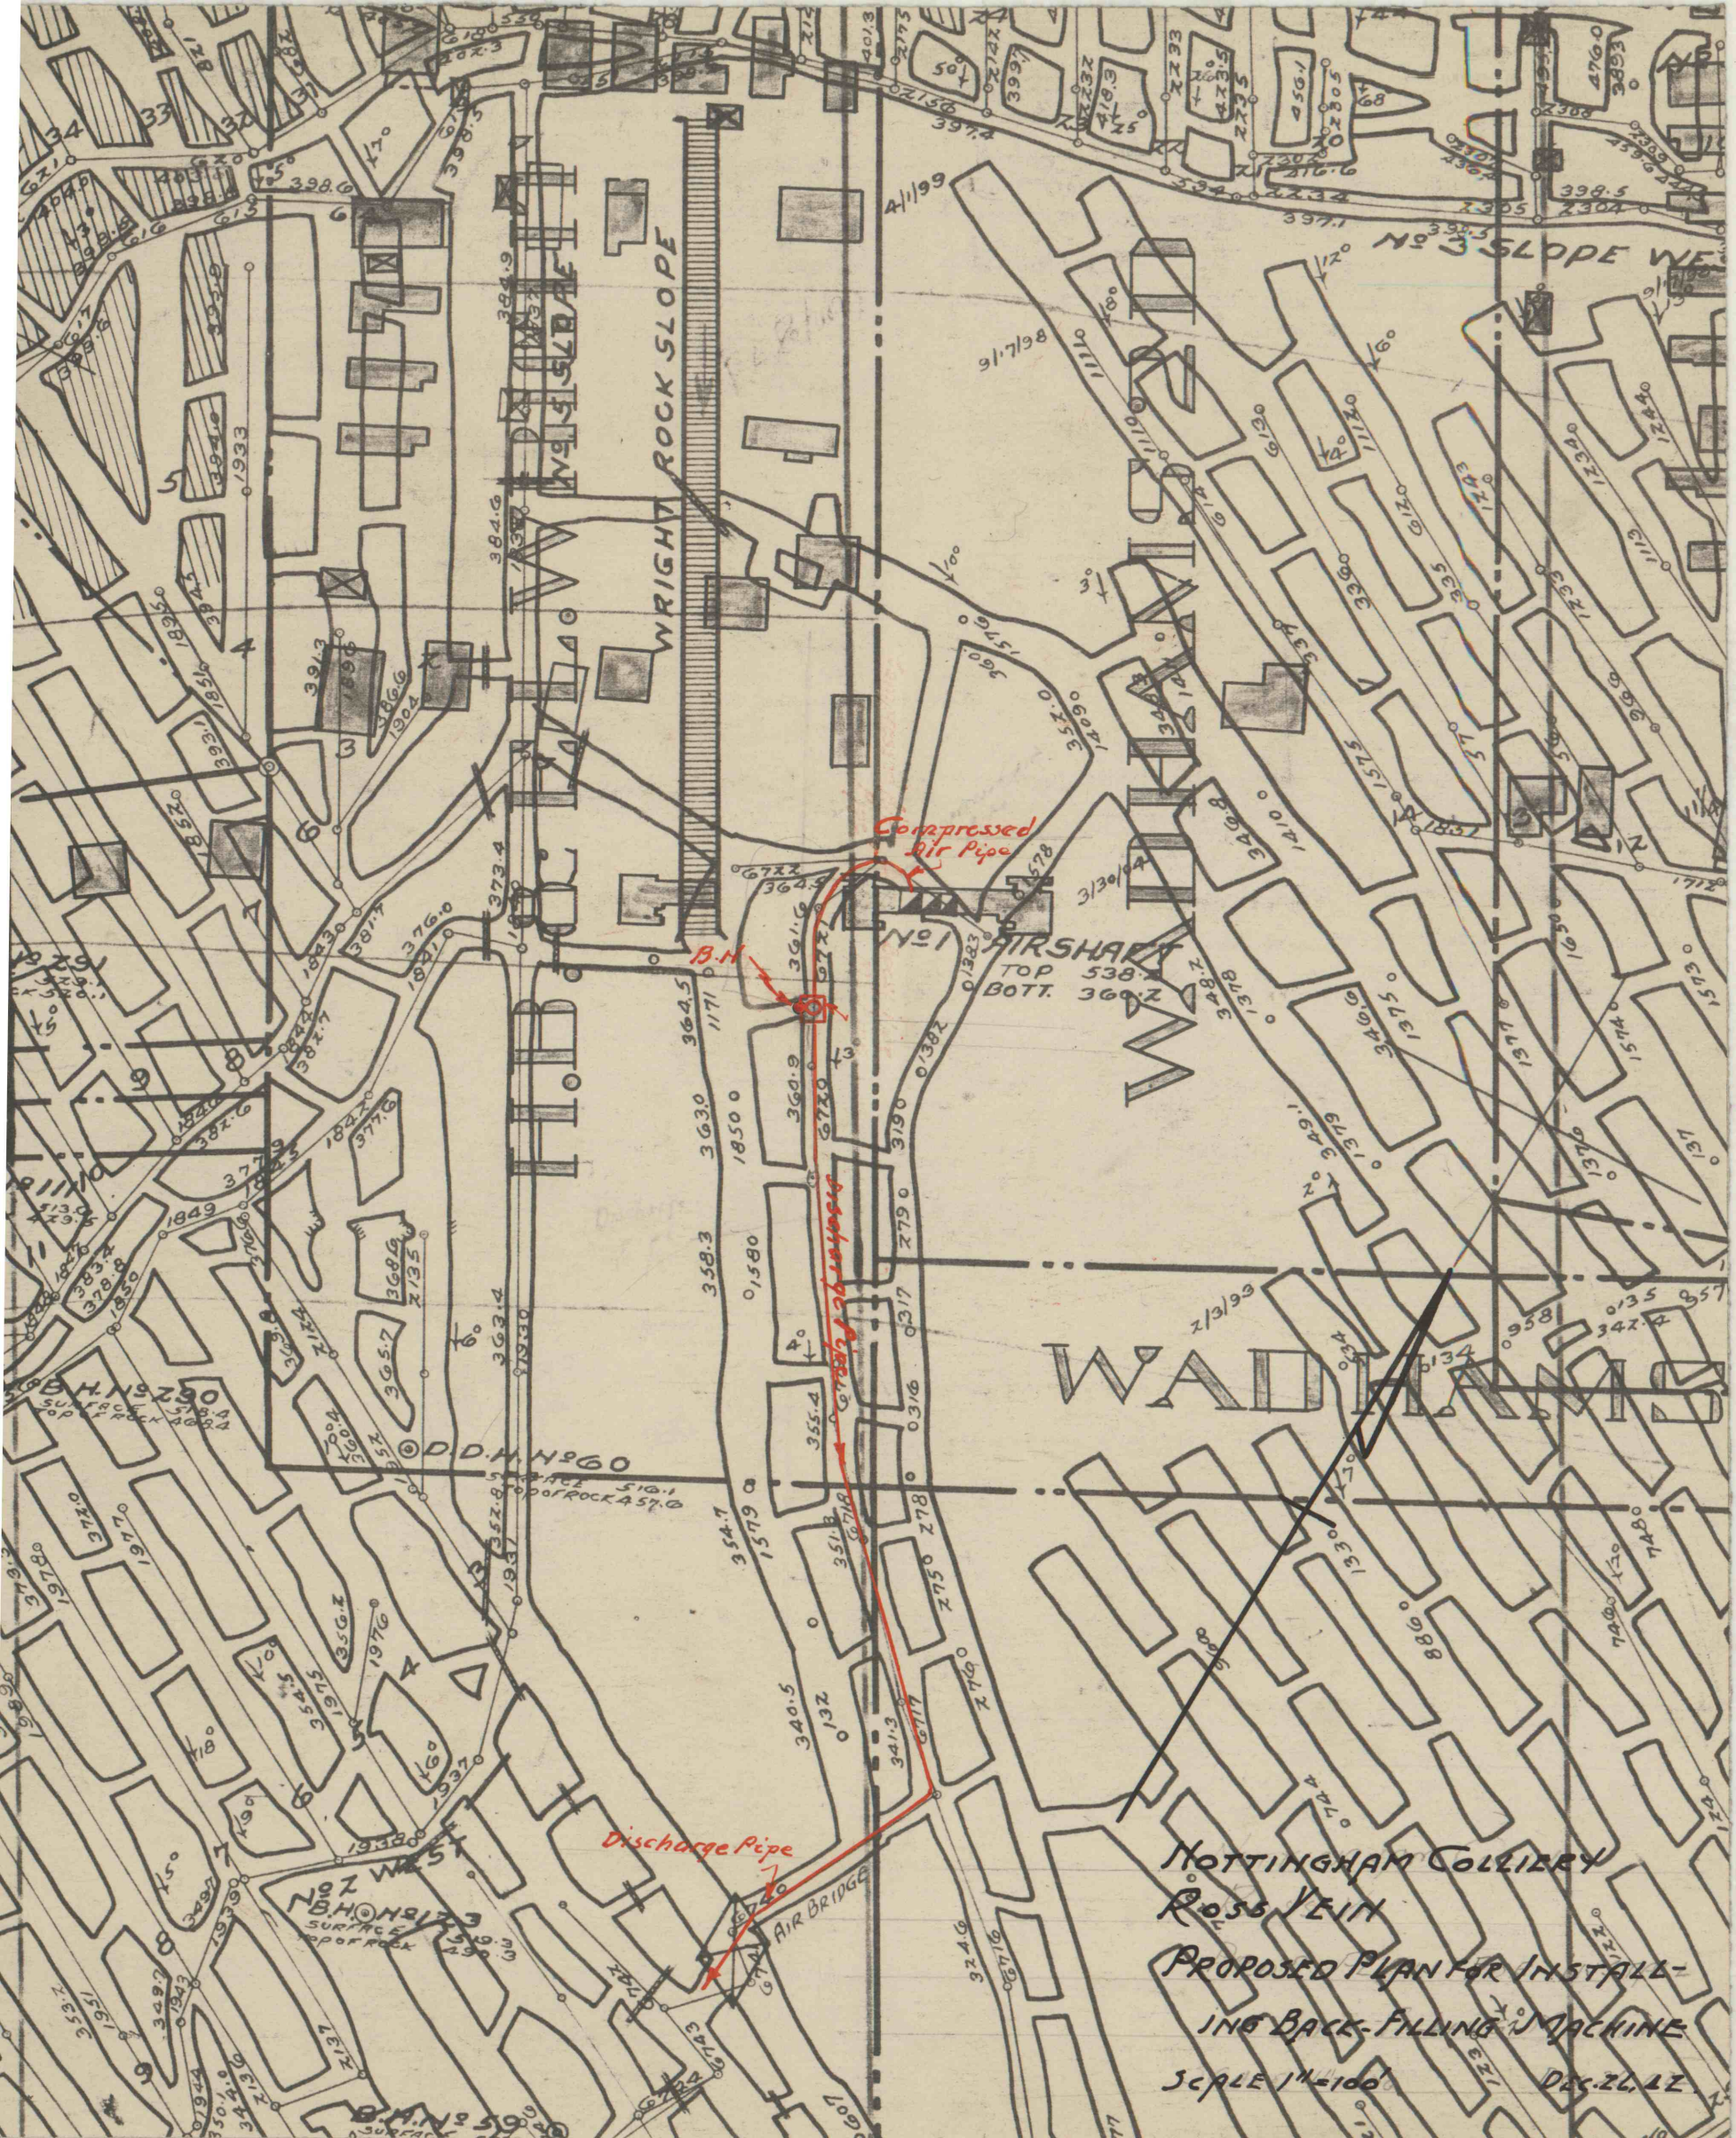

WRIGHT ROCK SLOPE

Compressed Air Pipe

B.H.

AIR SHARP
TOP 538.2
BOTT. 360.2

Discharge Pipe

D.D.H. N260

N207 WEST
SURFACE
TOP OF ROCK

NOTTINGHAM COLLIERY
ROSS VEIN
PROPOSED PLAN FOR INSTALL-
ING BACK-FILLING MACHINE
SCALE 1"=100' DEC. 26, 1912