NOTTINGHAM RED ASH VEIN

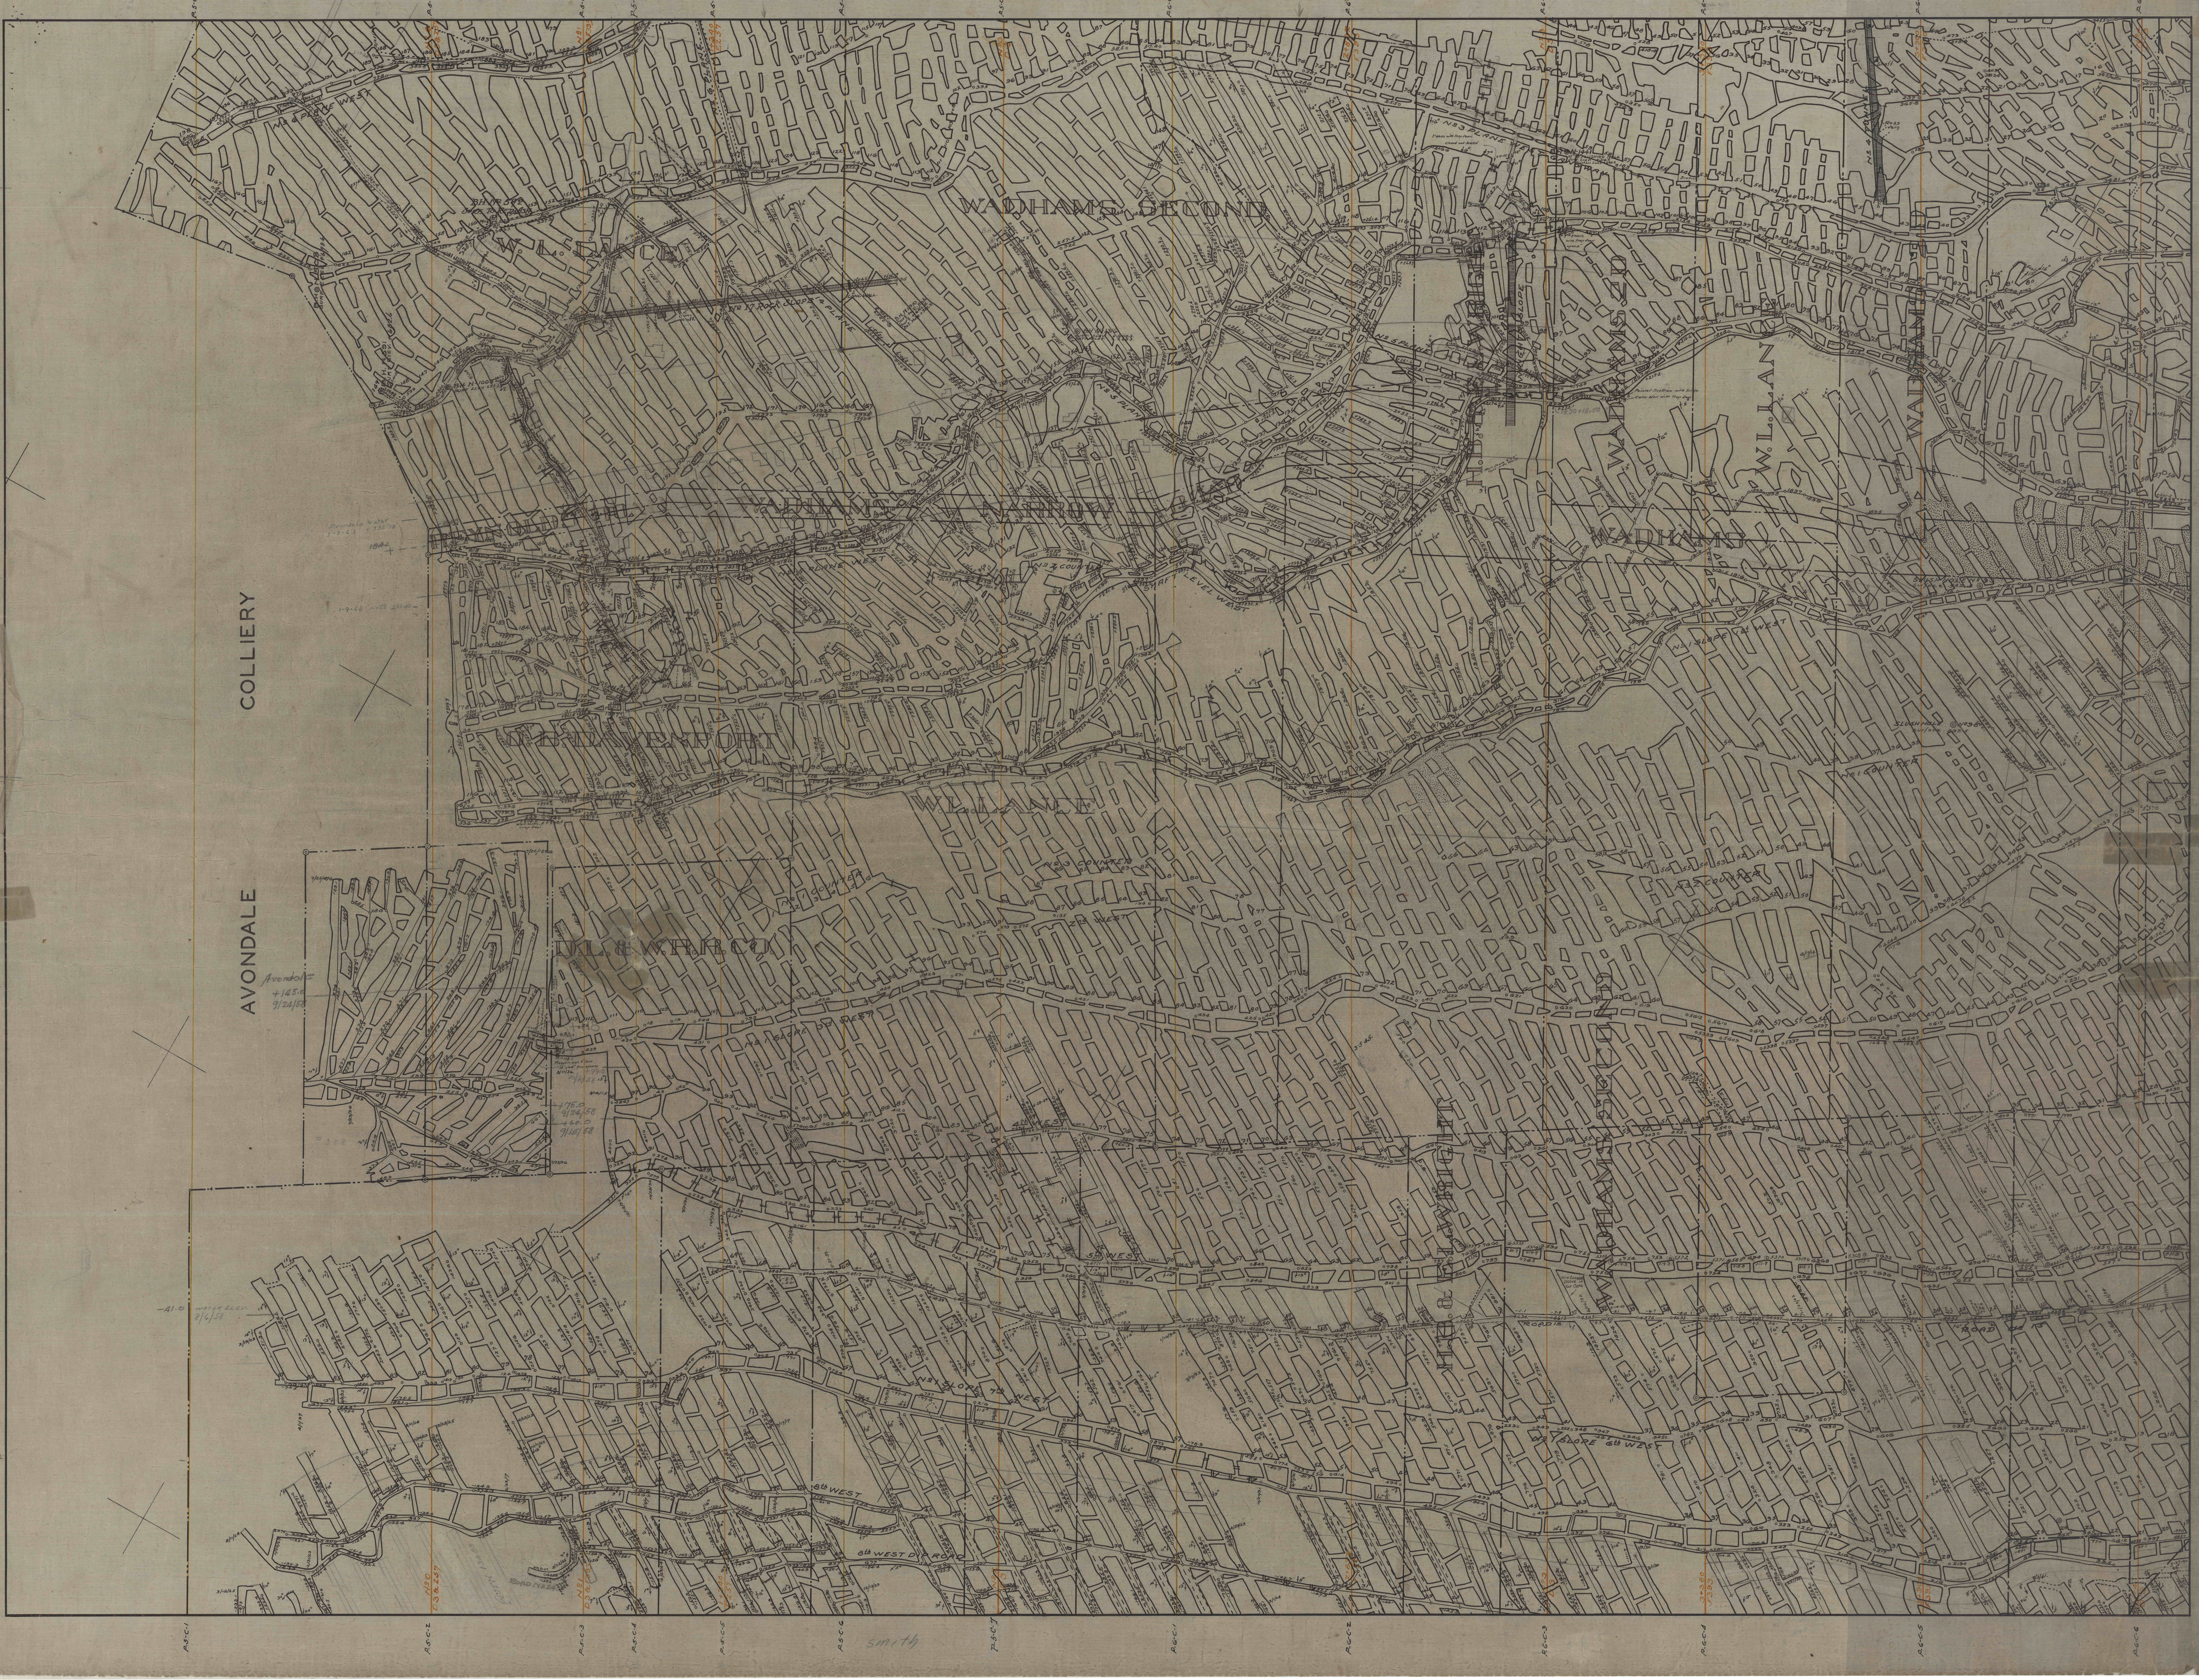

COLLIERY
AVONDALE
WADHAMS SECOND
W.L.LANCE
WADHAMS NARROW
O.B. DAVENPORT
W.L.LANCE
D.L.&W.R.R.CO.
H.B. WRIGHT
WADHAMS 2D
W.L.LAN
WADHAMS
WADHAMS
No 5 PLANE WEST
SHAFT LEVEL WEST
No 2 COUNTER
No 3 COUNTER
No 1 SLOPE 1st WEST
Avondale +165.0 9/22/58
smith