


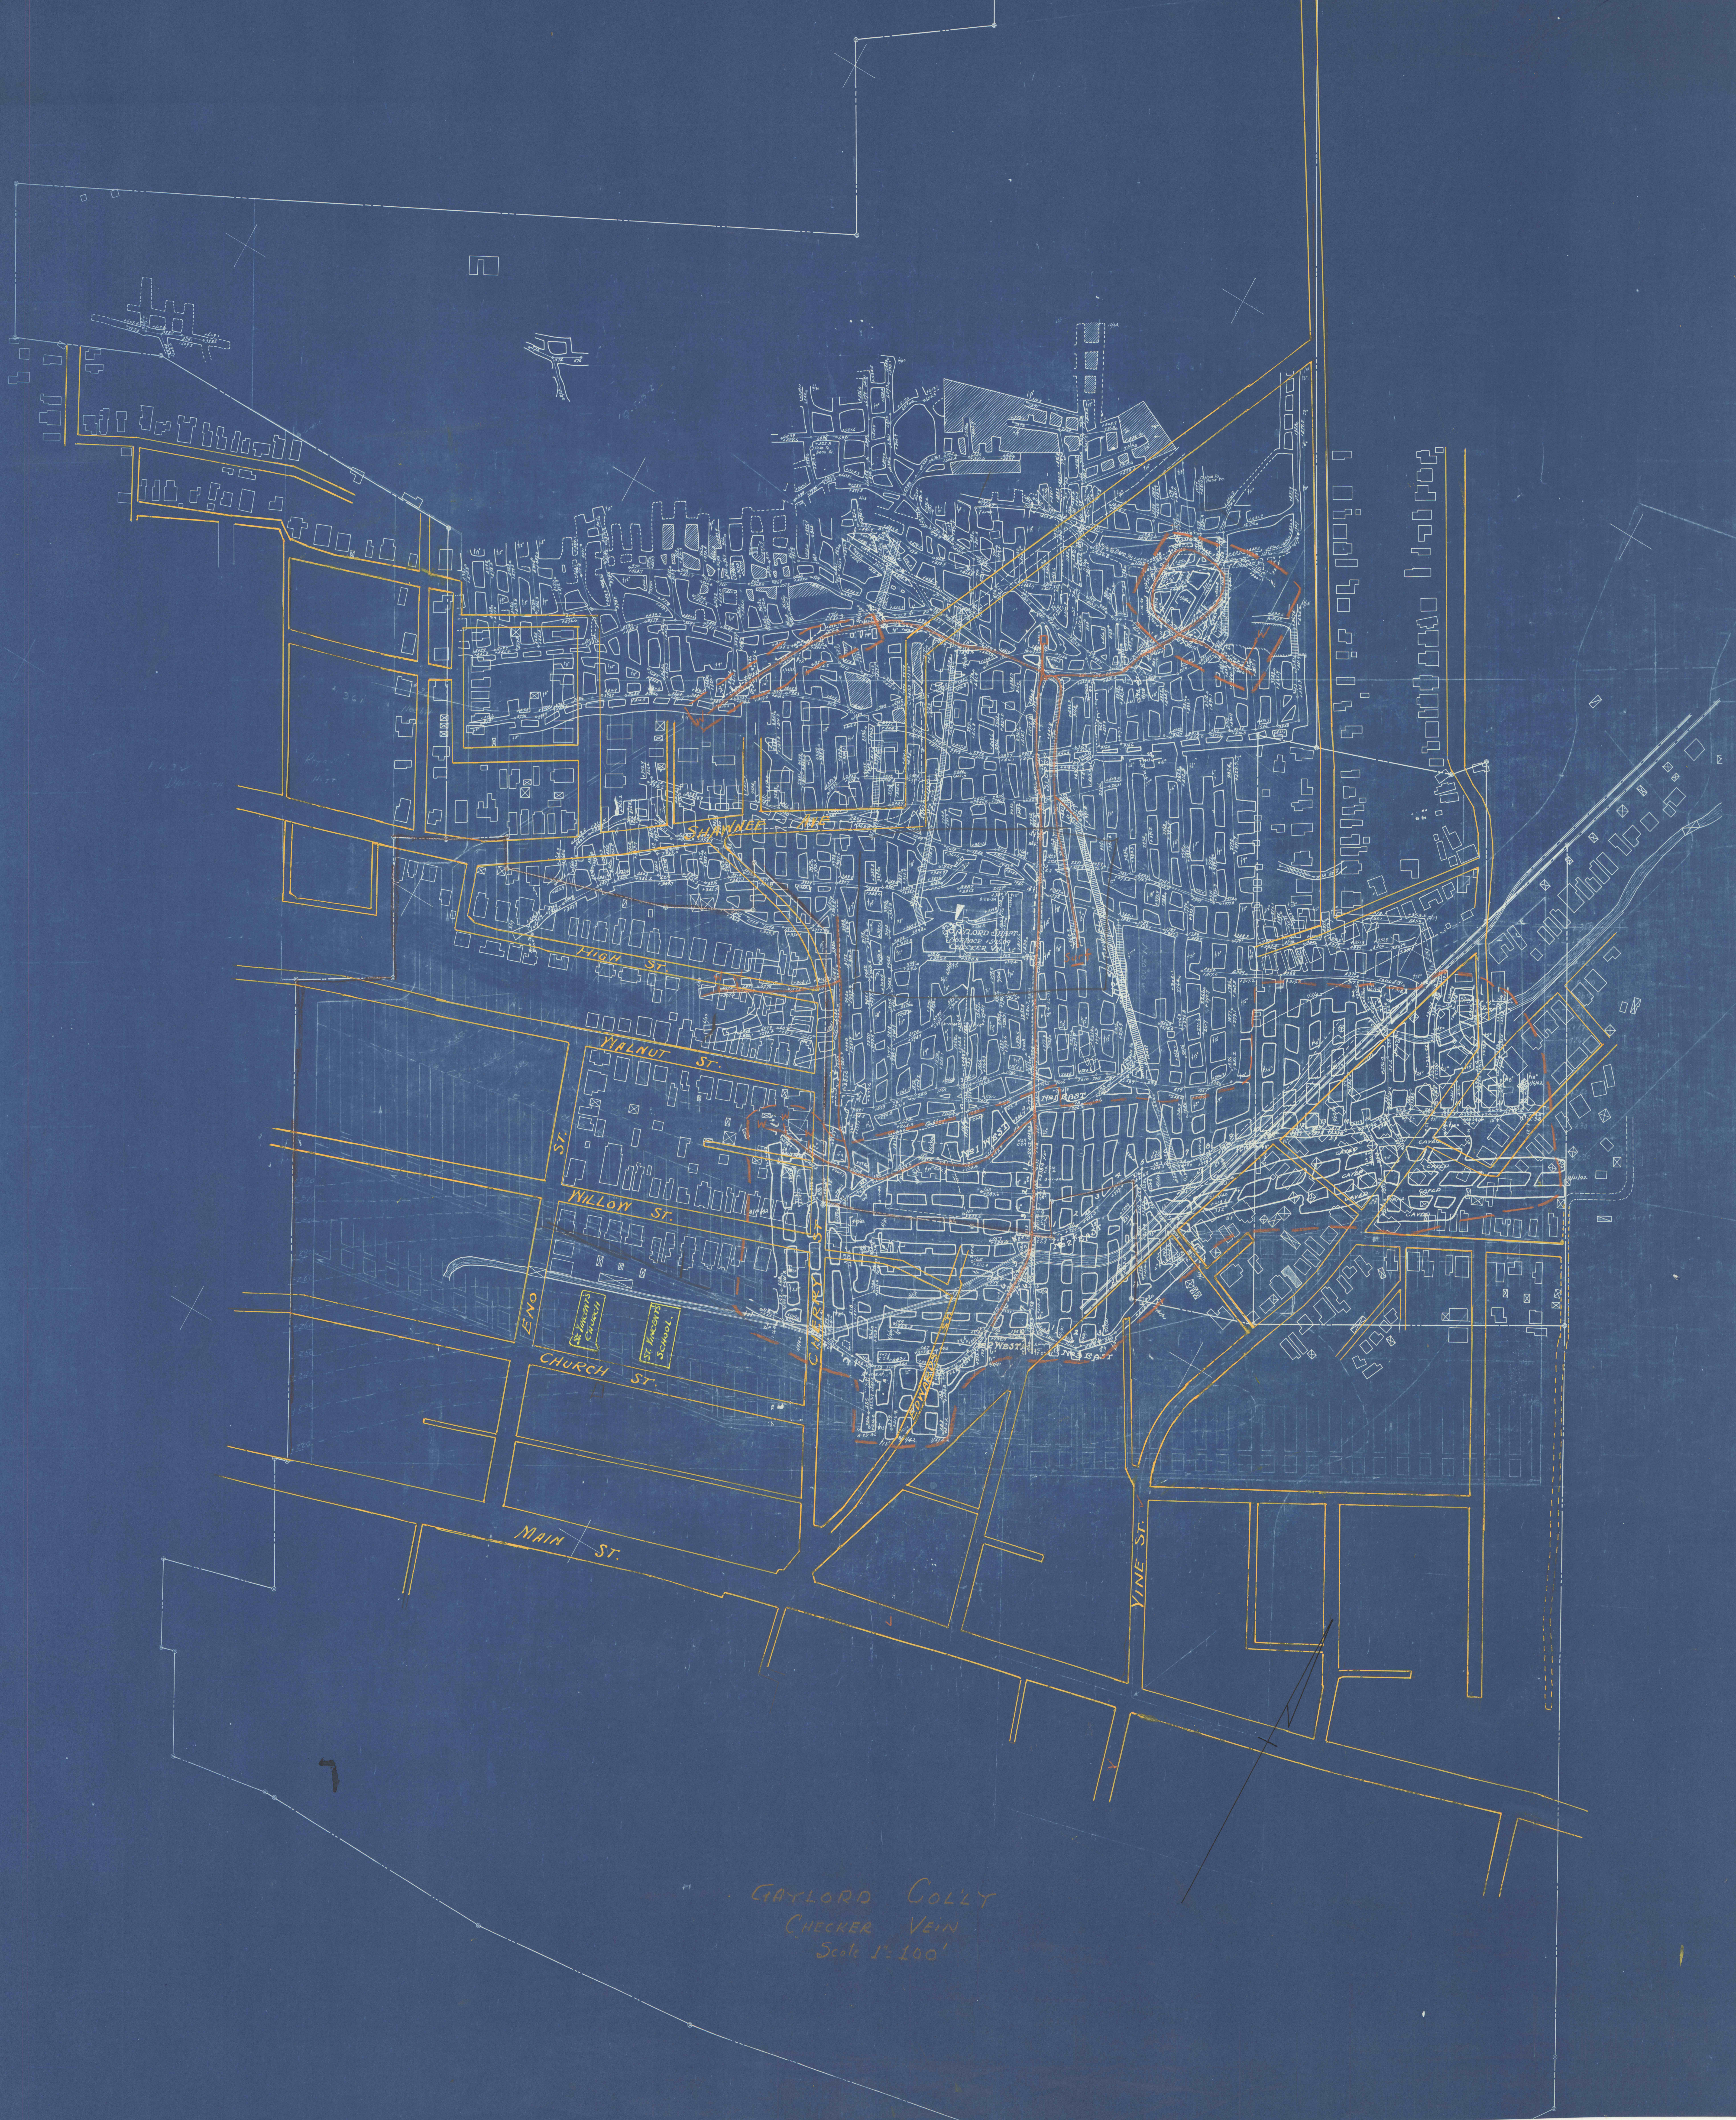

GAYLORD GOLLY
CHECKER VEIN
Scale 1"=100'