

Dot. 400.7

6+80
689.5

6+25
Bot Rock 682.0

680.0

Bot Rock 674.6

Surf. 178.0
Bot. Yr 674.0

4+26
661.6

3+90
657.5

3+78
663.2

Bot Yr 633.0

653.8

2+30

2+60
Top Yr. 628.9

2+30
Bot Yr 615.0

629.8

2+05
645.0

Bot Yr 603.0

1+33
640.7

1+13
635.1

Bot Yr 595.0

1+06
638.0

0+92
640.0

Bot. Yr 590.0

0+0
Surf. 635.0

Yr. 588.0

Dotum 400.7

0+0
642.0
Bot. Yr 596.0

0+74
633.1
D.H. SURF 640.0

1+24
625.1

1+44
634.8

Bot Yr 603.0

2+04
637.4

2+44
630.0
Yr 605.0

3+37
630.1

4+09
632.9


4+48
635.0

5+29
633.8

6+42
642.4

Section A-A Scale 1"=50'

Section B-B Scale 1"=50'

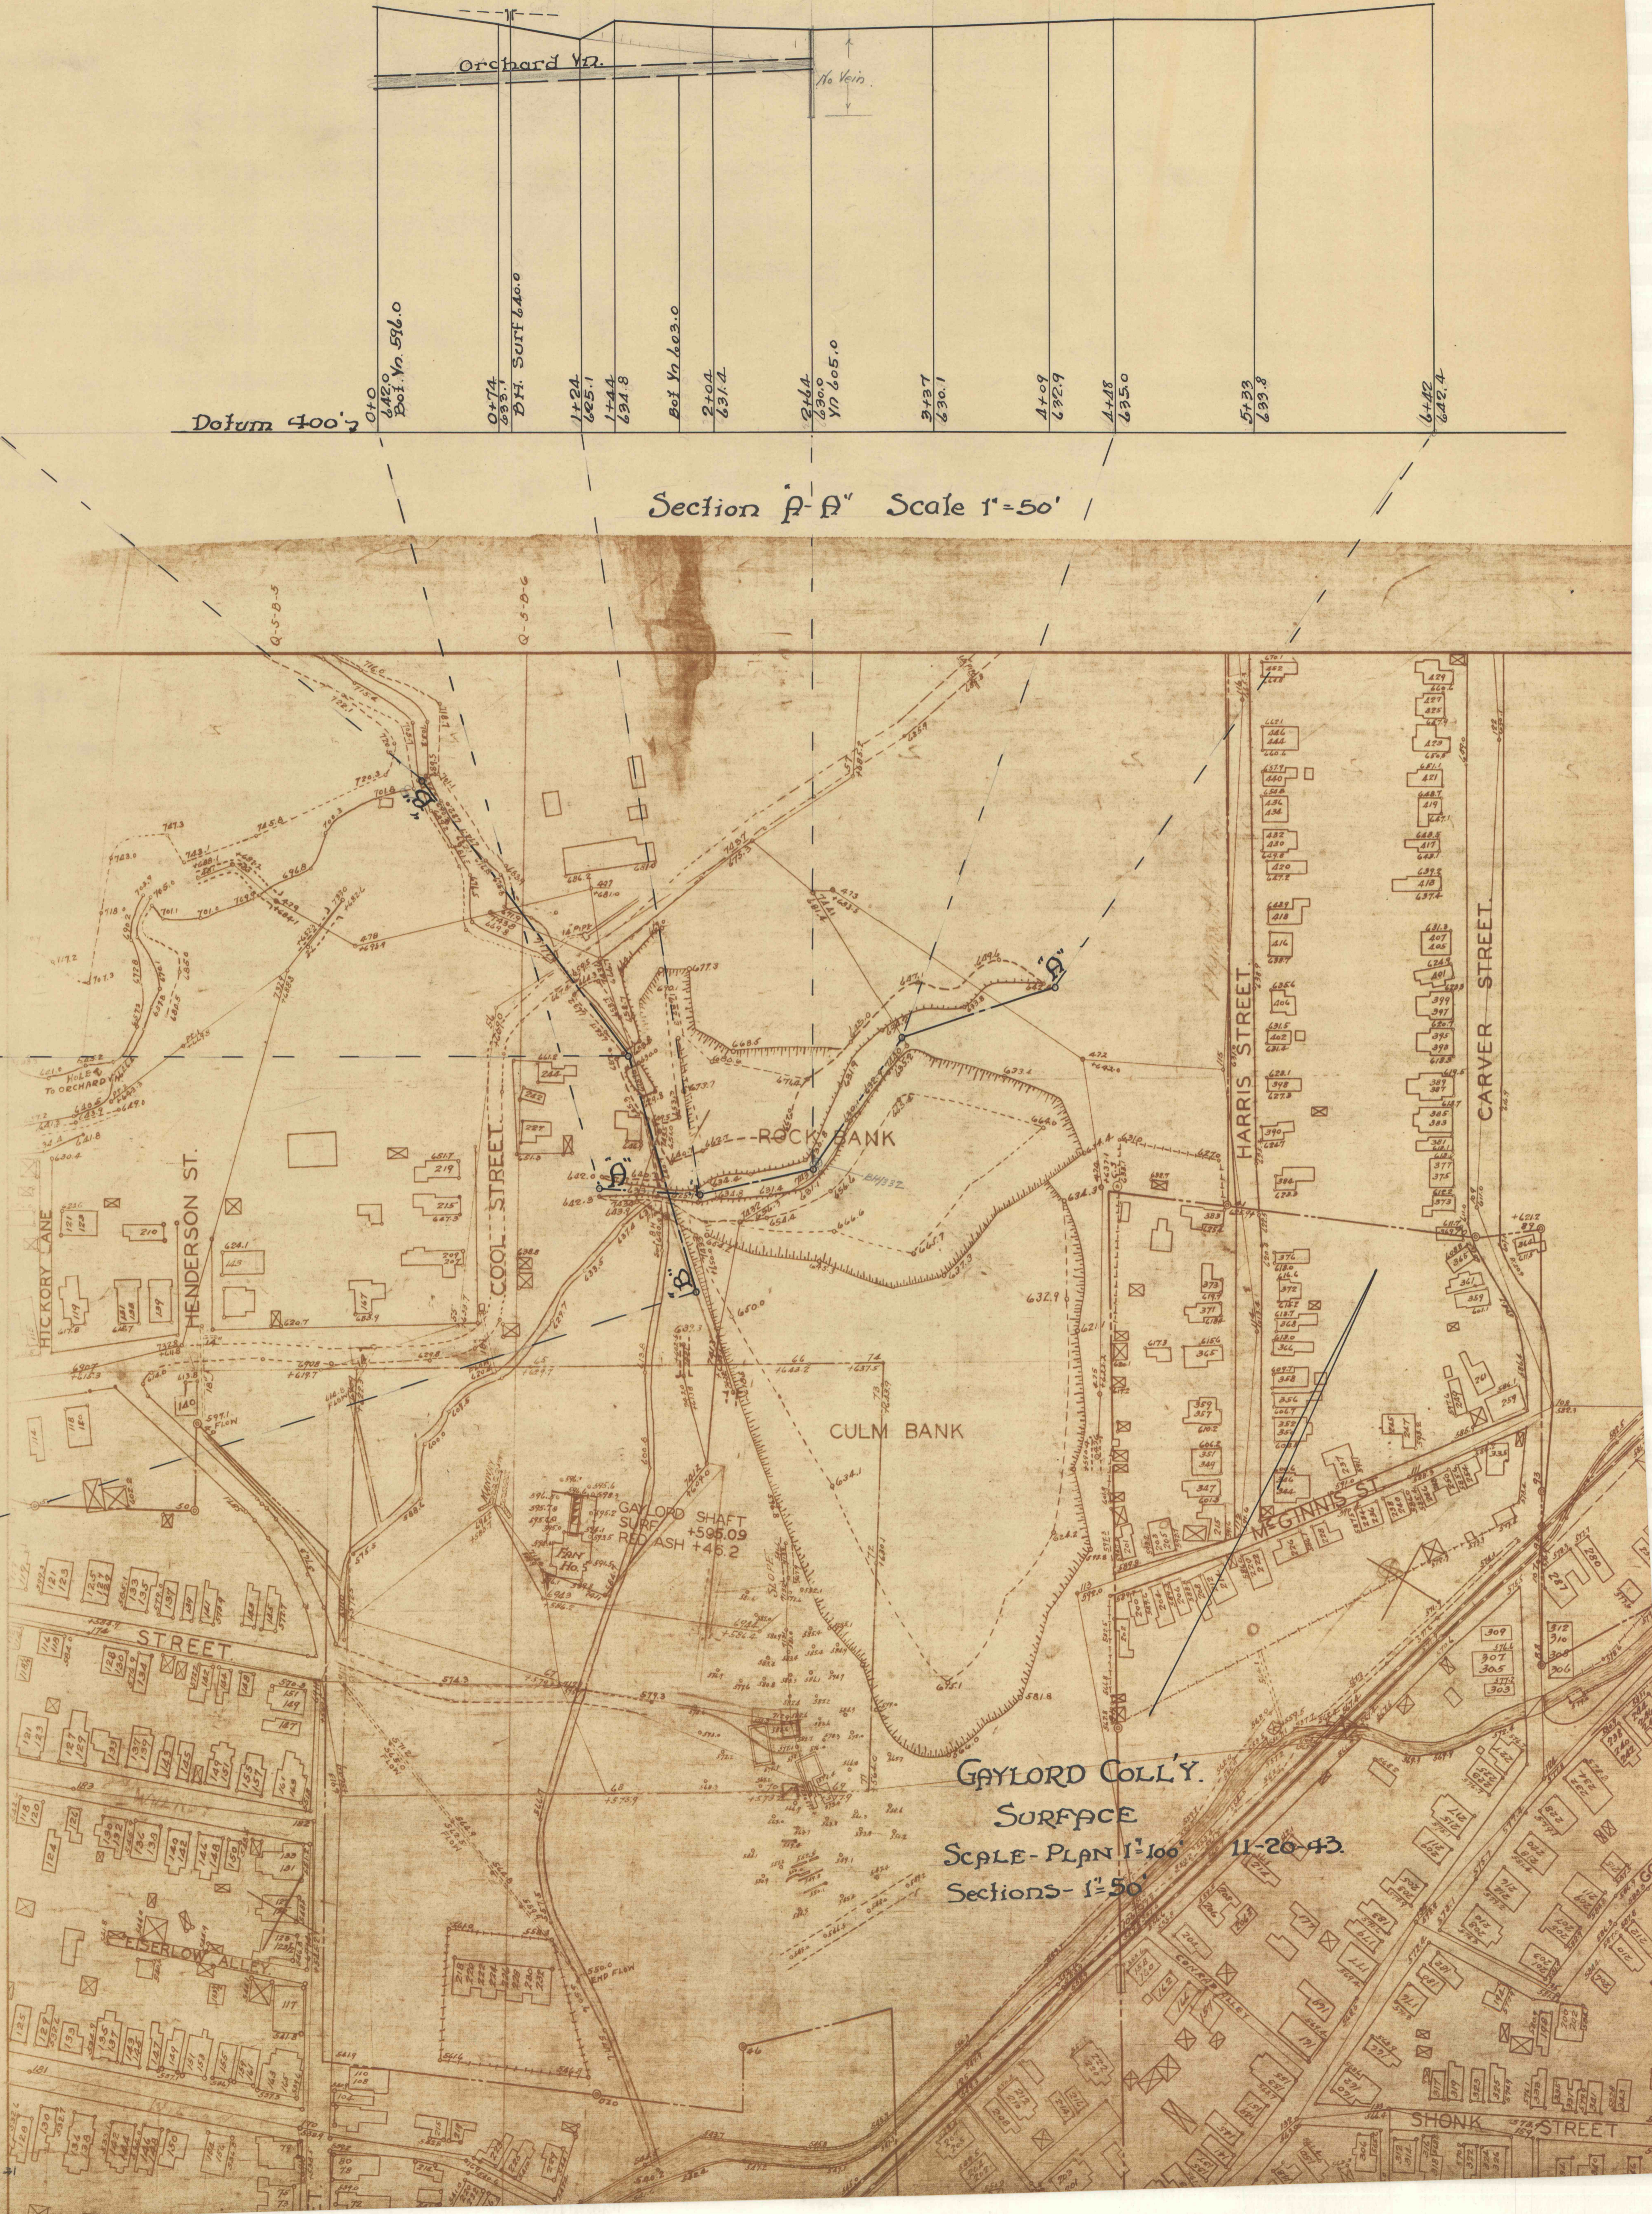

GAYLORD COLLY.
SURFACE
SCALE-PLAN 1"=100' 11-20-43
Sections- 1"=50'

PLYMOUTH