


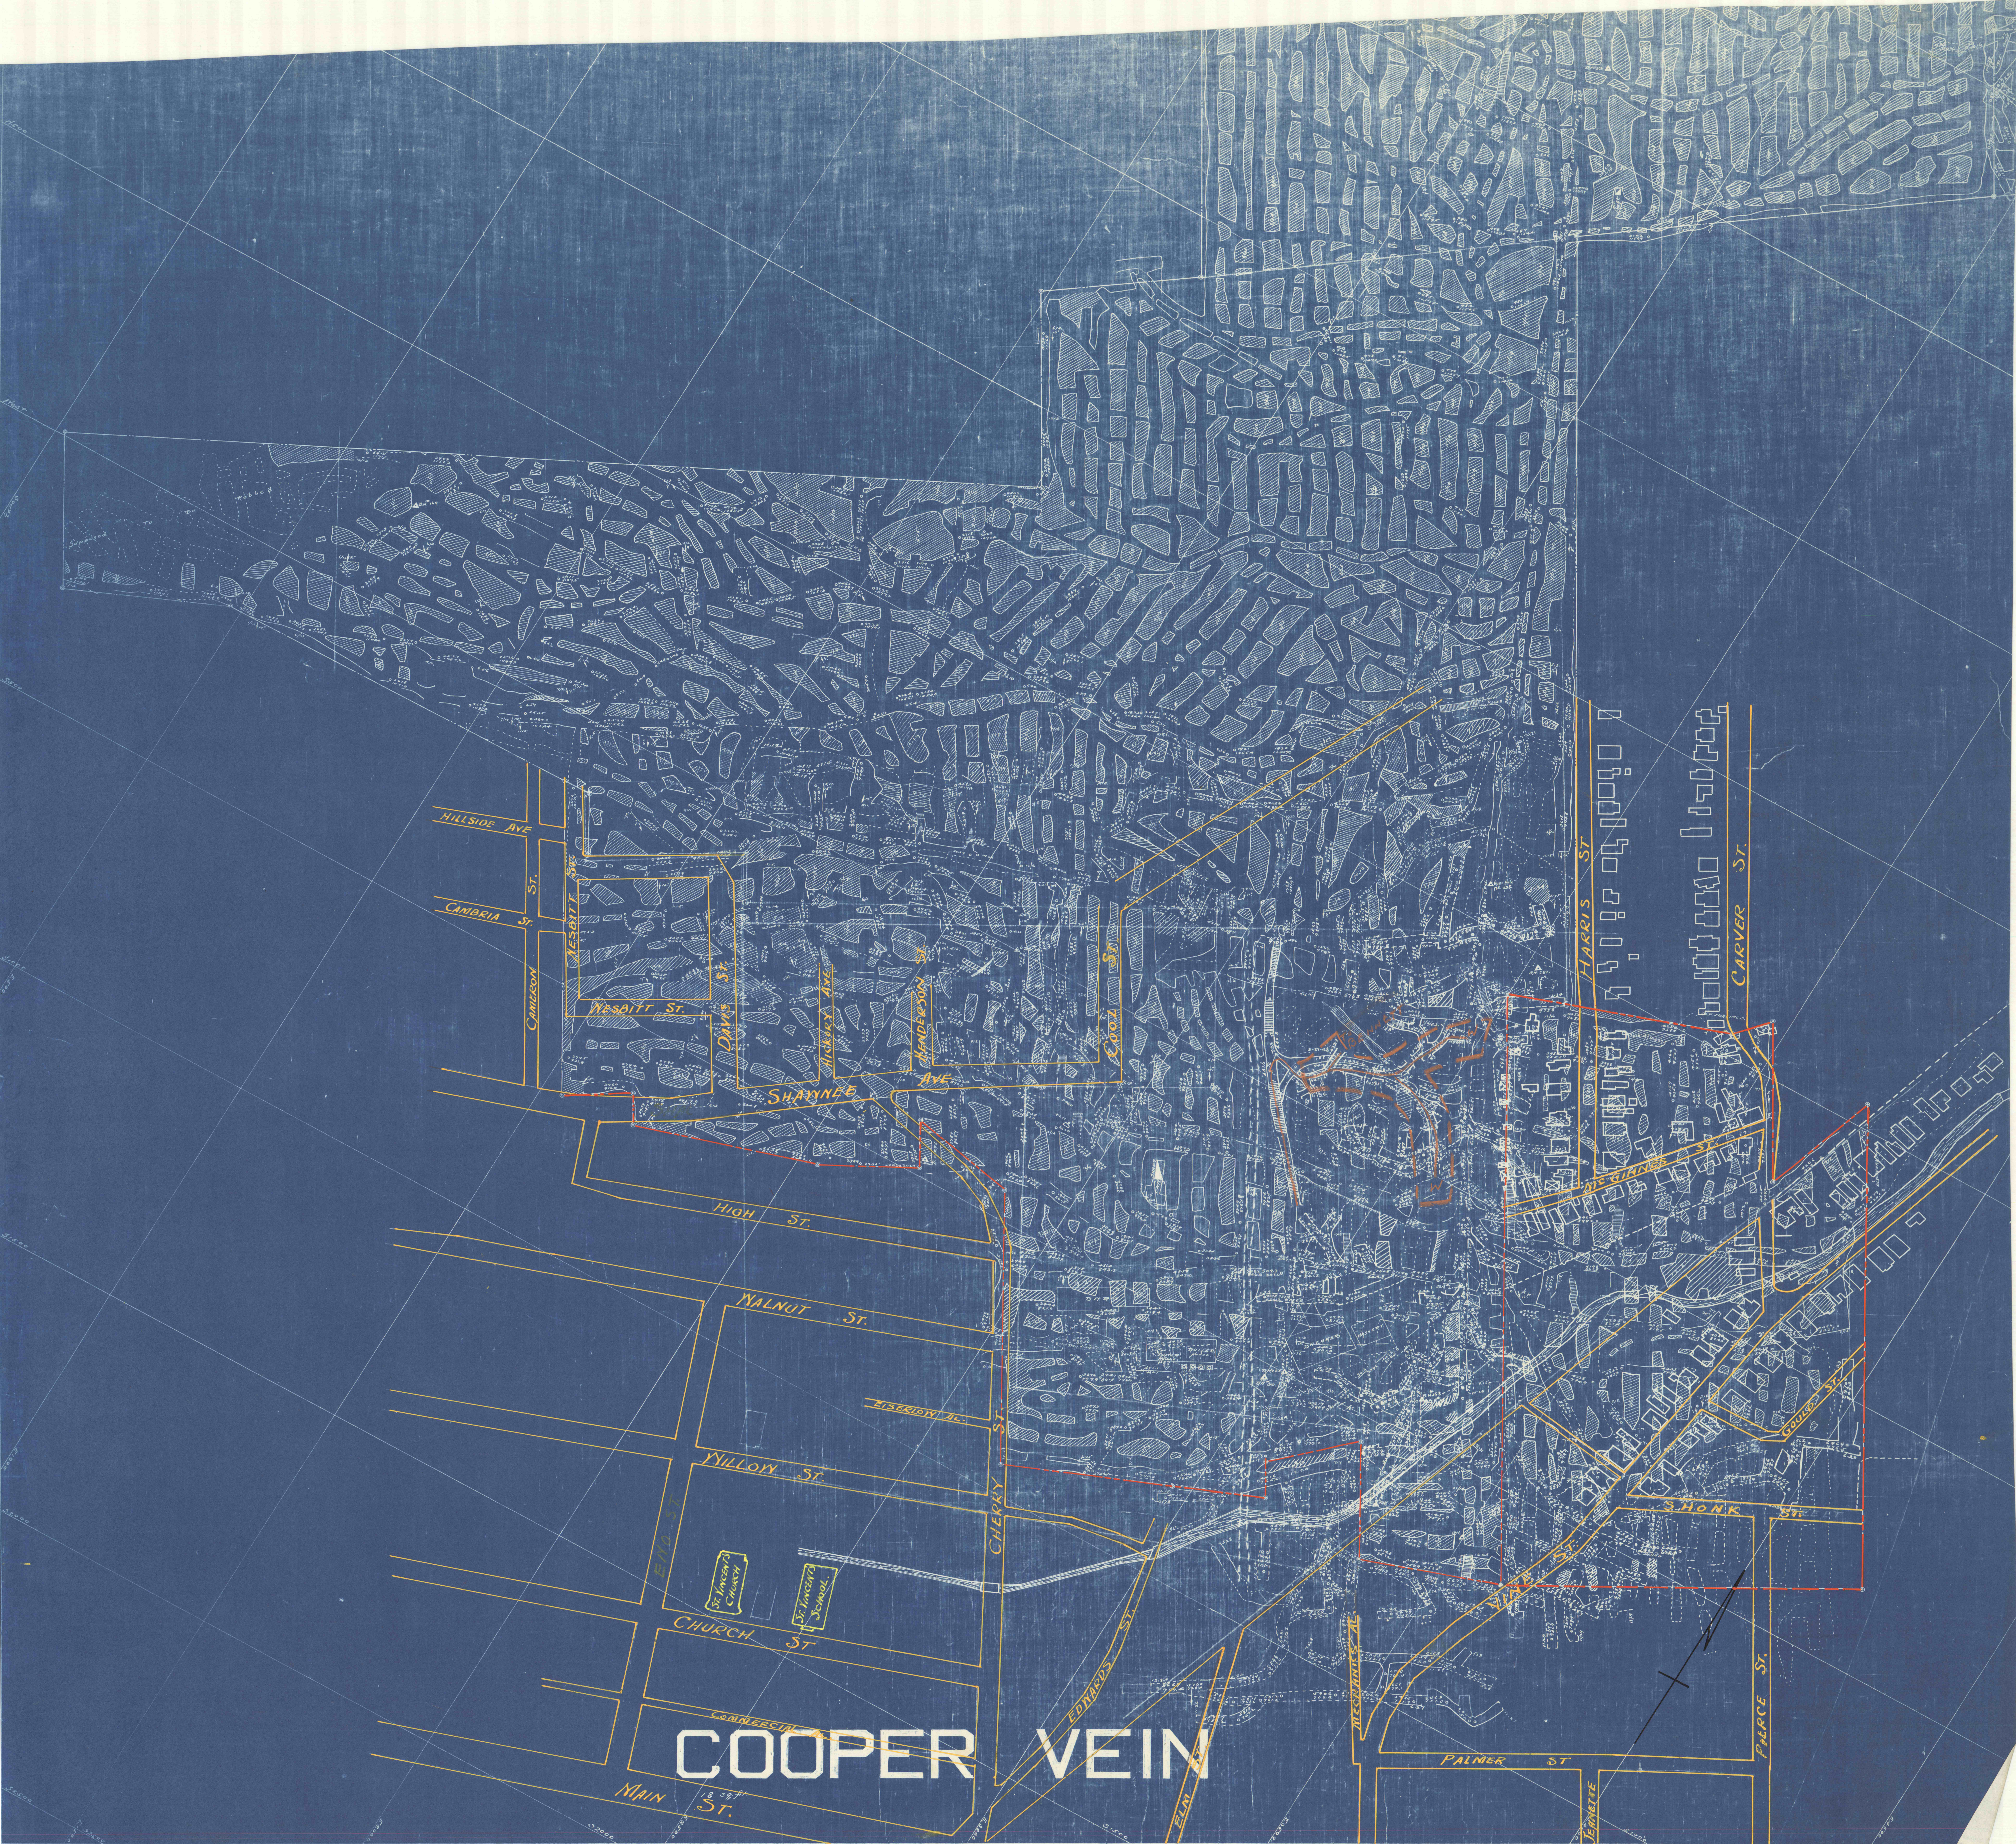

COOPER VEIN