


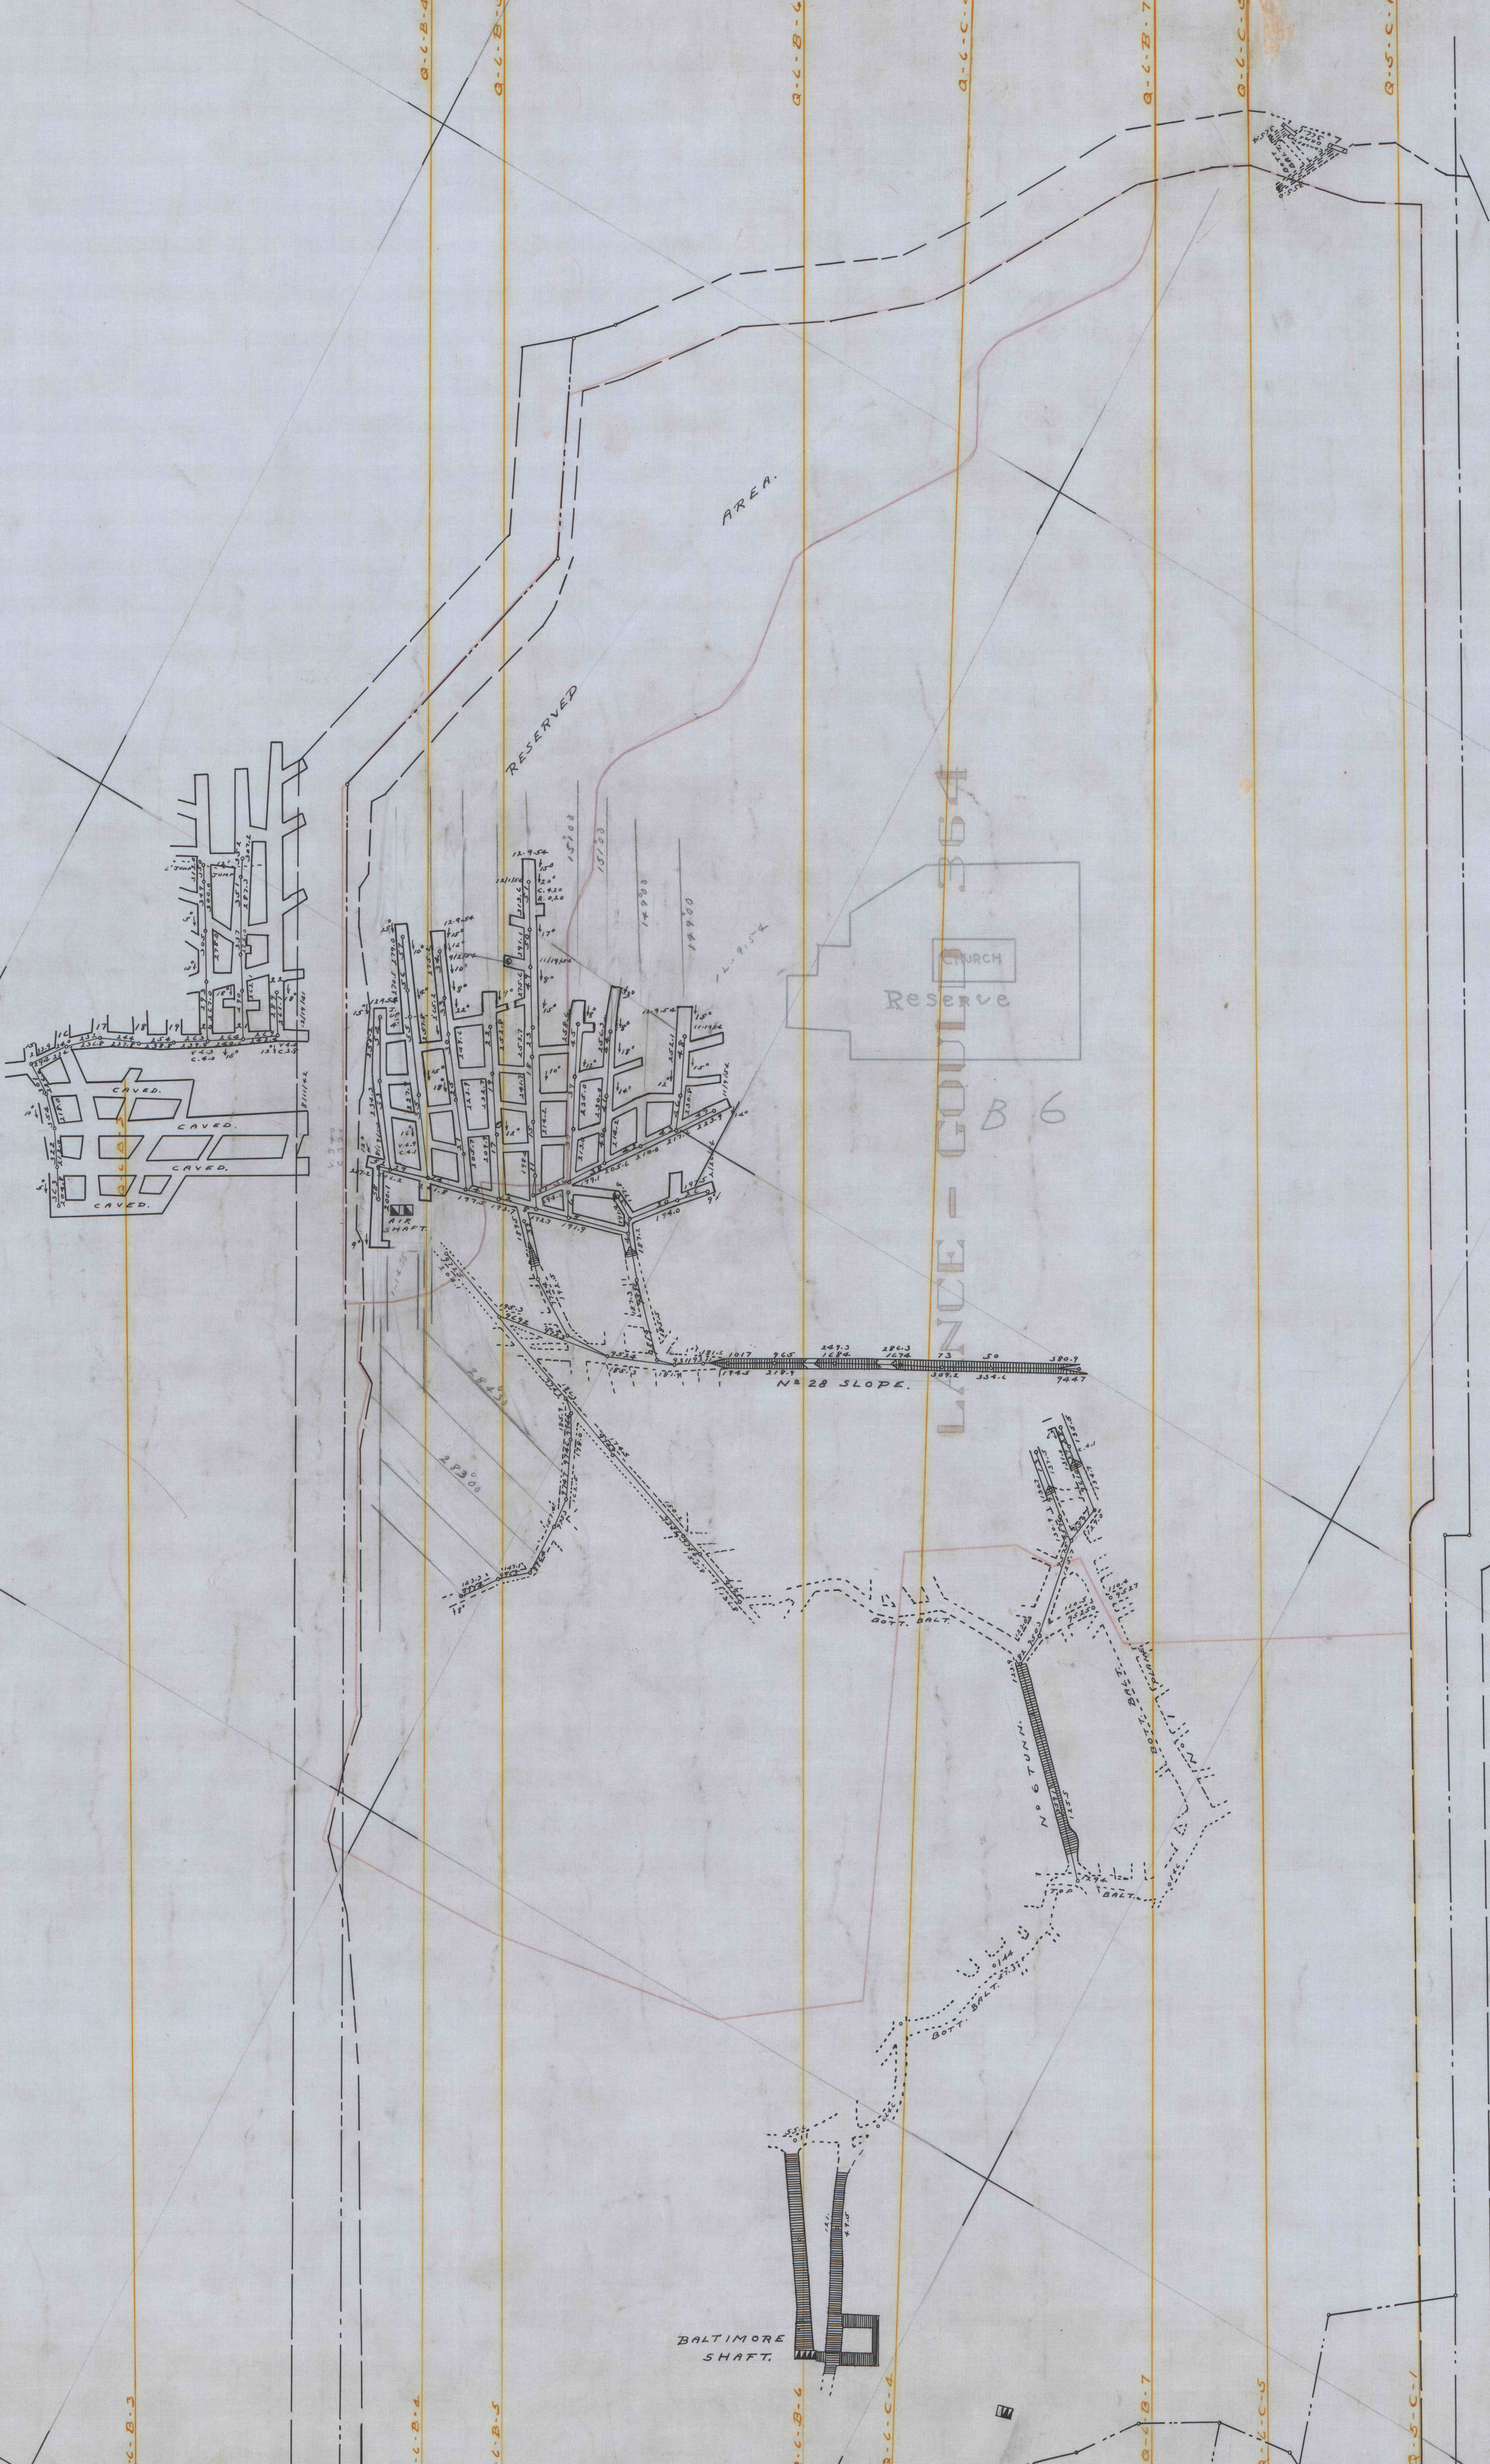

LANCE COLLIERY CHECKER VEIN