


NOTTINGHAM N°15 BOT. BALTIMORE VEIN

COLLIERY

AVONDALE

WILLIAMS SECOND 371

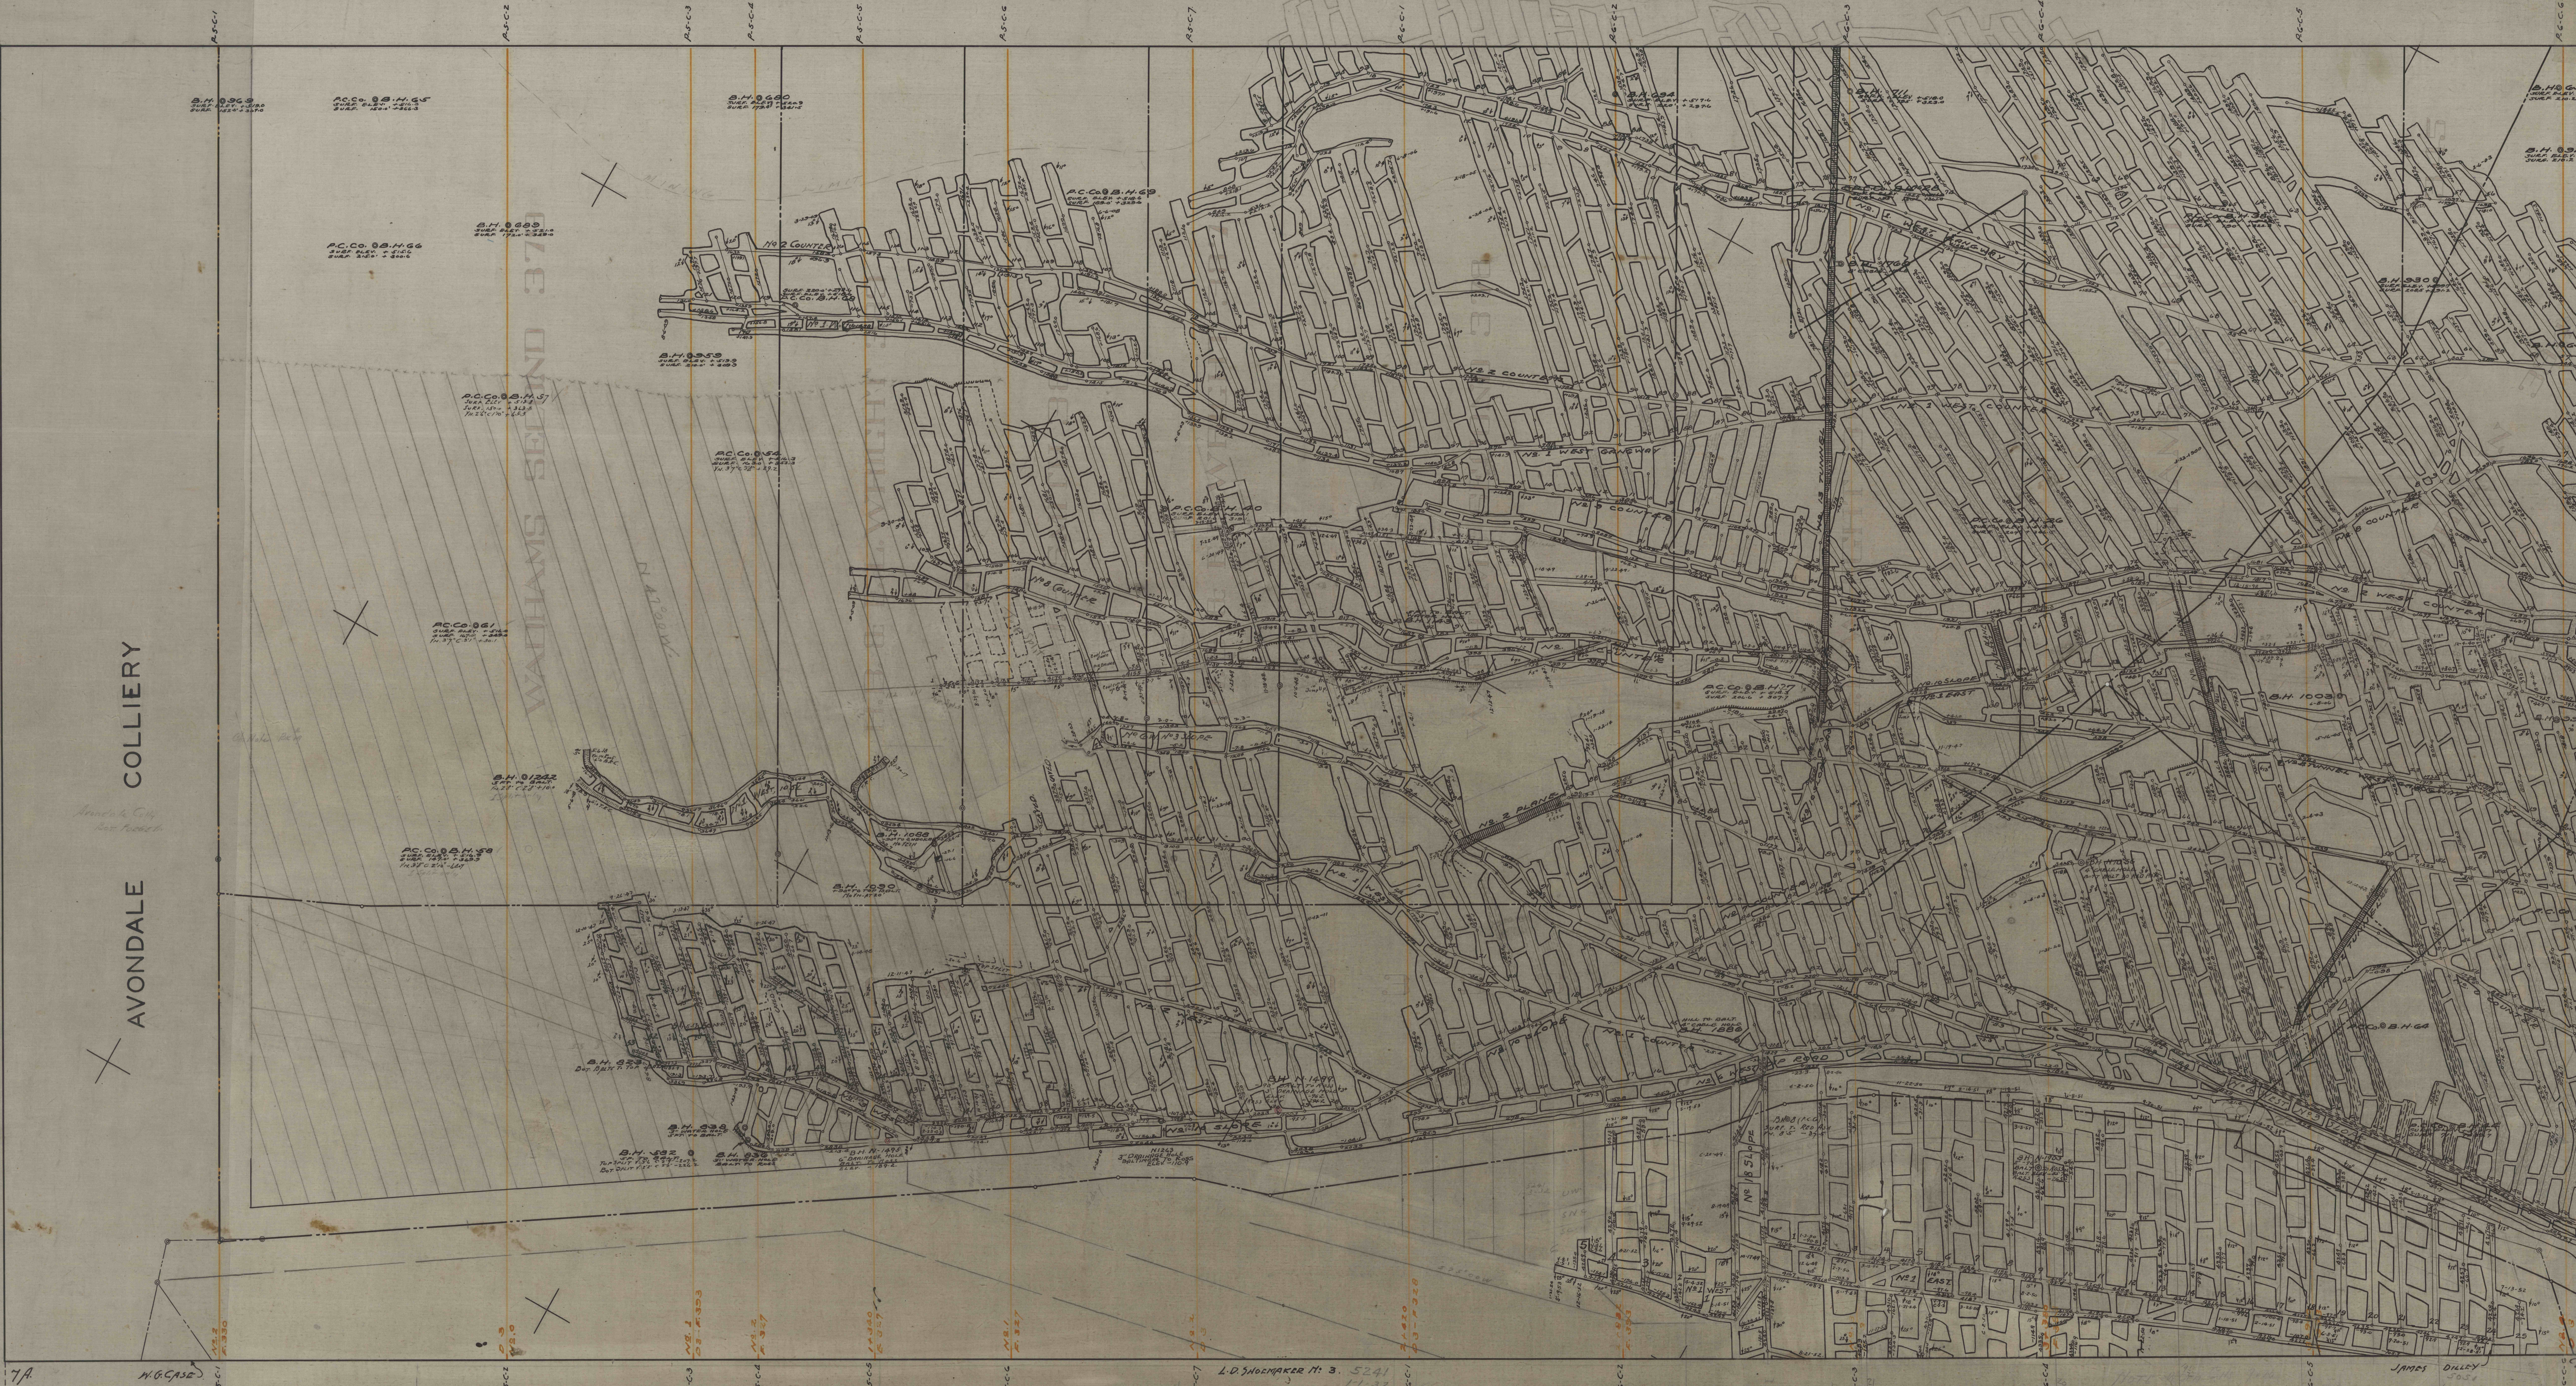

7A

H.G. CASE

L.D. SHORMAKER N: 3. 5241 1-1-32

JAMES DALLEY

S.W. TOWN 771