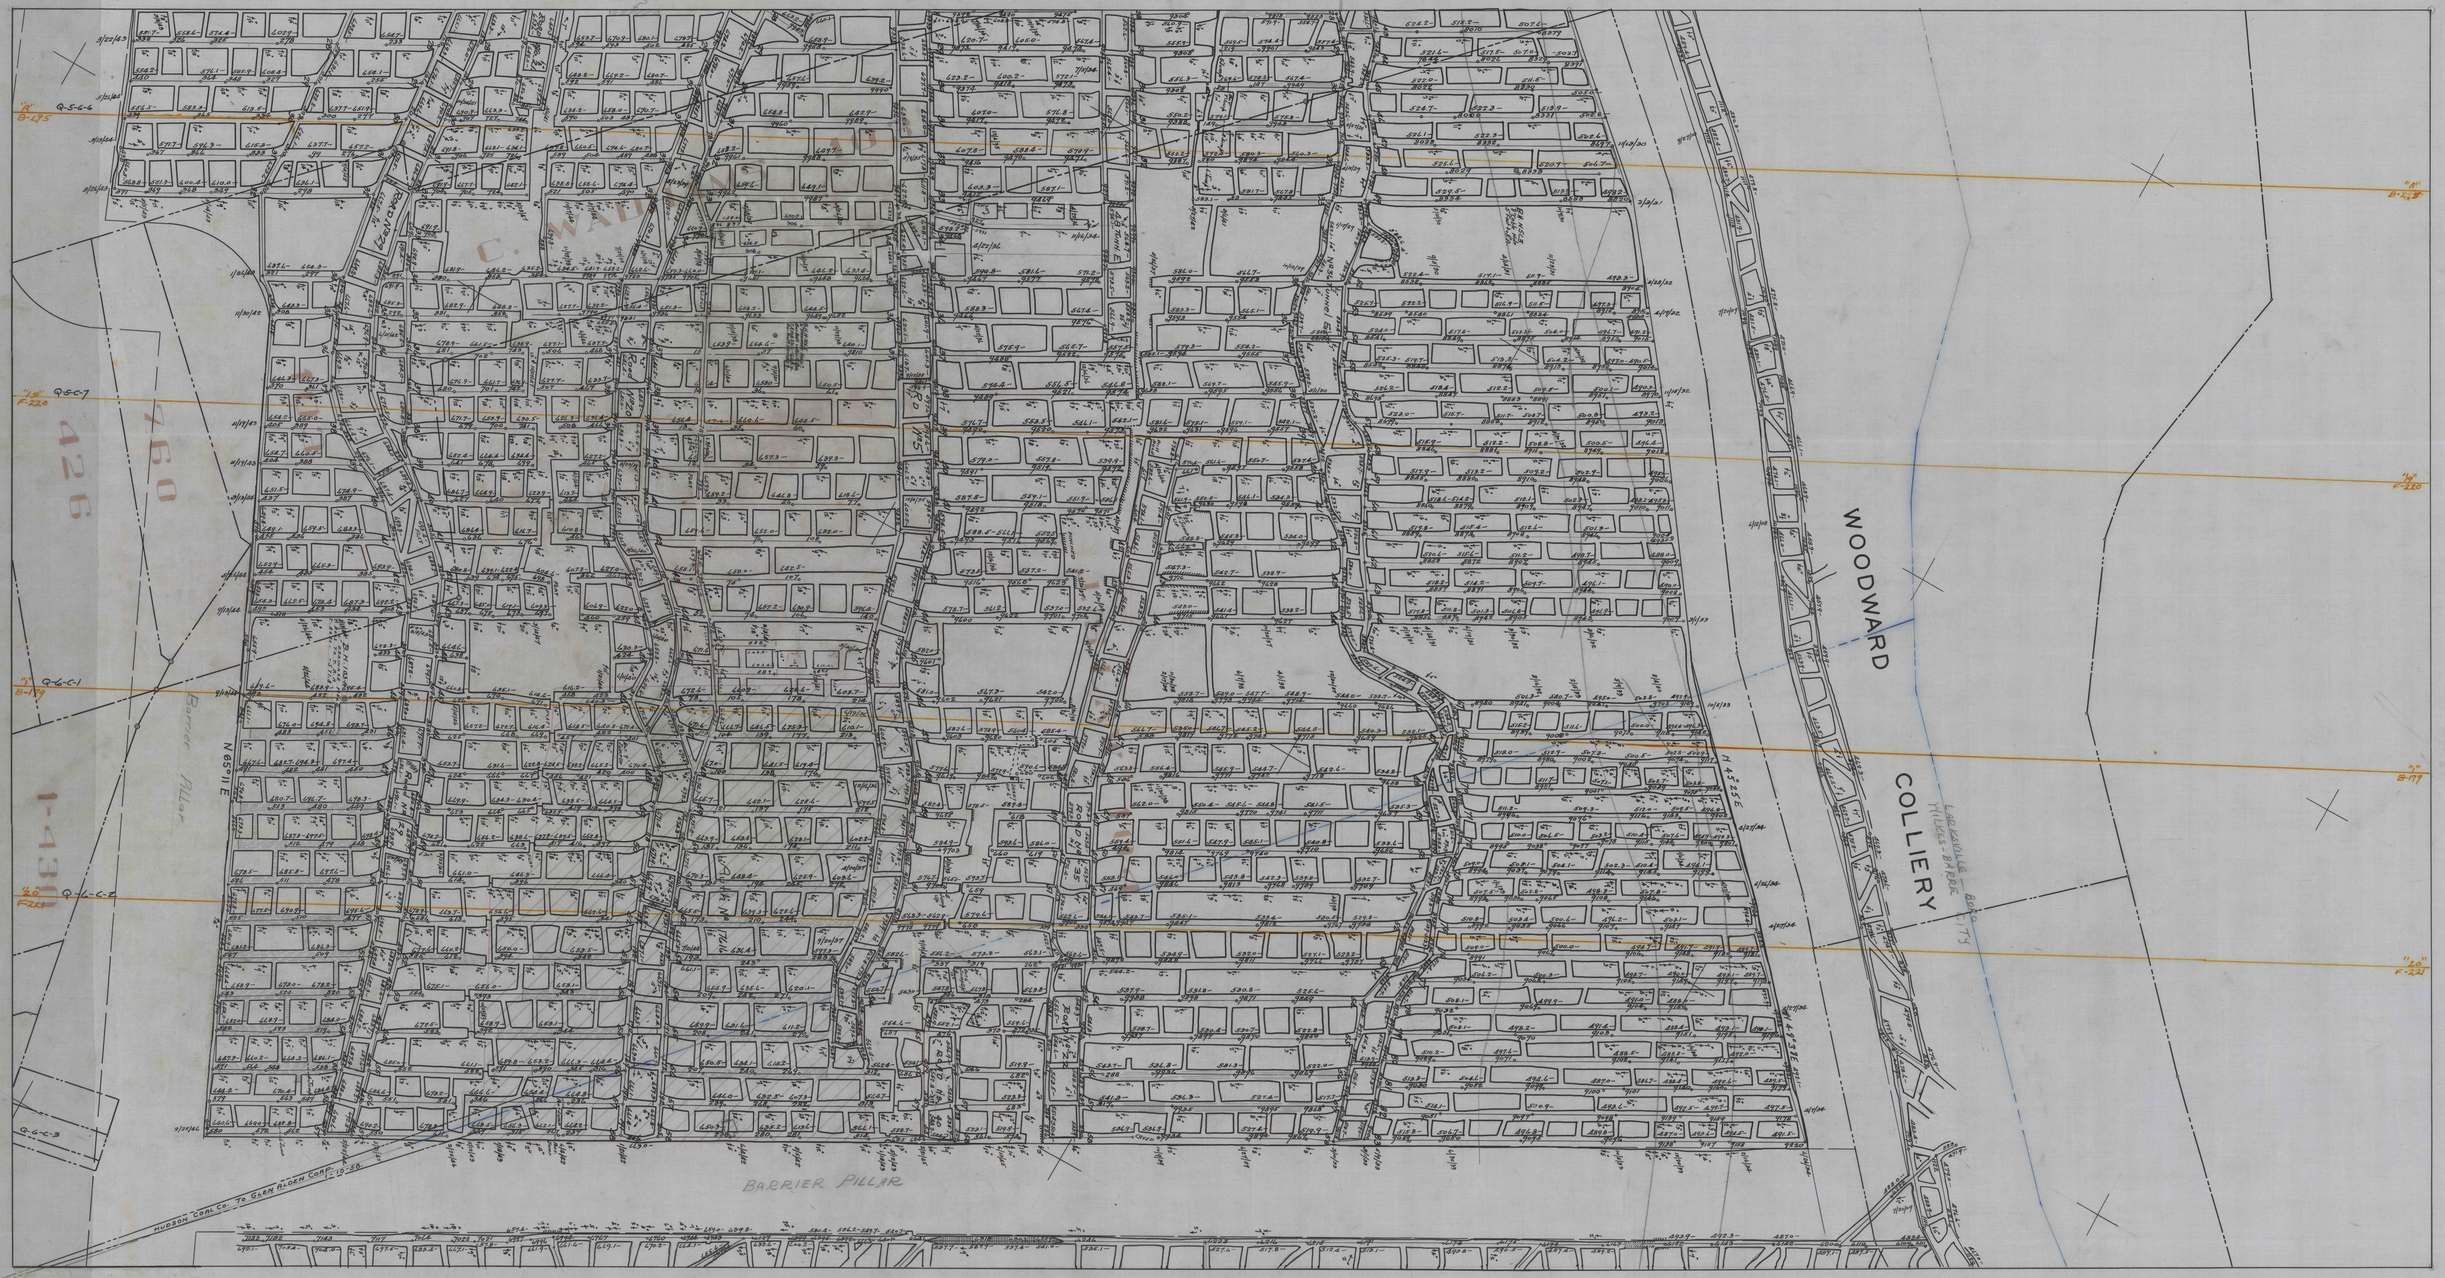
LANCE COLLIERY Nº11
TOP RED ASH
WOODWARD
COLLIERY
LANCE COLLIERY
BARRIER PILLAR
HUDSON CONS. CO. TO GLEN ALDEN CORP. 10-28-
N 69° 11' E
N 43° 25' E
Barrier Pillar
Q-5-C-6
Q-5-C-7
Q-6-C-1
Q-6-C-2
Q-6-C-3
"A" B-175
"B" F-220
"C" B-177
"D" F-221
"E" F-222
760
426
1-431