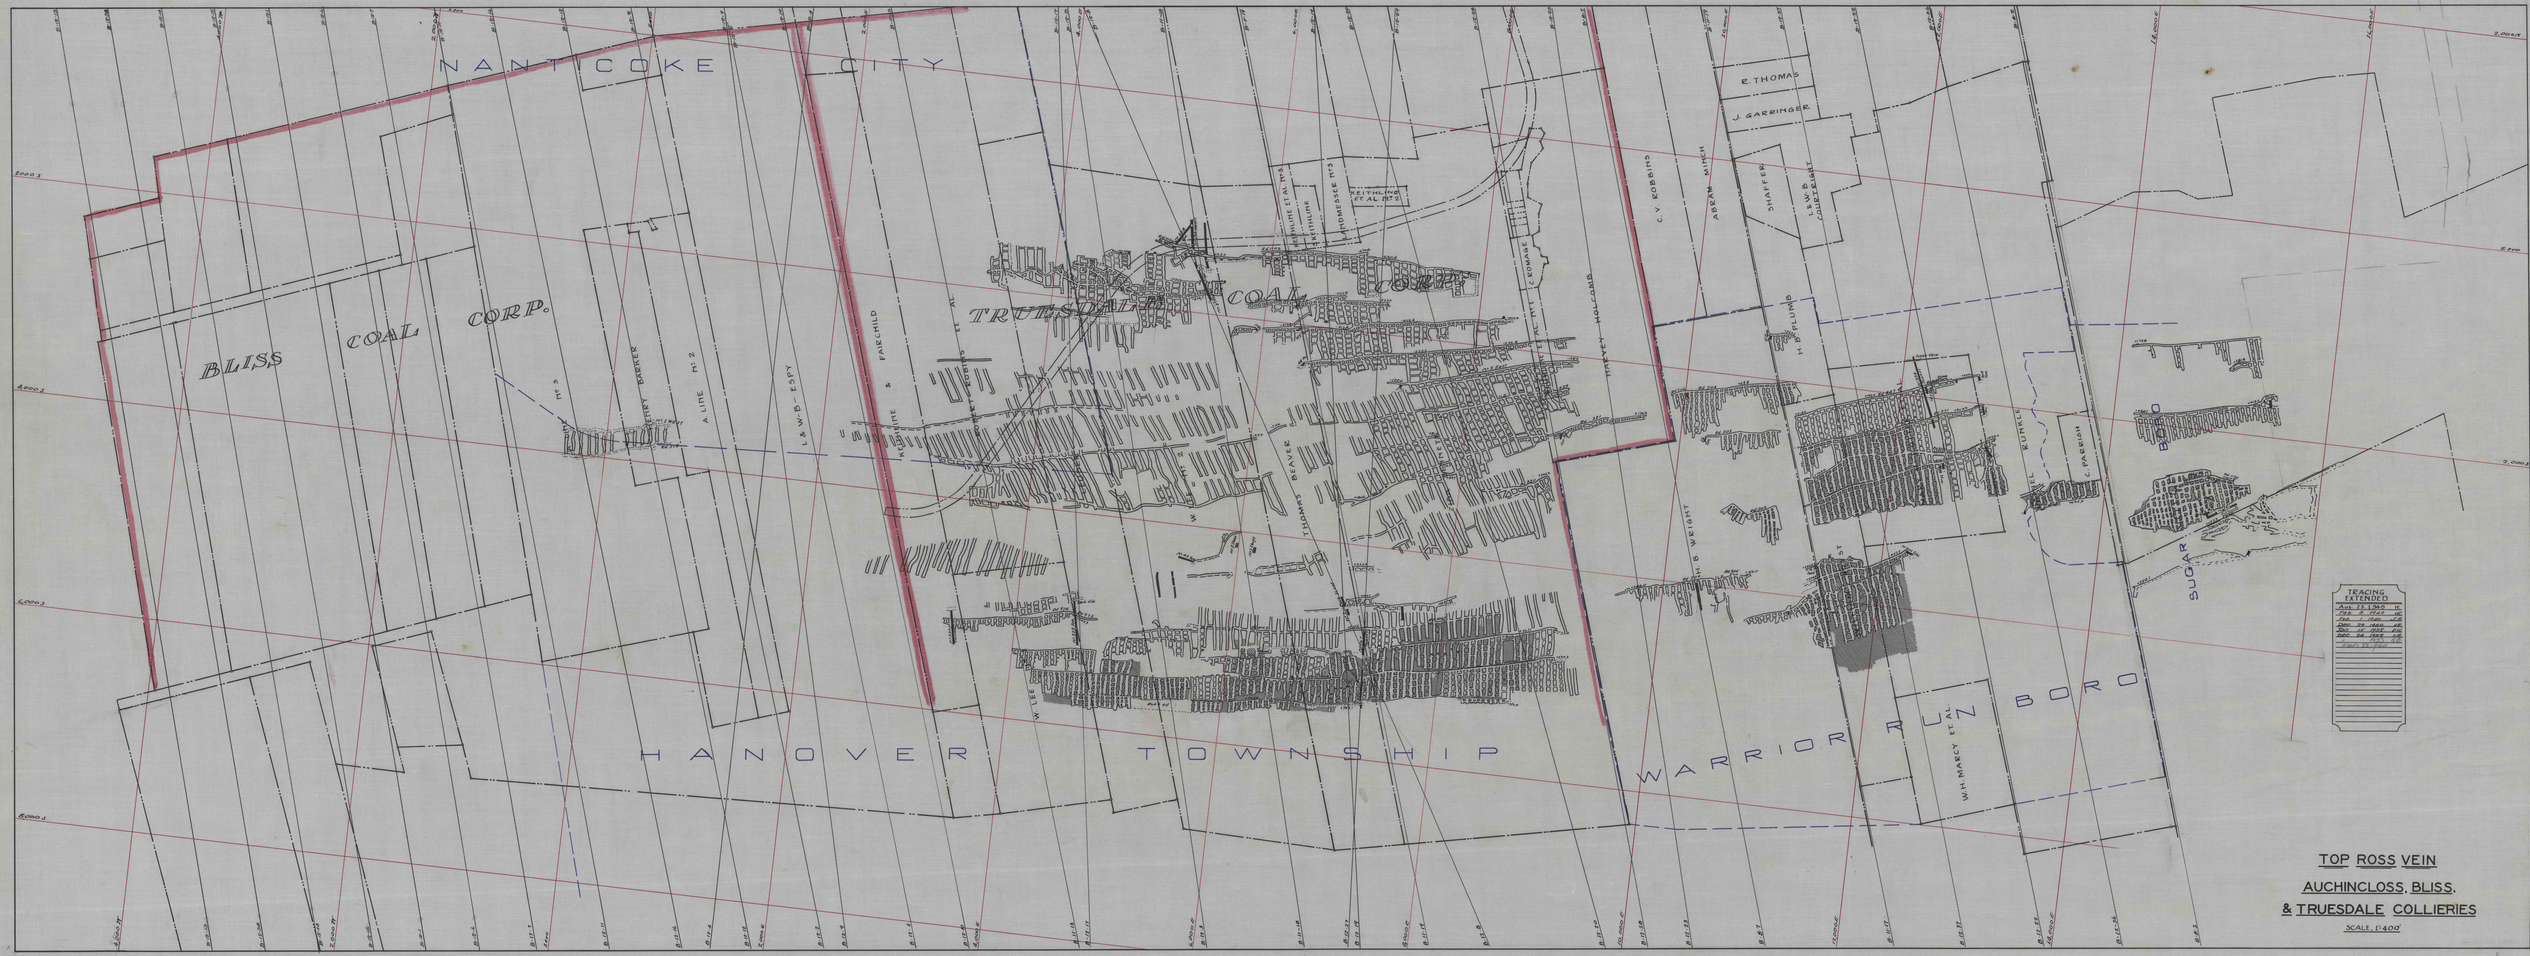

TOP ROSS VEIN

AUCHINCLOSS, BLISS, & TRUESDALE COLLIERIES

SCALE 1"=400'