


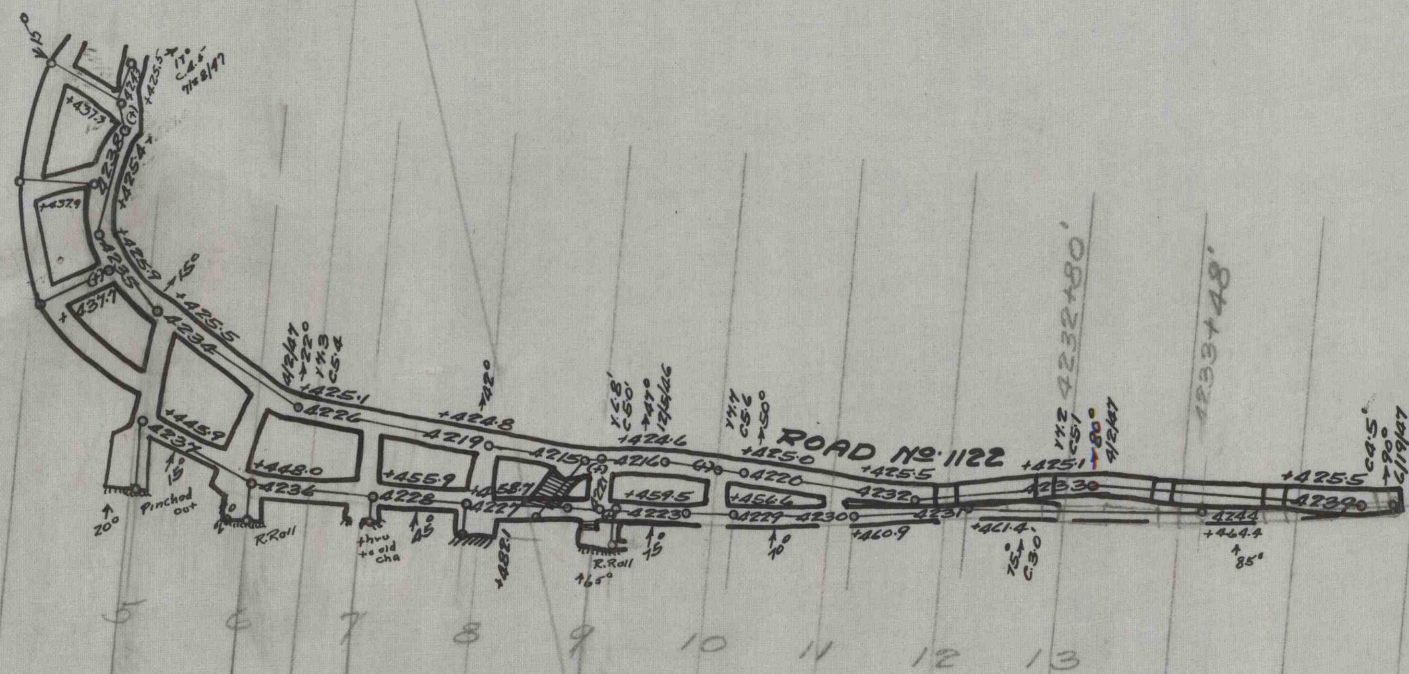

9-12-10