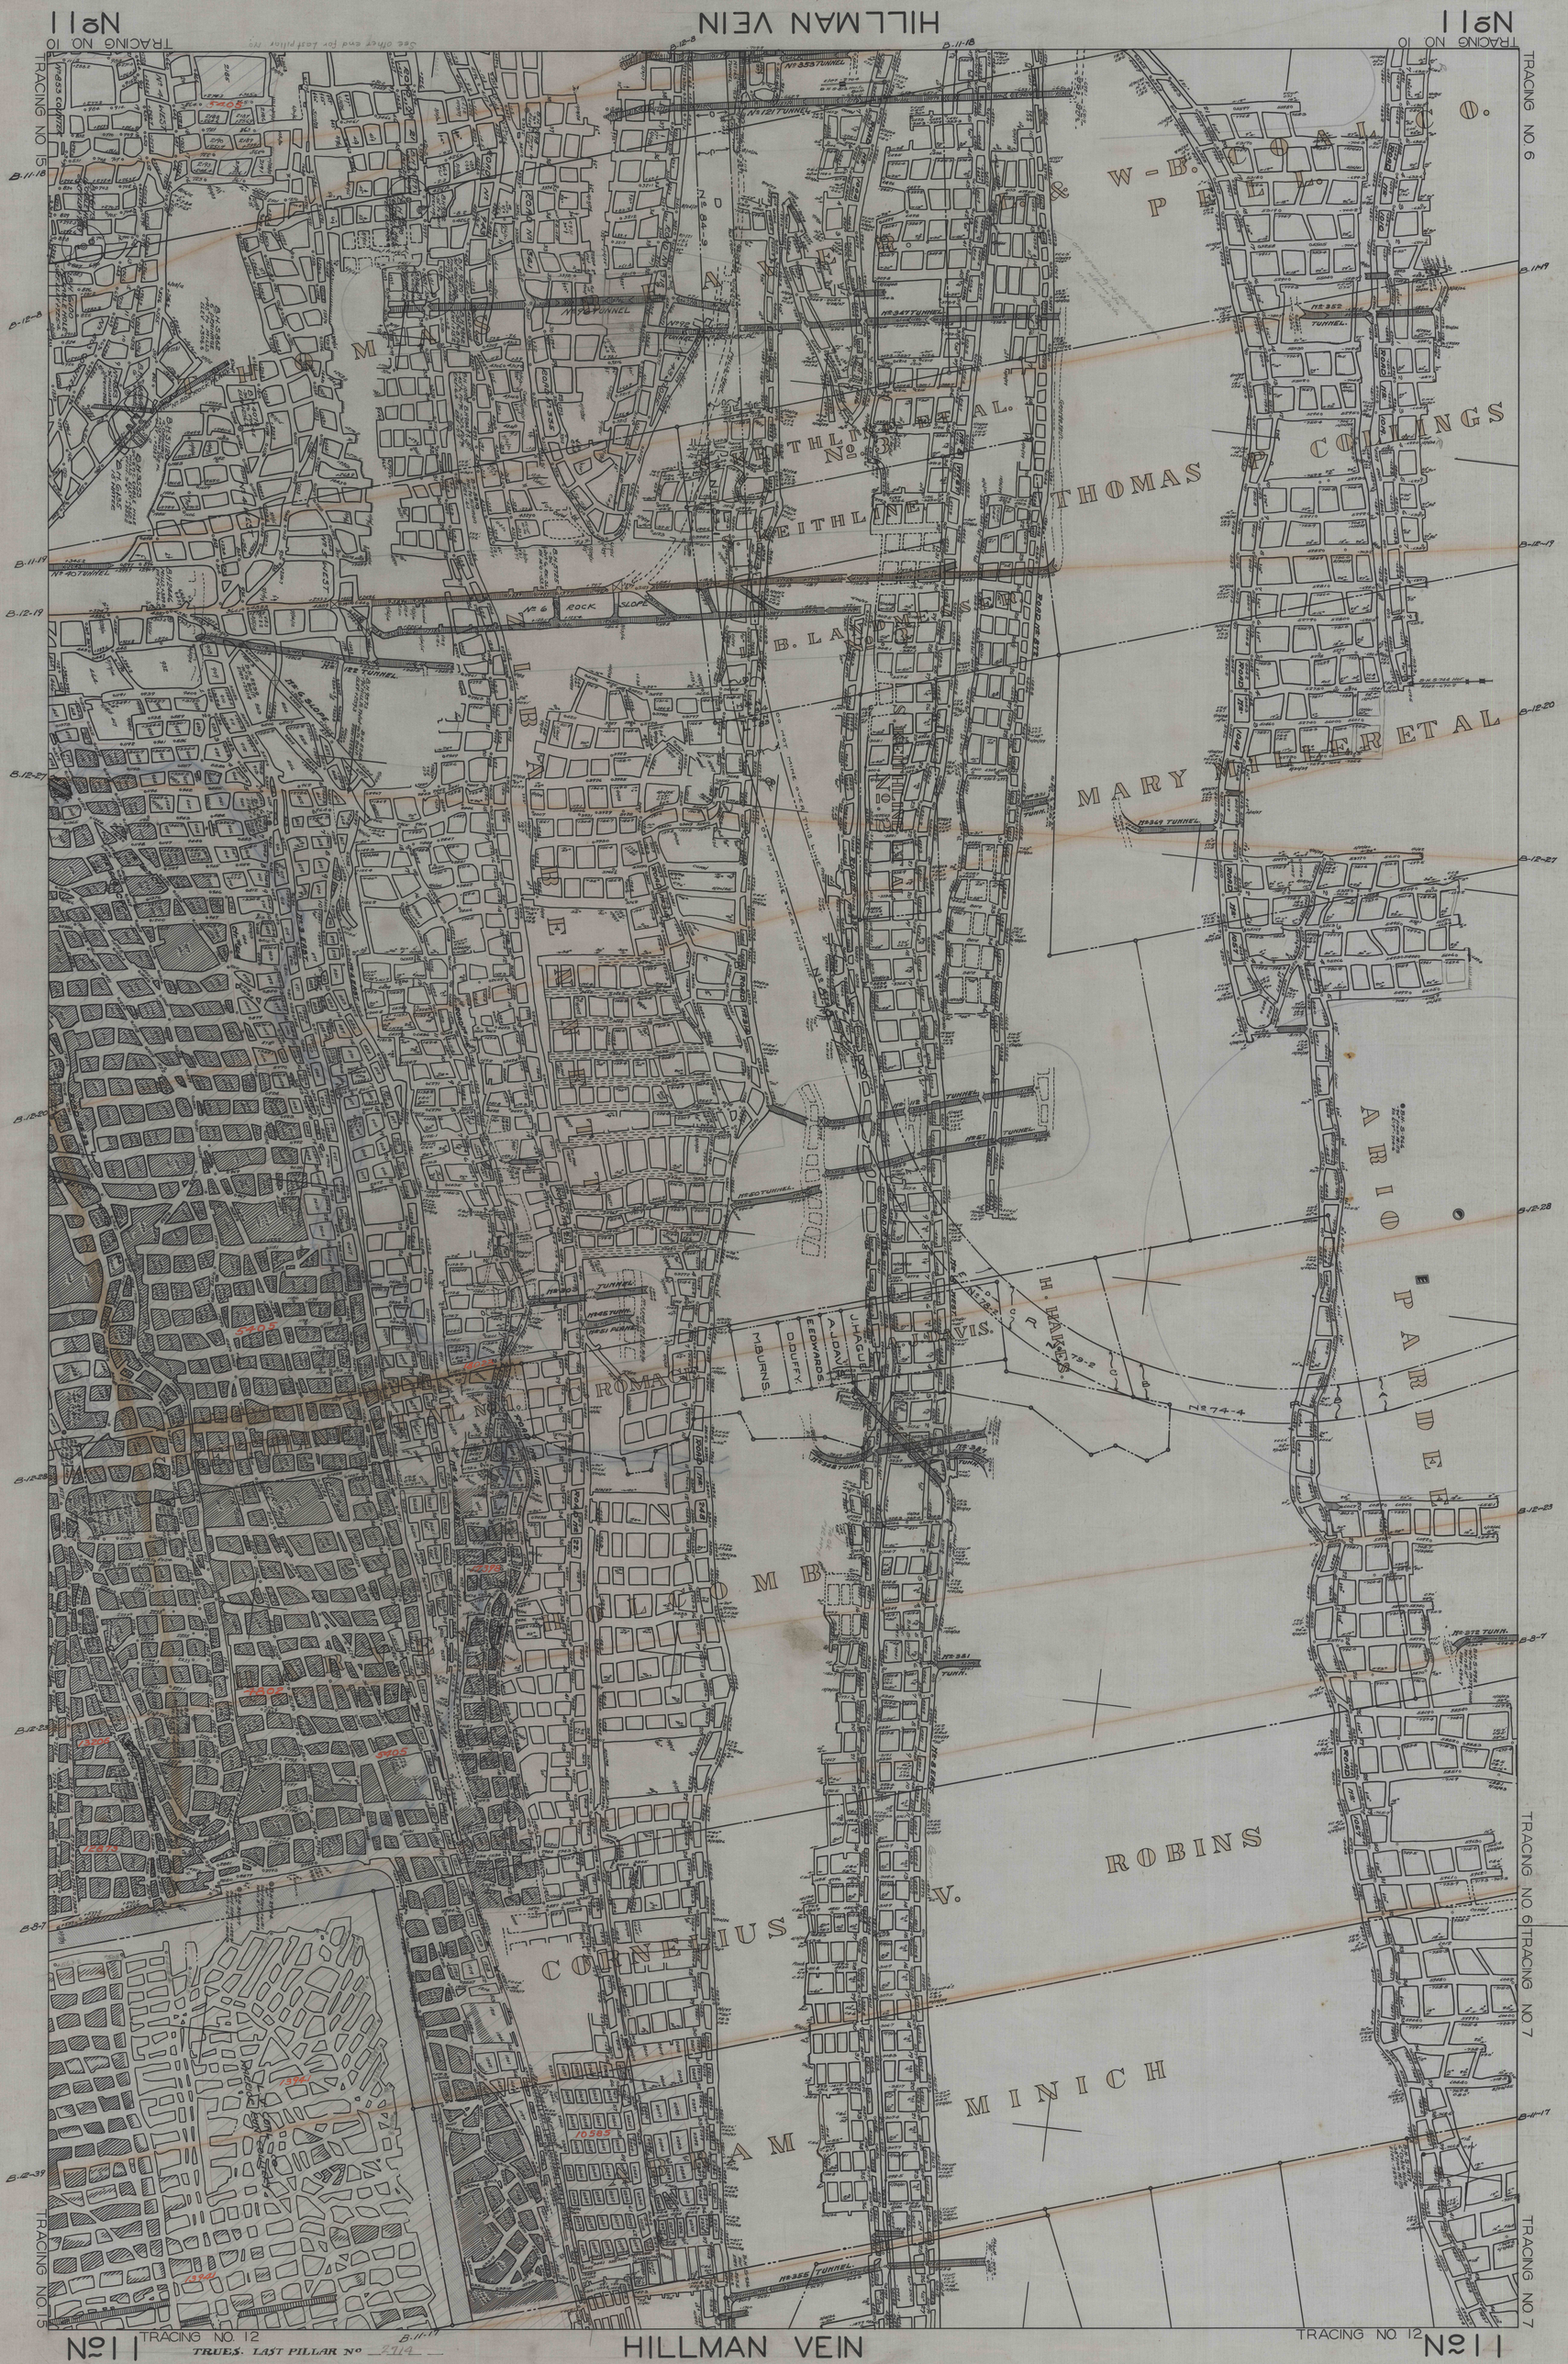

TRACING NO. 6
TRACING NO. 6
TRACING NO. 7
TRACING NO. 7
No 11
TRACING NO. 10
HILLMAN VEIN
TRACING NO. 12
TRACING NO. 15
TRACING NO. 15
W-B. COAL CO.
P. & L.
CUMMINGS
THOMAS
MARY
THOMAS
ET AL.
ARIO PARDEE
ROBINS
MINICH
CORNELIUS
H. HAKES
J. HAGUE
A. J. DAVIS
E. EDWARDS
D. DUFFY
M. BURNS
No 74-4
No 79-2
No 78-2
KEITHLINE ET AL. No. 2
KEITHLINE No 3
B. LANDMESSER
BENNETT
M. BENNETT
ROAD No 1010
ROAD No 1019
ROAD No 1049
ROAD No 1057
ROAD No 872
No 8 WEST
No 8 EAST
ROAD No 1004
ROAD No 336
ROAD No 337
ROAD No 314
ROAD No 315
ROAD No 318
ROAD No 335
ROAD No 341
ROAD No 943
ROAD No 21
ROAD No 248
ROAD No 22
ROAD No 1115
ROAD No 1114
ROAD No 33
No 4 EAST
No 3 EAST
No 5 WEST
No 4 WEST
No 853 COUNTER
No 853 COUNTER
No 84-9
No 83-1
No 6 SLOPE
No 6 ROCK SLOPE
No 43 SLOPE
No 352 TUNNEL
No 347 TUNNEL
No 349 TUNNEL
No 372 TUNN.
No 353 TUNNEL
No 121 TUNNEL
No 143 TUNNEL
No 92 TUNNEL
No 40 TUNNEL
No 122 TUNNEL
No 50 TUNNEL
No 30 TUNNEL
No 45 TUNN.
No 381 TUNN.
No 387 TUNN.
No 348 TUNN.
No 355 TUNNEL
No 331 TUNN.
George Vein
MILLS-VEIN
DO NOT MINE OVER THIS LINE
DO NOT MINE OVER THIS LINE
one opening No 1 Slope to No 2 slope Hillman Vn. one in Mills Vn.
See other end for Last pillar No
B.H. S-266 -90° from Mills Vn. 6'7" -714.6
B.H. S-998 -90° from No 372 Tunn. Vein 8-11" Elev. -694.7
B.H. S-1417 6" Cable Hole -38° from Mills Elev. -787.5
B.H. S-934 Hor. Elev. -257.5
B.H. 5725 -90° No 6 RK. SL. Vn. 14'0" -53.8
B.H. 5810 Hor. to Hillman Elev. -6.1
B.H. 9520 90° CABLE HOLE
B.H. 9843 -45° to Forge Elev. -7.7
B.H. 10102 -45° to Forge Elev. -6.4
B.H. 9573 -90° Hill to Twin Elev. +239.3
B.H. 8240 -90° to Bott. Elev. +222.5
B.H. 8239 -90° to Bott. Elev. +281.4
B.H. 4078 -90° to Forge Elev. +236.2
B.H. 5862 6" DRAINAGE +45° to MILLS ELEV +306.6
B.H. 5112 4" DRAINAGE
B.H. 9553 90° 8" C. CABLE HOLE
B.H. 6135 18" WATER
B.H. 2446 MILLS +389.8
B.H. 6173 6" CABLE HOLE SURF. ELEV. +729.9
B.H. 6100 6" CABLE HOLE SURF. ELEV. +725.4
B.H. 2994 Surf. Elev. +615.1
B.H. 3007 Surf. Elev. +622.9
Ctr. No 506
CTR. No 509
CTR. No 508
CTR. No 854
L. V. COAL CO. WARRIOR RUN COLLIERY
5405
5405
11037
12398
10585
7807
13206
12873
13941
13941
Abbott
Re-run
Tie ok No 8 E. & No 7 E.
TRUES. LAST PILLAR No 2714
B.11-18
B.12-8
B.11-19
B.12-19
B.12-20
B.12-27
B.12-28
B.12-23
B.8-7
B.11-17
B.12-39
B.11-11