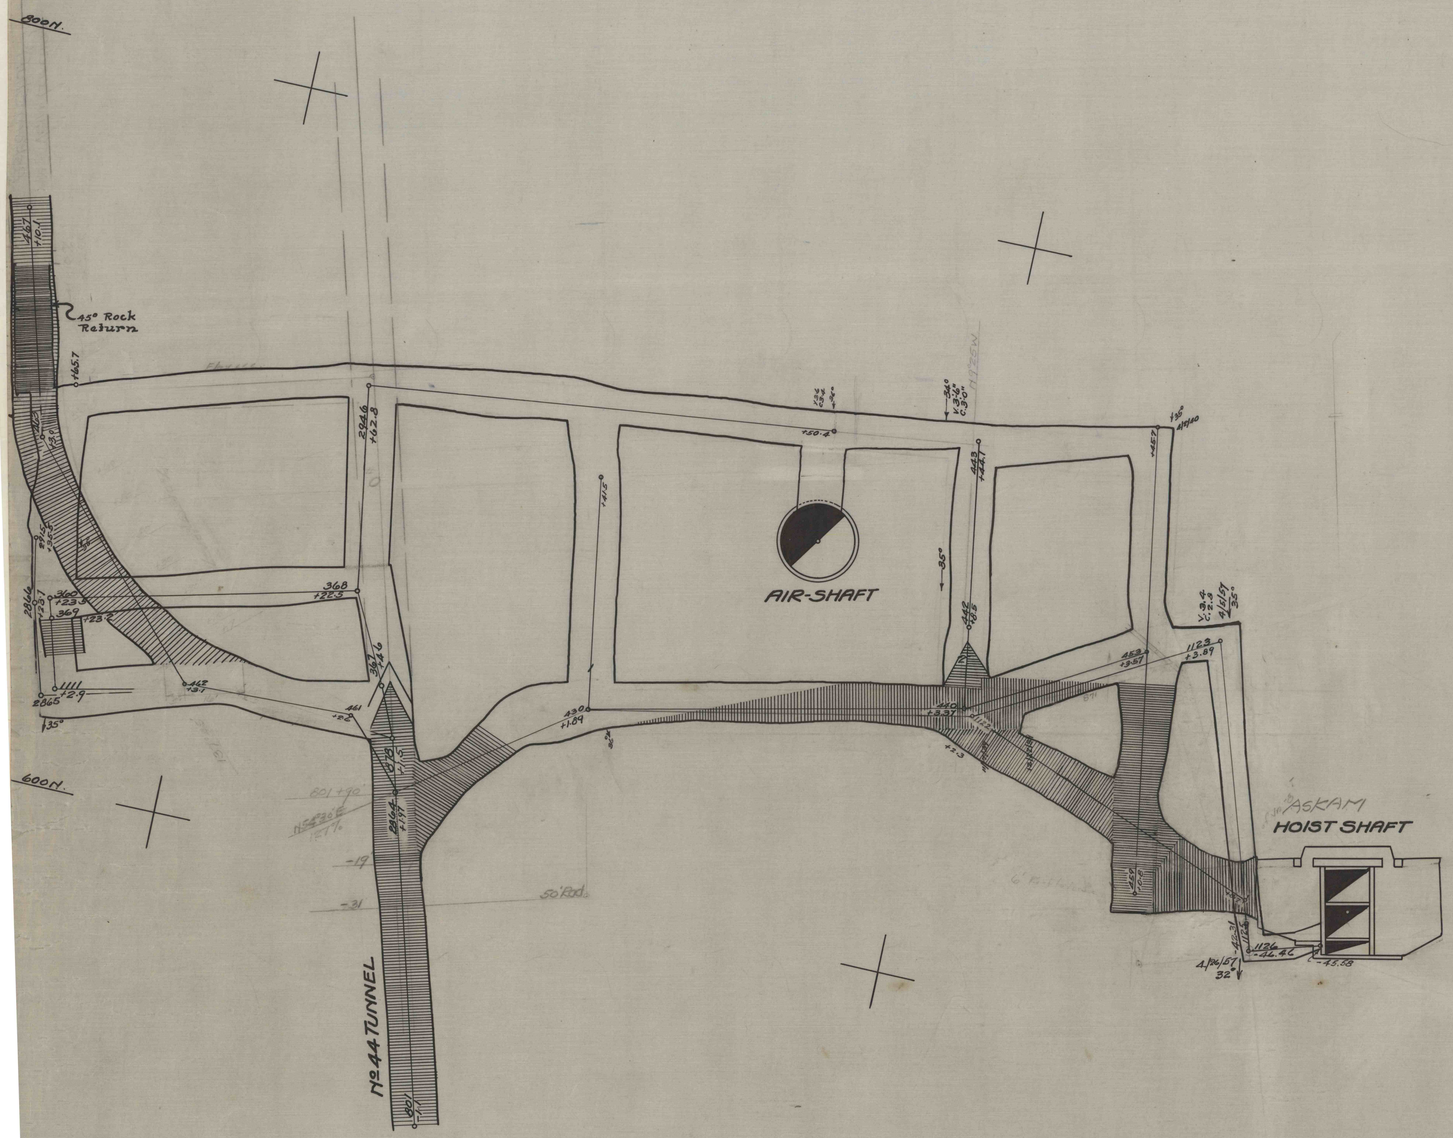

No. 5 VEIN LANDING
ASKAM SHAFT
TRUESDALE COLLIERY
SCALE 1" = 20' MAY 1935.

7800E.

8000E.

8200E.