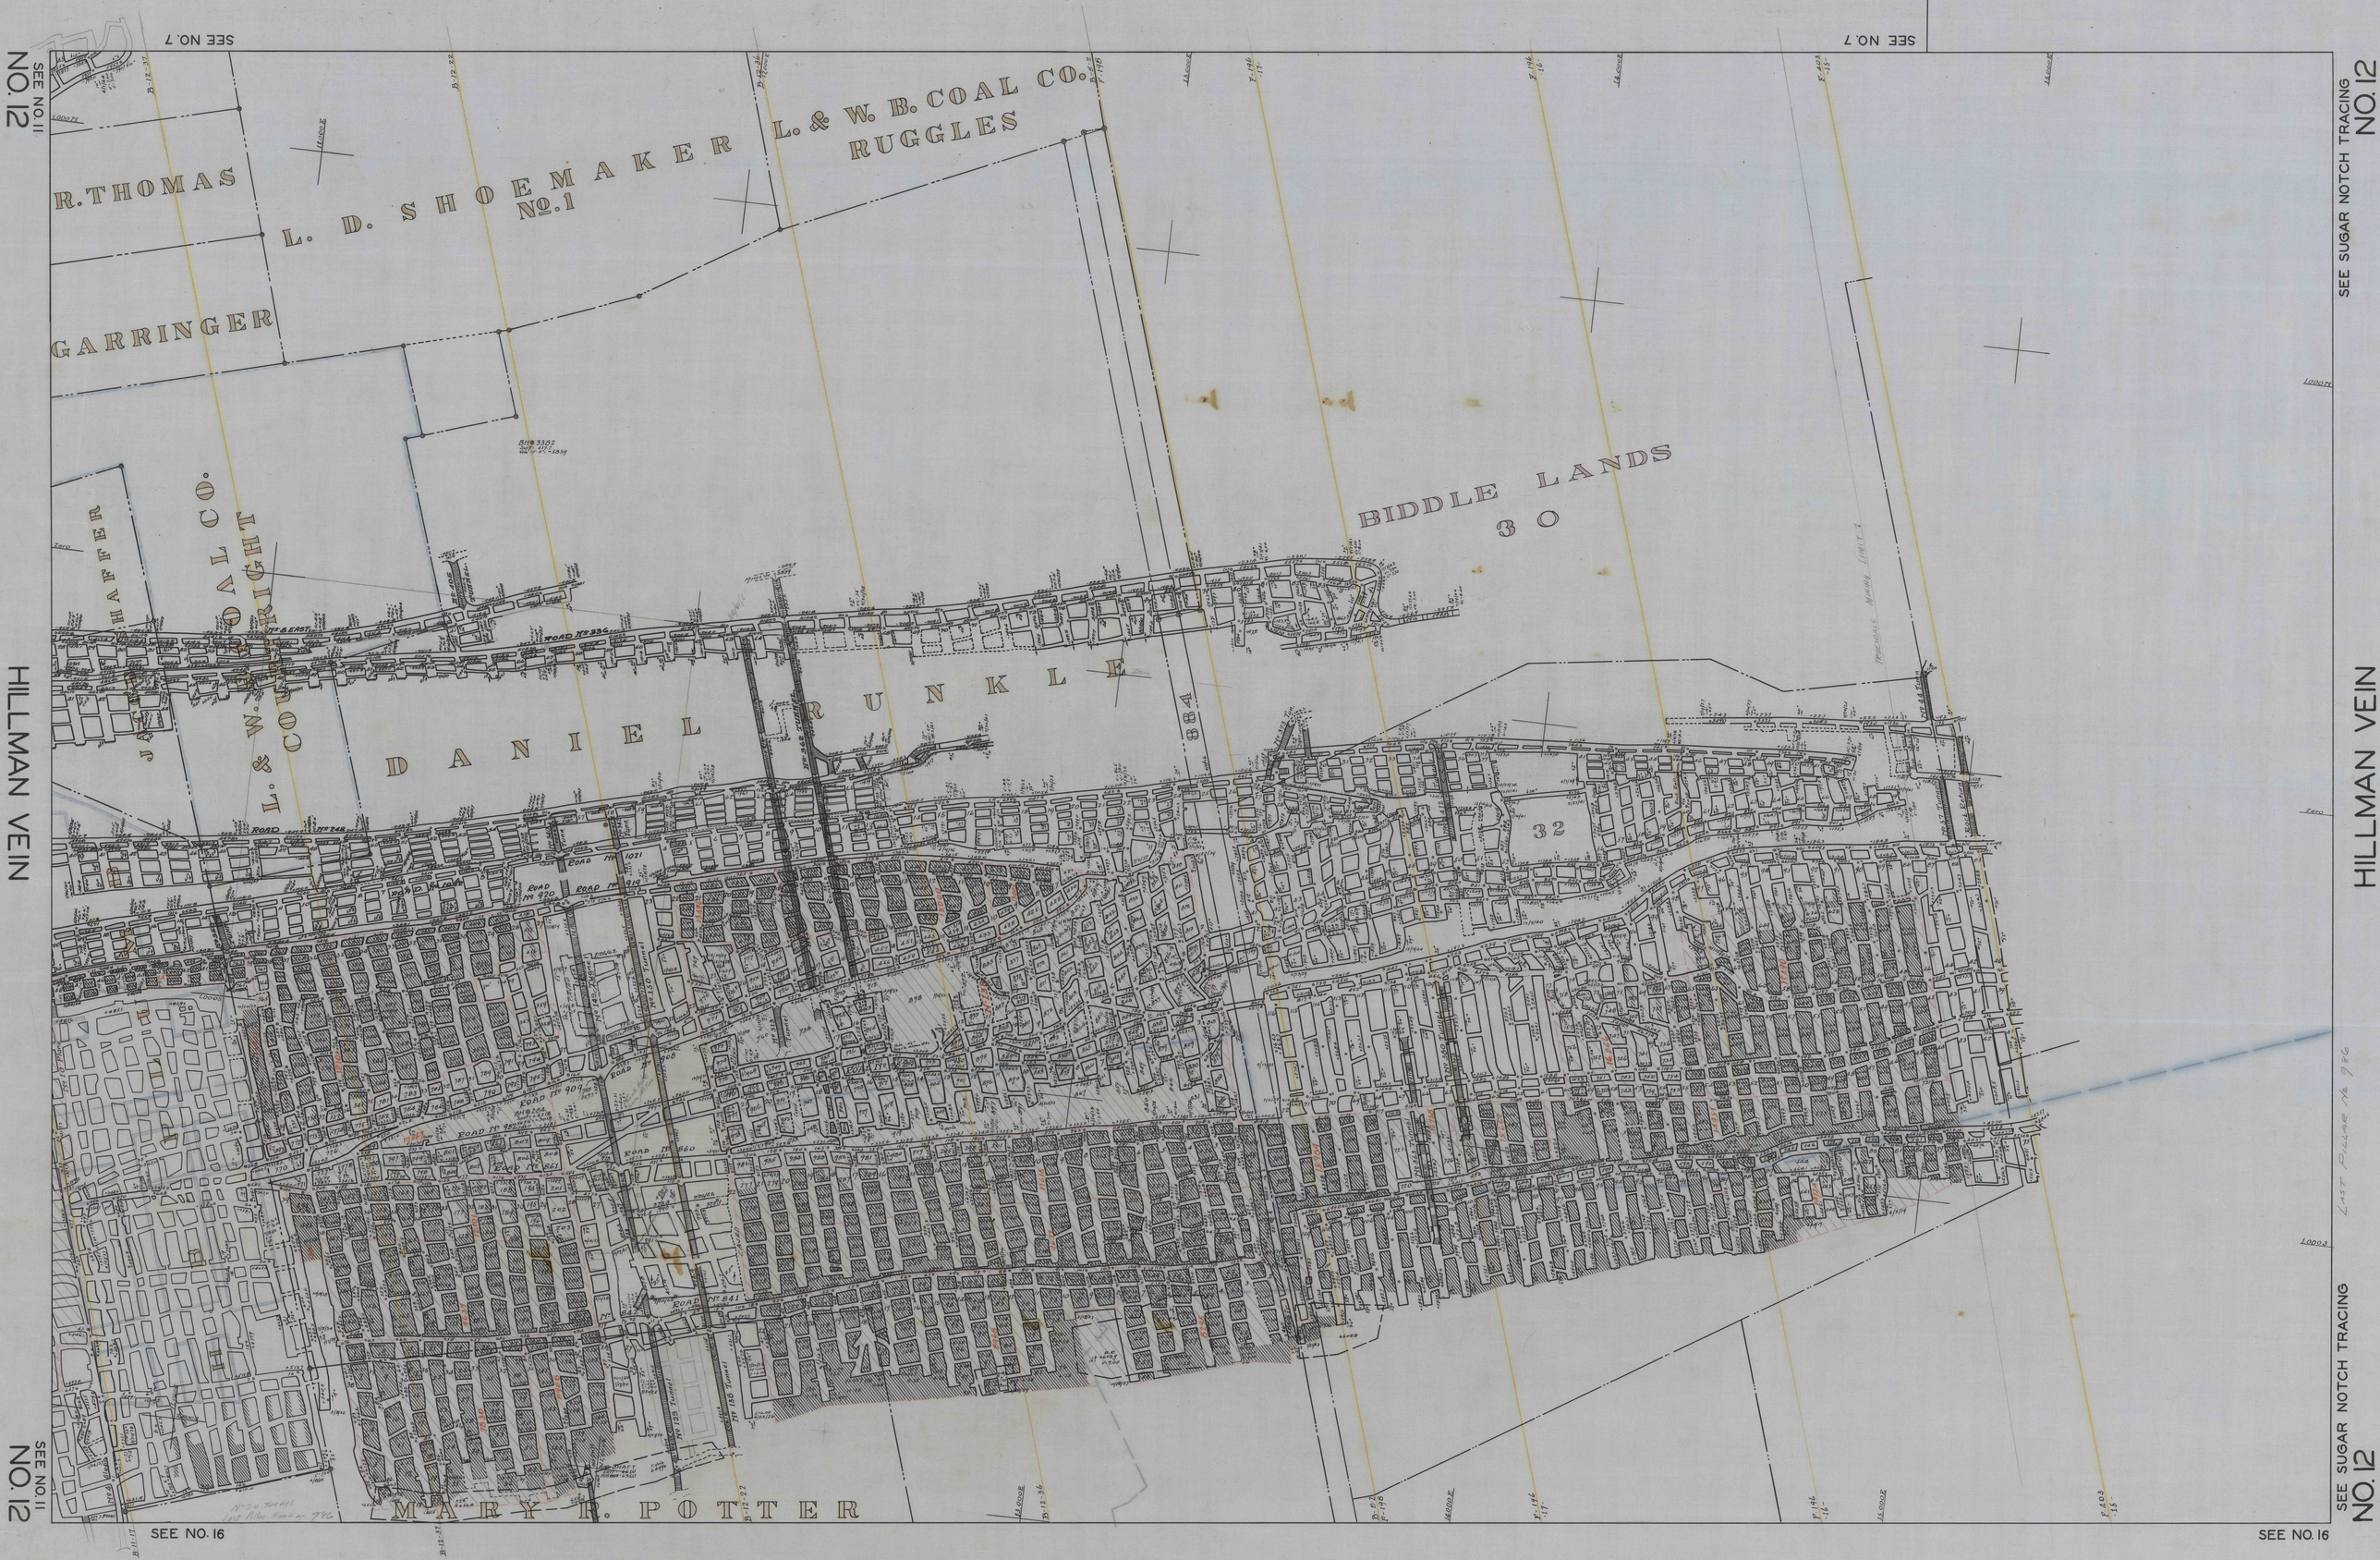
SEE NO. 7
SEE NO. 7
SEE NO. 11
NO. 12
HILLMAN VEIN
SEE NO. 11
NO. 12
SEE SUGAR NOTCH TRACING
NO. 12
HILLMAN VEIN
SEE SUGAR NOTCH TRACING
NO. 12
SEE NO. 16
SEE NO. 16
R. THOMAS
GARRINGER
L. D. SHOEMAKER
No. 1
L. & W. B. COAL CO.
RUGGLES
HAFFER
L. & W. B. COAL CO.
RIGHT
DANIEL RUNKLE
BIDDLE LANDS
30
32
884
MARY R. POTTER