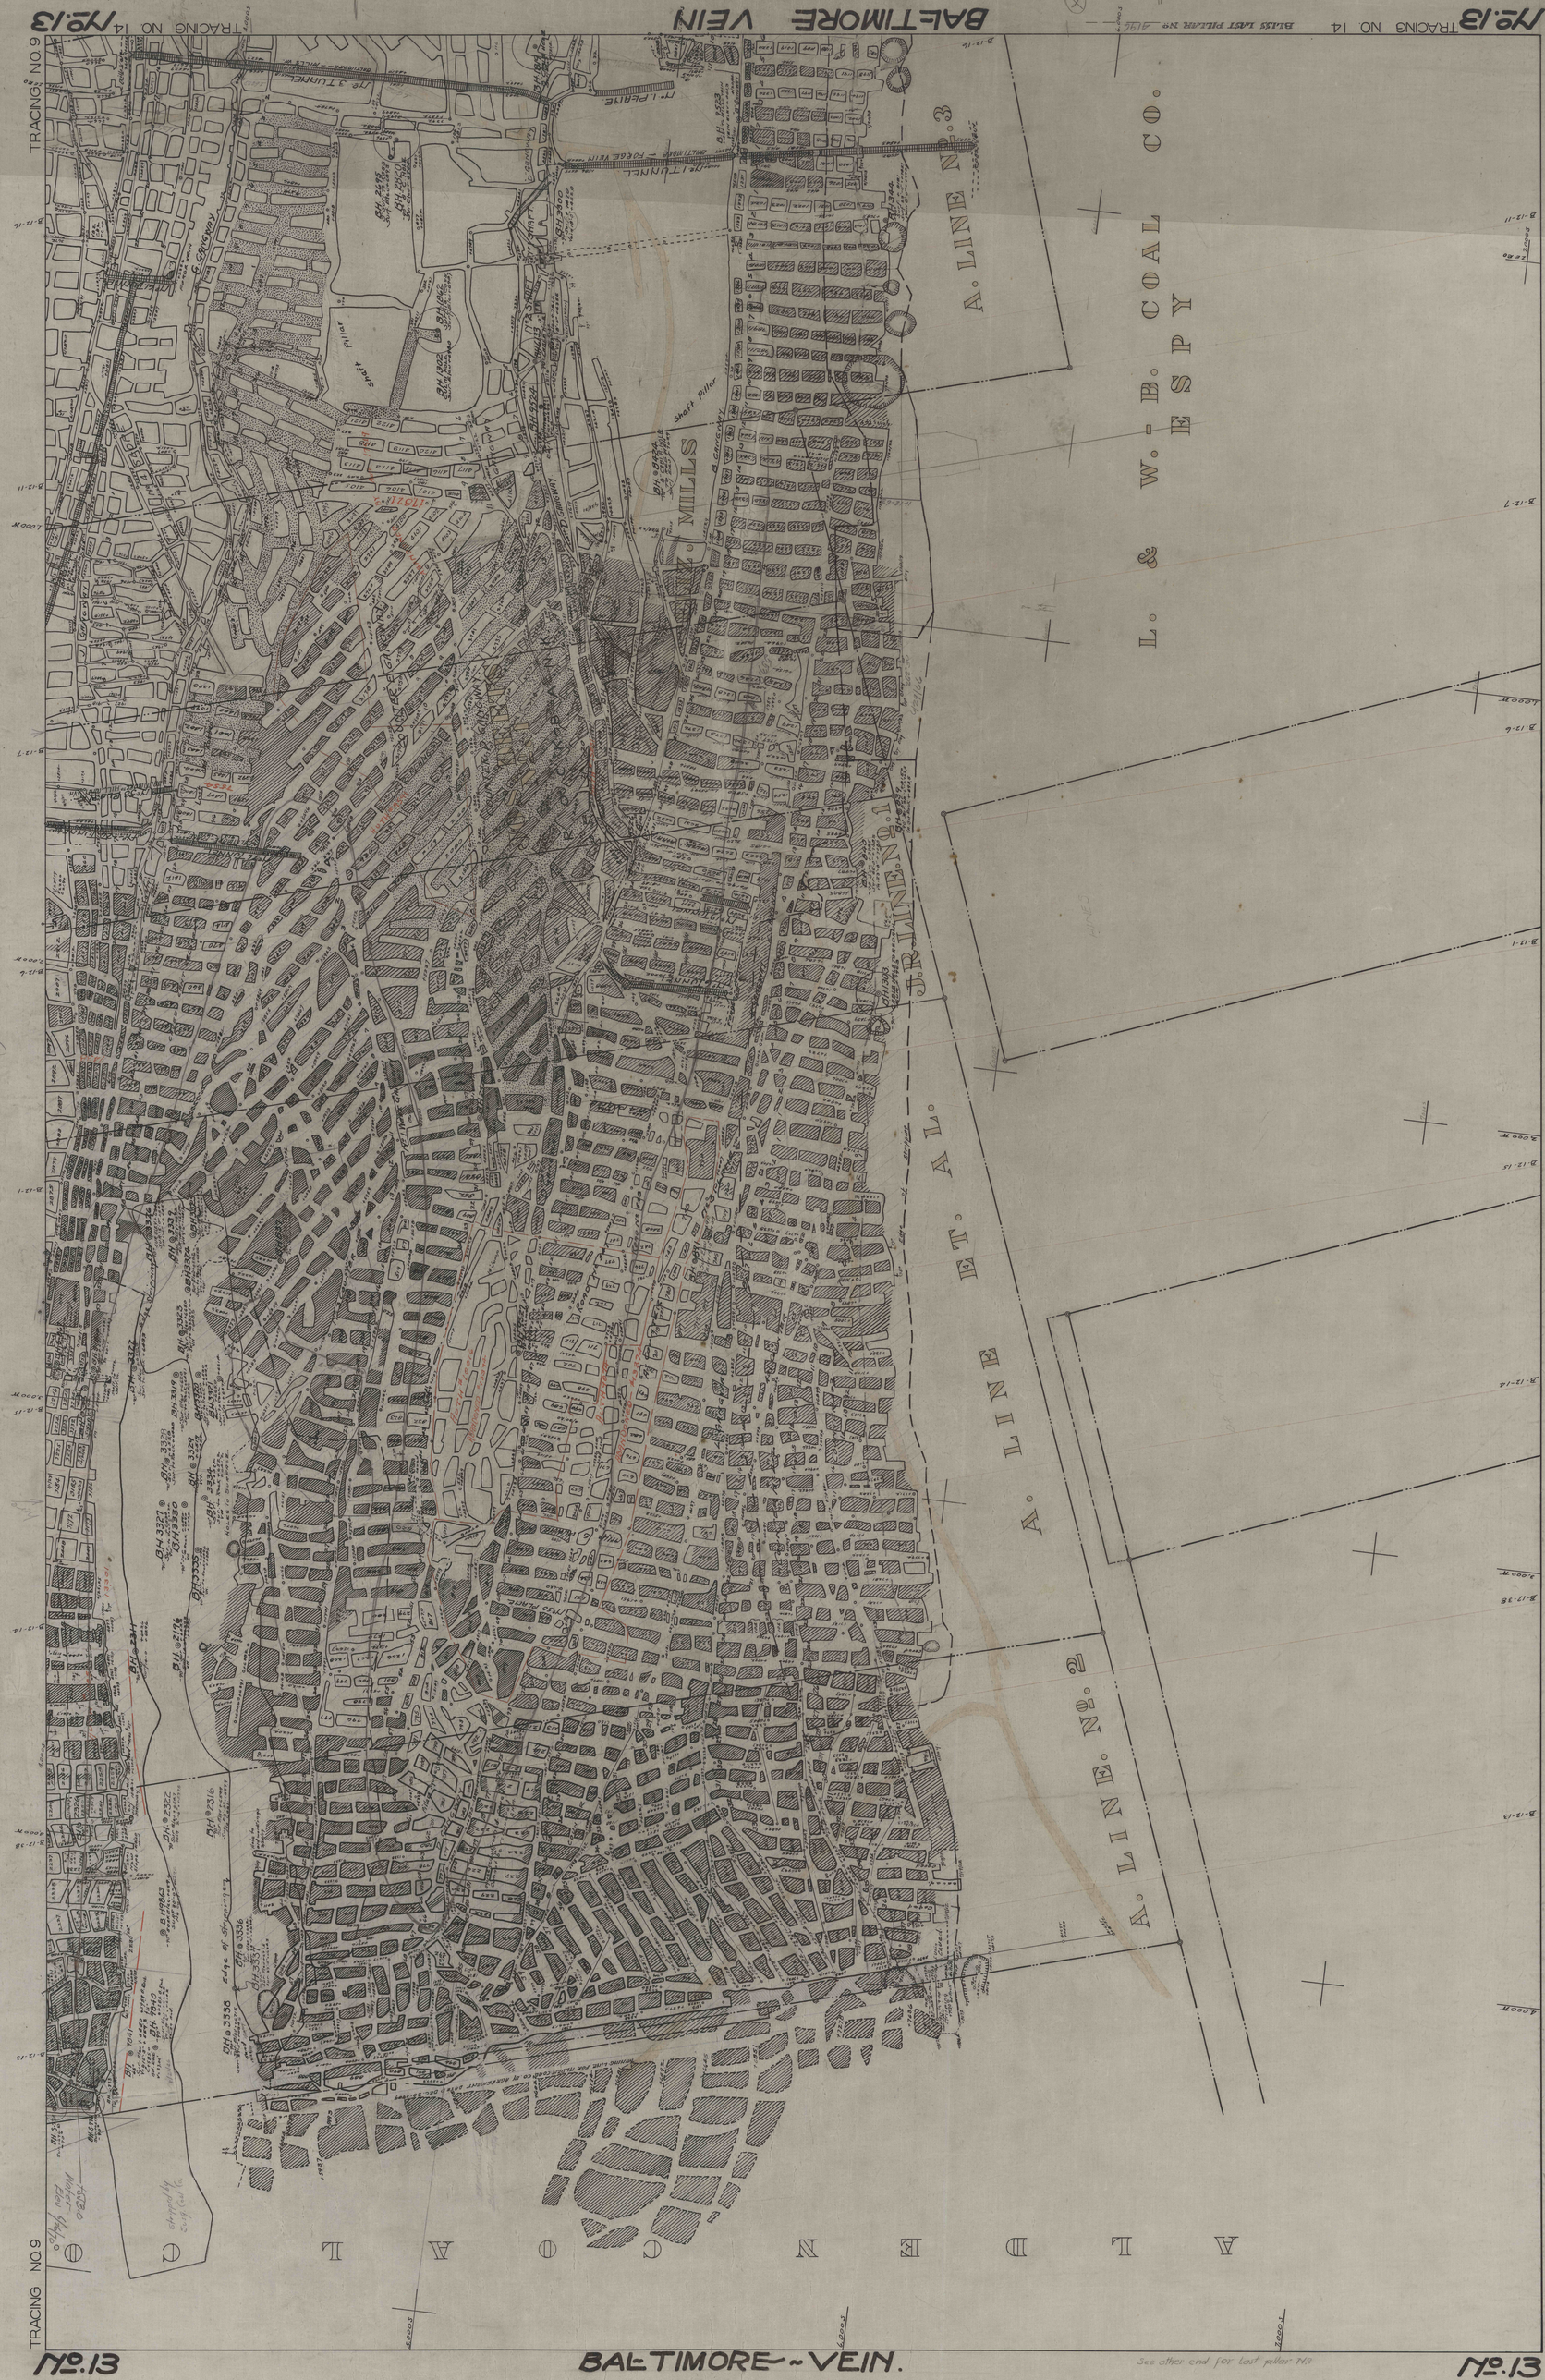

TRACING NO 9
No 13
BALTIMORE VEIN
TRACING NO 14
No 13
A. LINE N.3
L. & W. - B. COAL CO.
ESPY
MILLS
J.R. LINE N.1
A. LINE ET. AL.
A. LINE. N.2
ALDEN COAL
BALTIMORE ~ VEIN.
See other end for last pillar #49