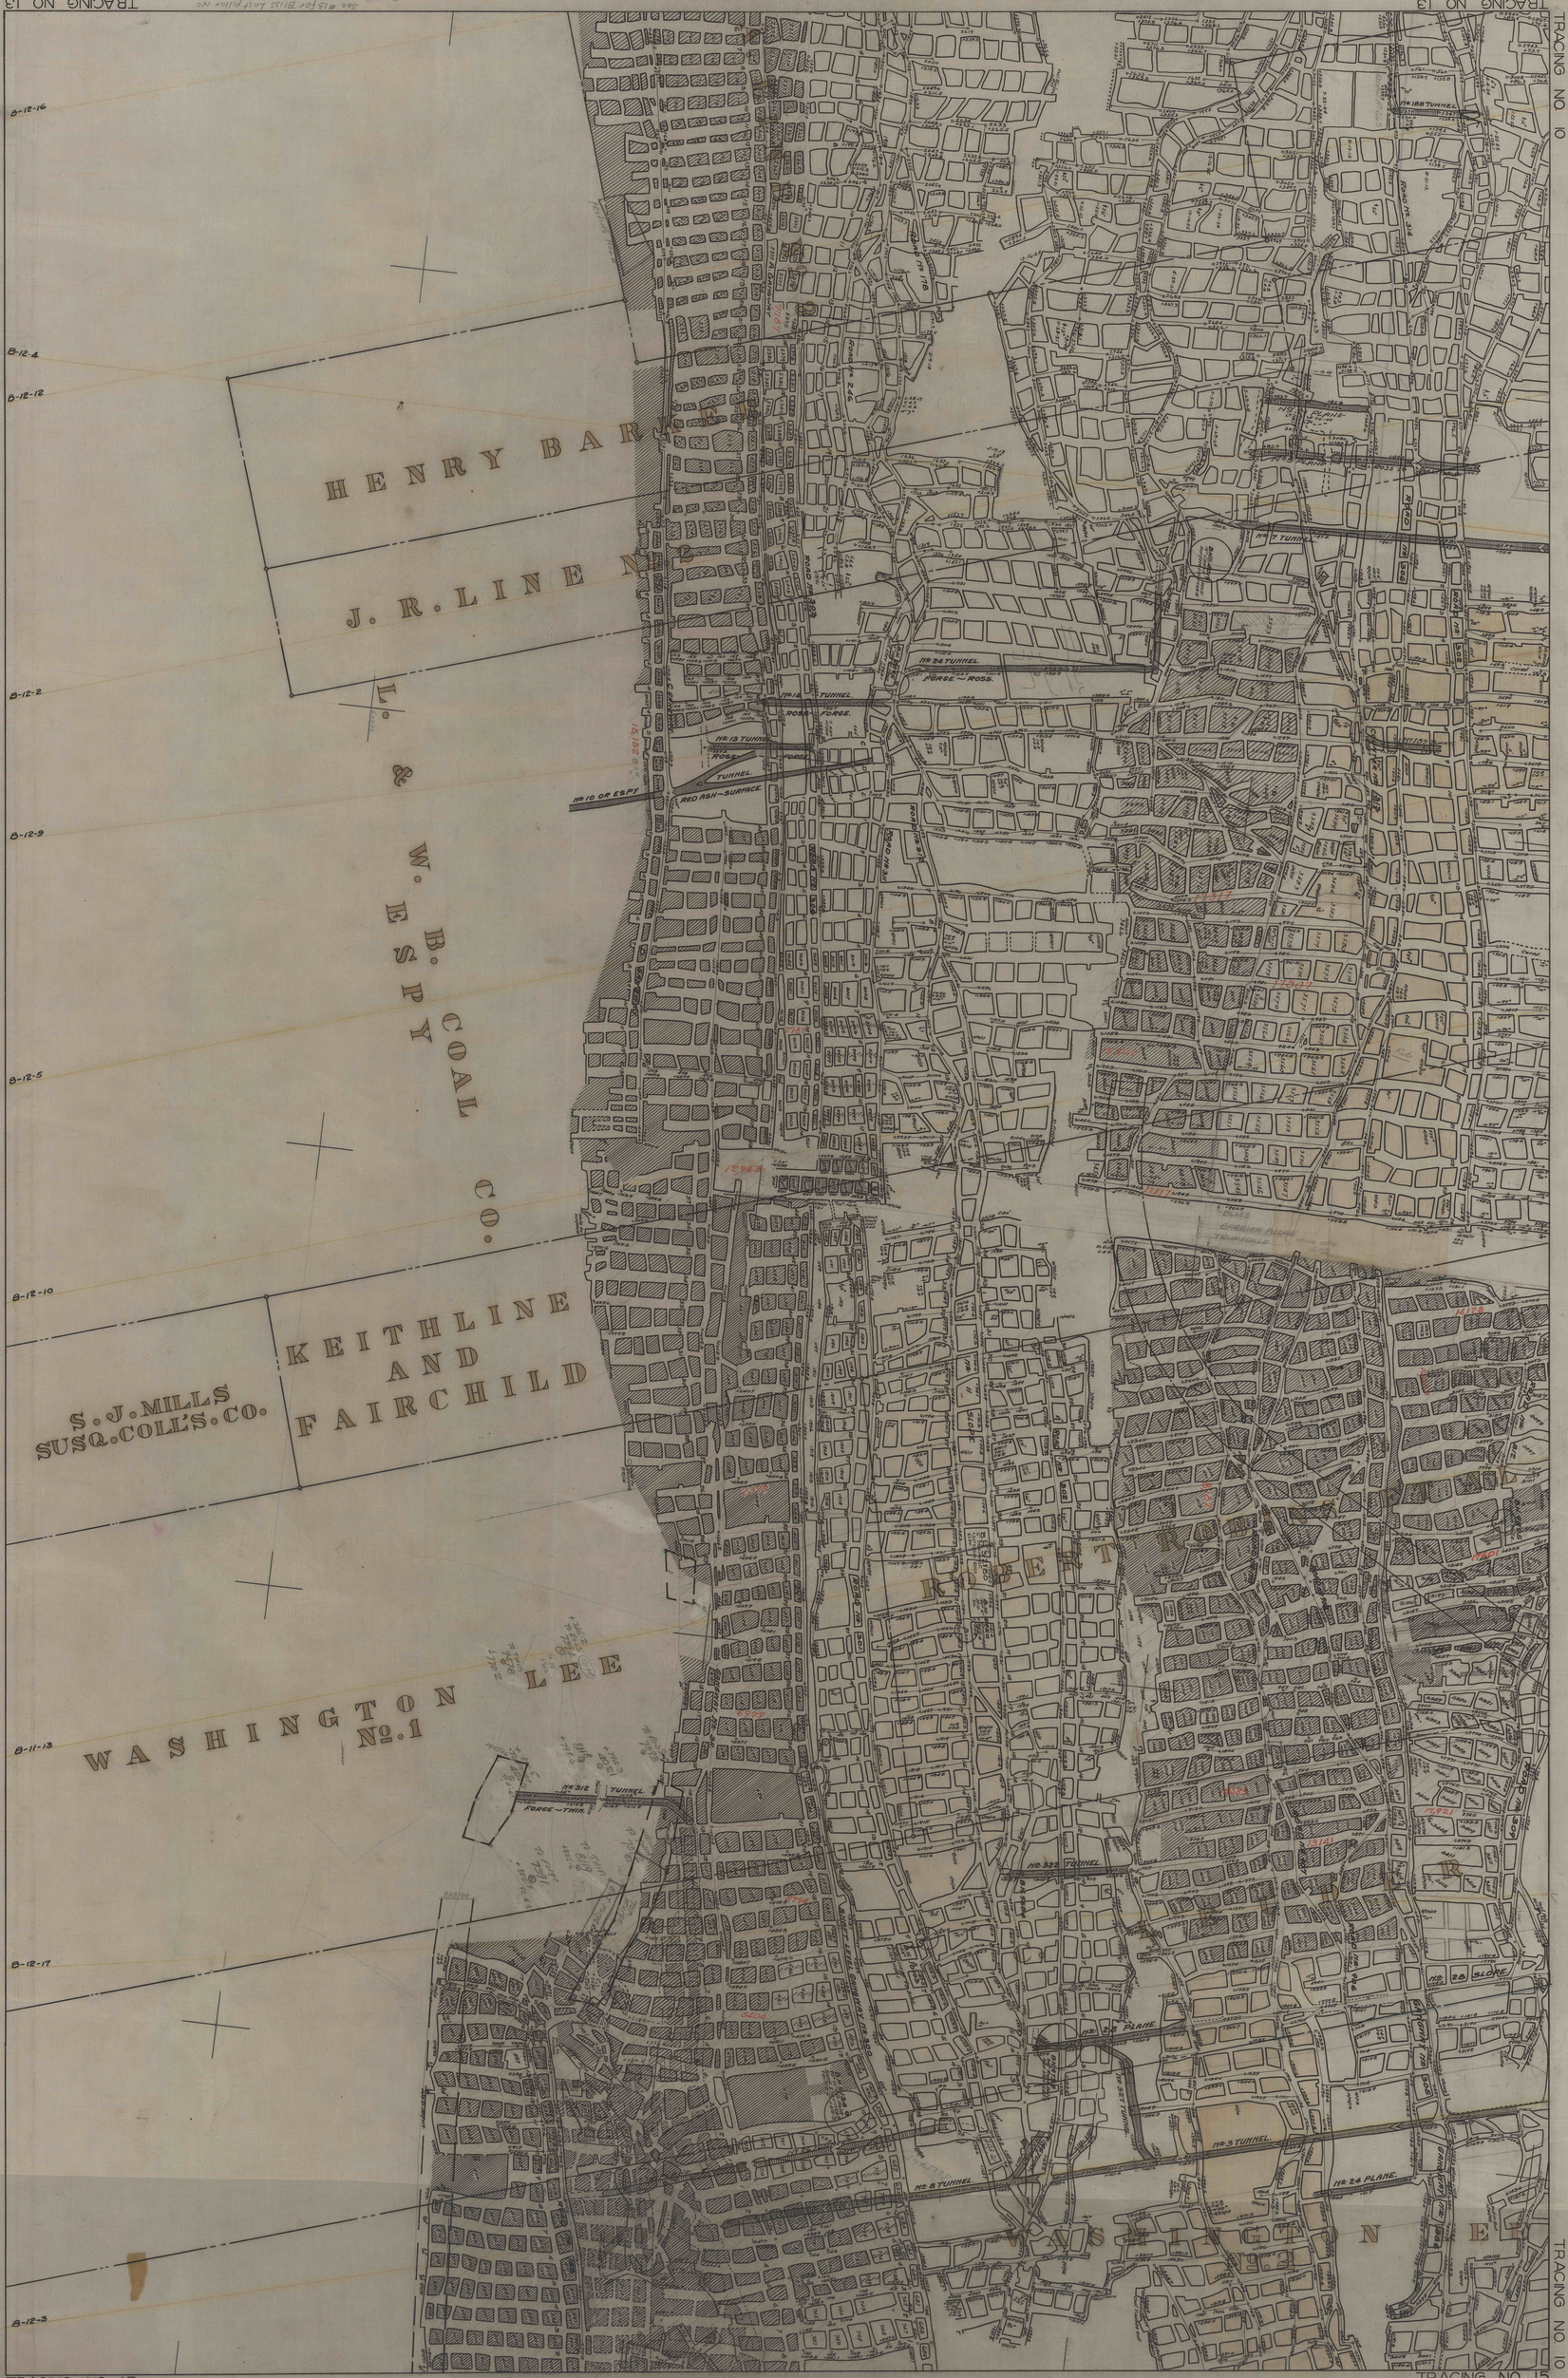

HENRY BARNES
J. R. LINE NO. 2
L. & W. B. ESPY COAL CO.
KEITHLINE AND FAIRCHILD
S. J. MILLS SUSQ. COLL'S. CO.
WASHINGTON LEE No. 1
ROBERT
B-12-16
B-12-4
B-12-12
B-12-2
B-12-9
B-12-5
B-12-10
B-11-13
B-12-17
B-12-3
No. 24 TUNNEL
FORGE - ROSS.
No. 14 TUNNEL
ROSS - FORGE.
No. 13 TUNNEL
ROSS TUNNEL
No. 10 OR ESPY
RED ASH - SURFACE
No. 312 TUNNEL
FORGE - THIS.
No. 322 TUNNEL
No. 8 TUNNEL
No. 3 TUNNEL
No. 24 PLANE
No. 25 SLOPE