


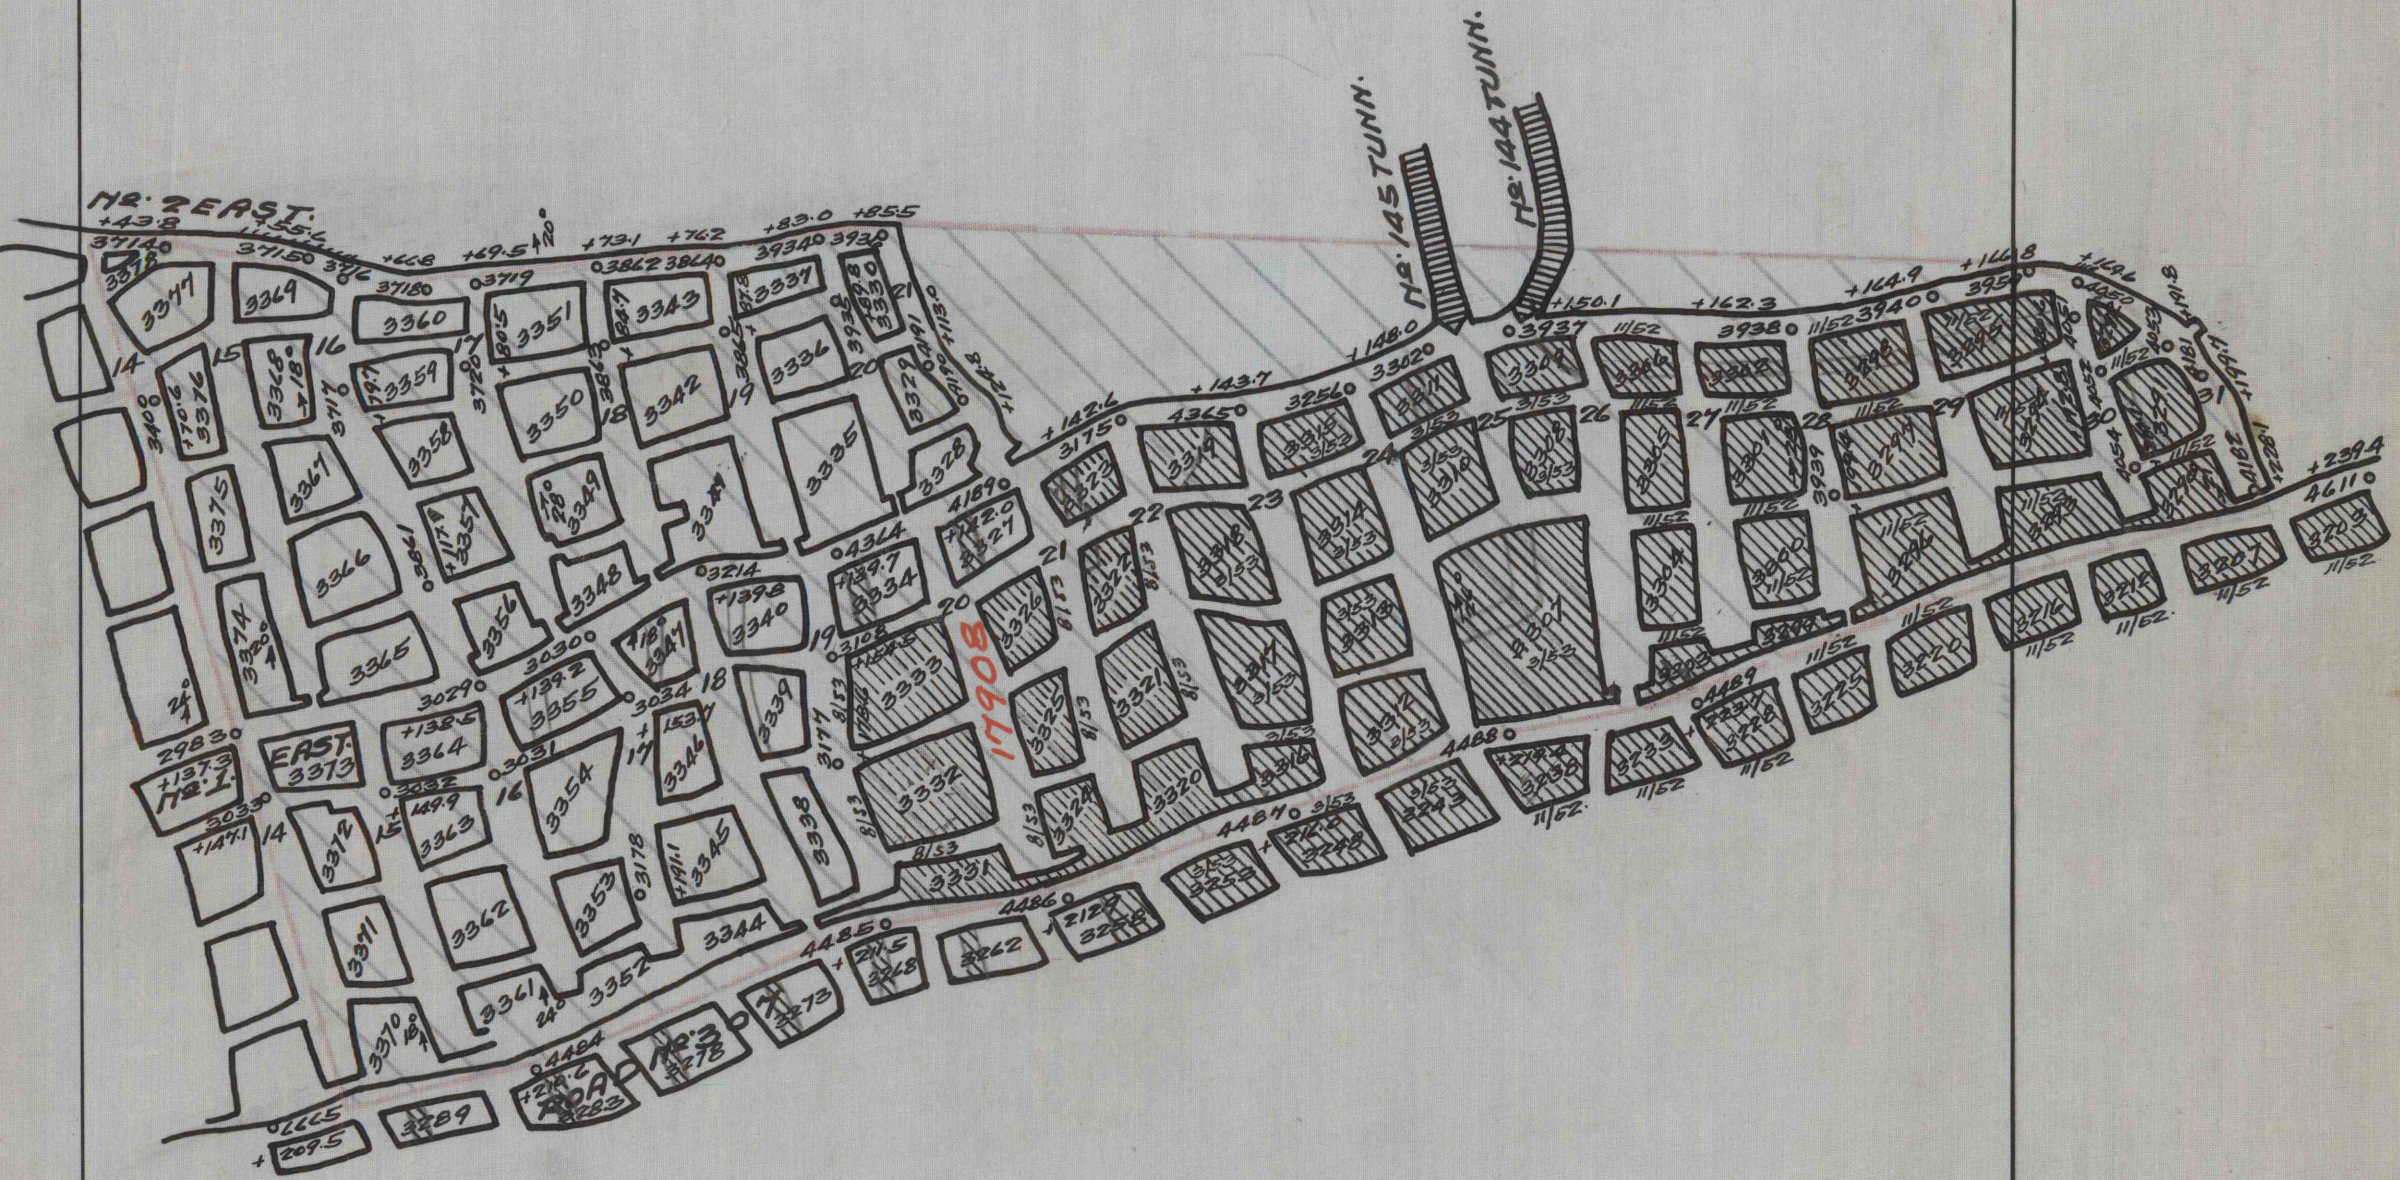

FORGE YEIN UNDERLAP