NO. 5

TRUESDALE COLLIERY
NO. 20 TUNNEL SECTION
FRESH WATER LINES TRACING
SCALE 1"=50'

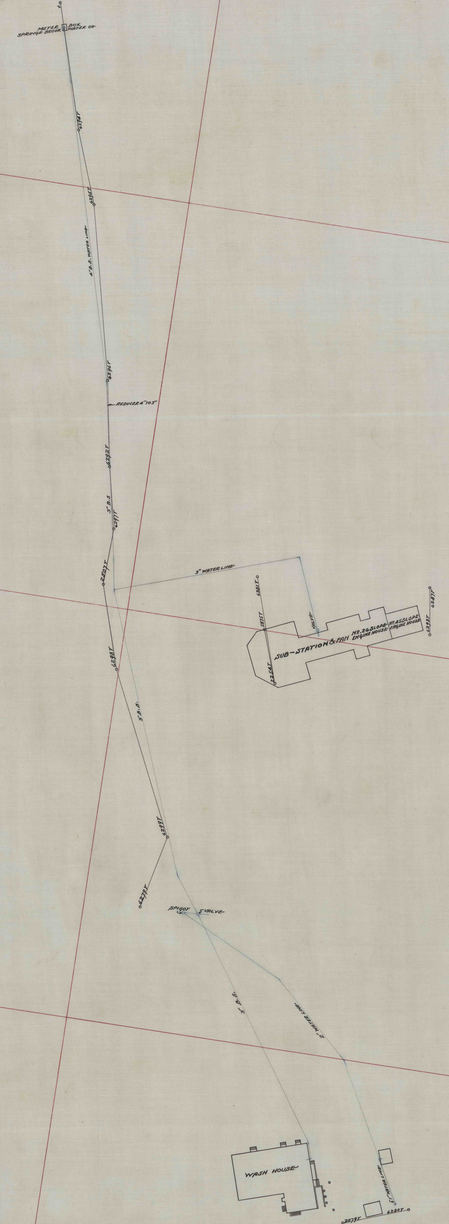

NO. 5

TRUESDALE COLLIERY
NO. 20 TUNNEL SECTION