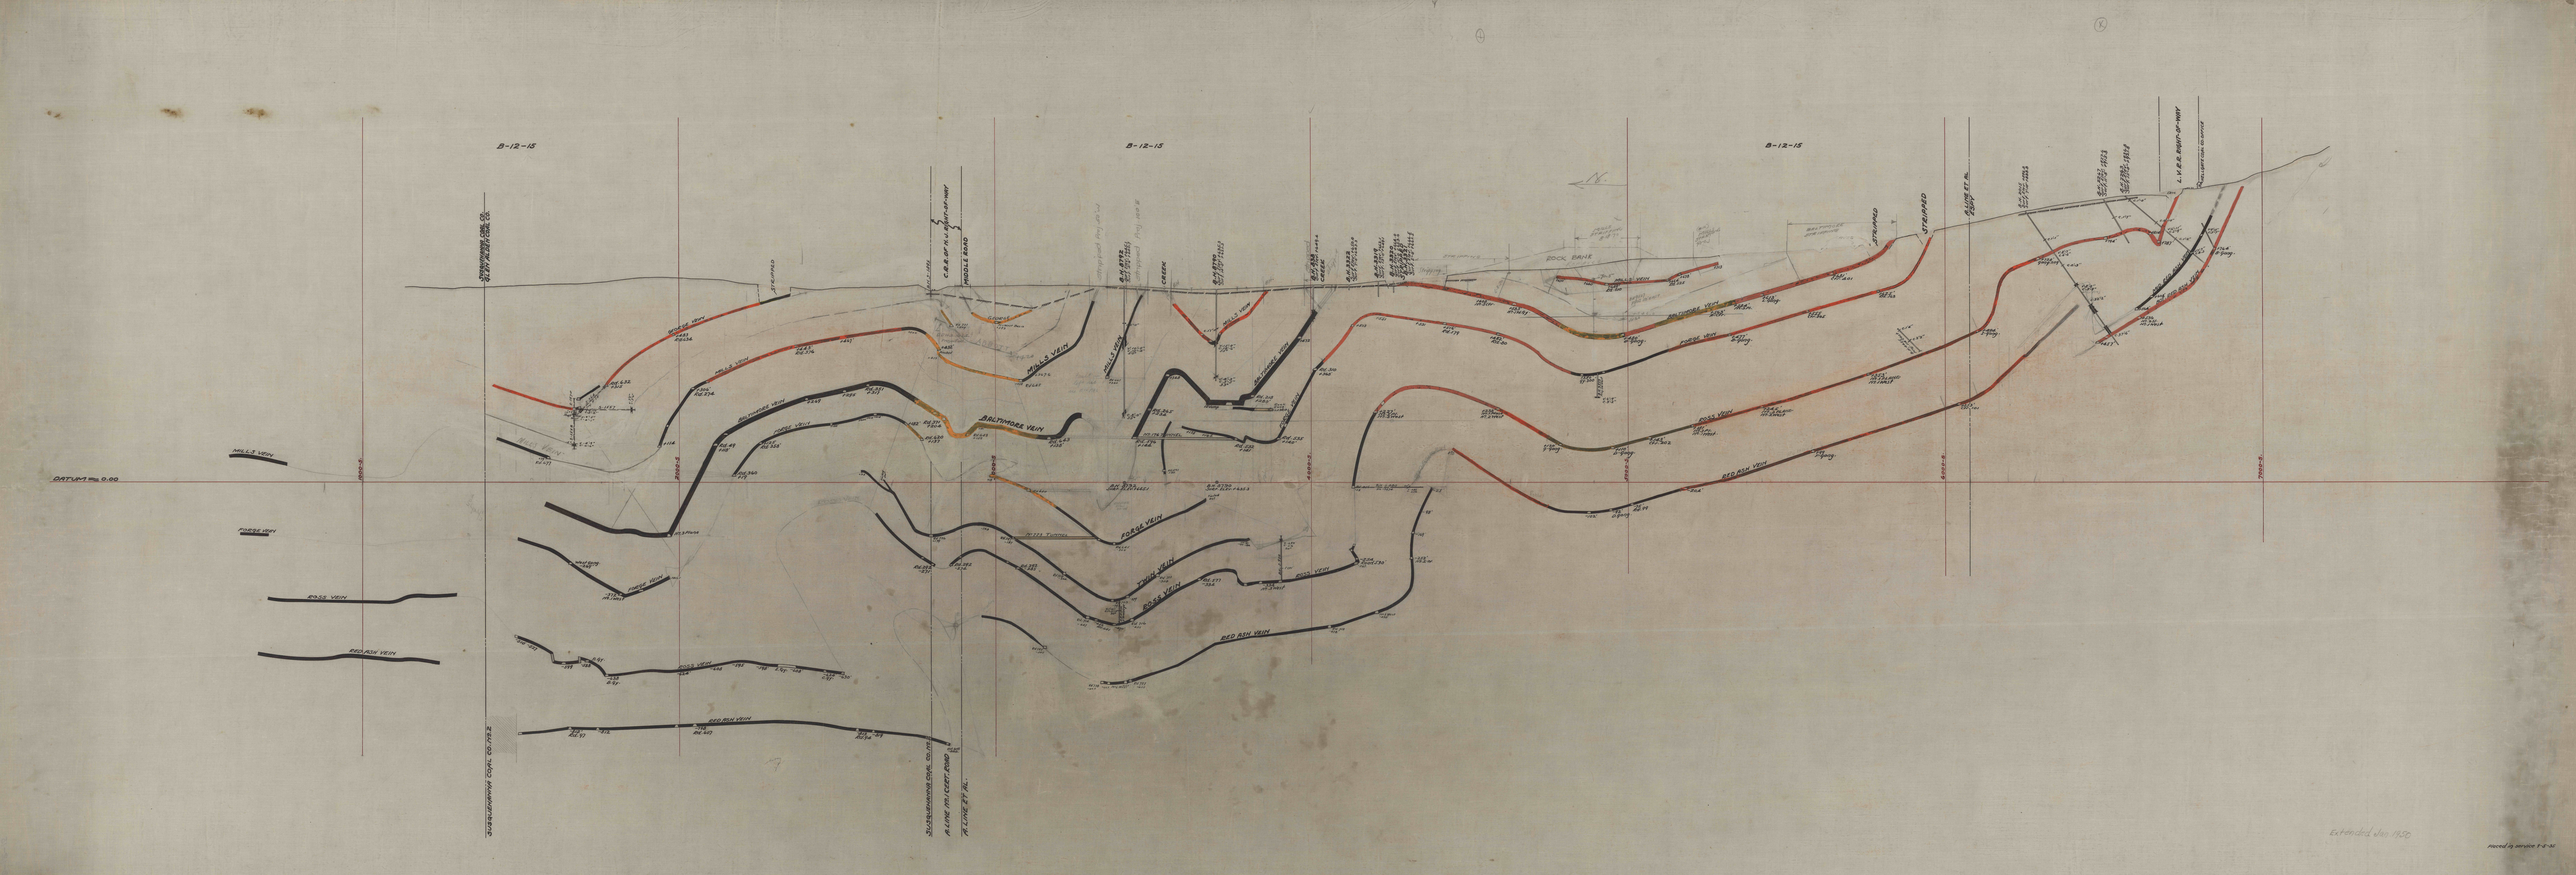
B-12-15
B-12-15
B-12-15
DATUM = 0.00
MILLS VEIN
FORGE VEIN
ROSS VEIN
RED ASH VEIN
BALTIMORE VEIN
ROCK BANK
MIDDLE ROAD
CREEK
A. LINE MINE COAL ROAD
"A" LINE PIT No.
Extended Jan 1920