


B-12-9

SUSQUEHANNA COAL Co.

B-12-9

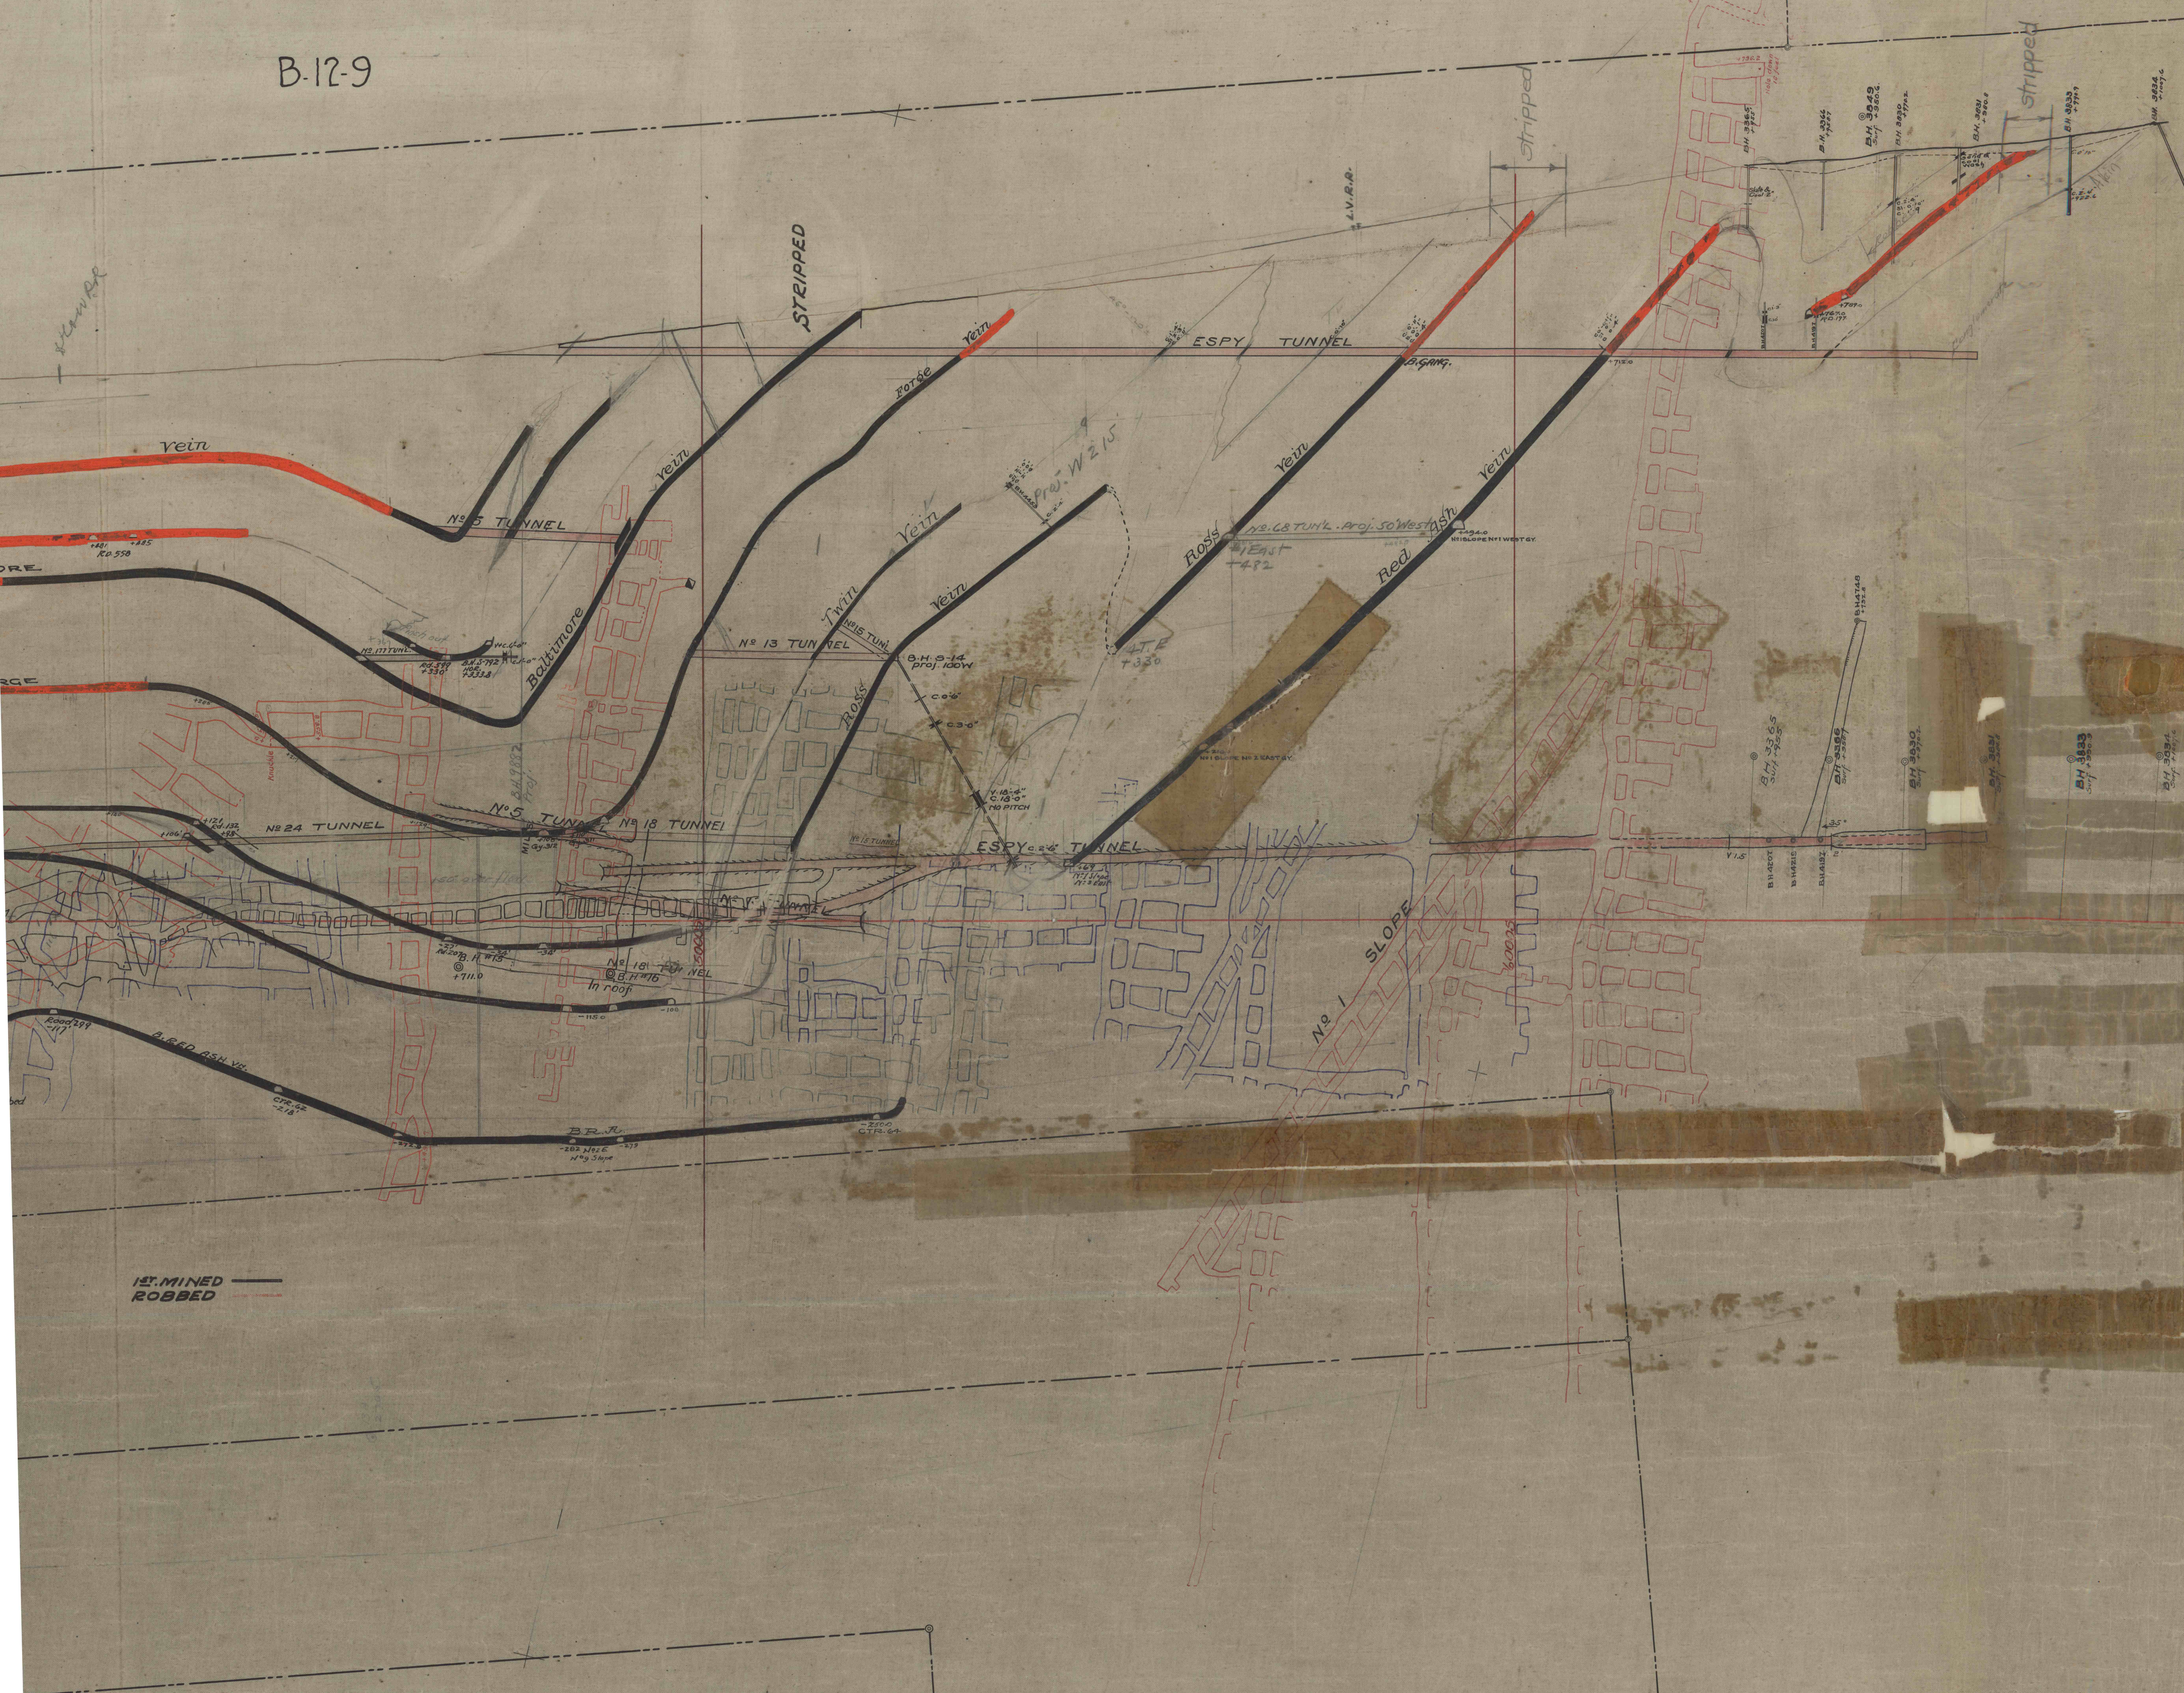

- ~ SECTION ~
~ BLISS and AUCHINCLOSS ~
- MILLS
 - BALTIMORE
 - FORGE
 - ROSS
 - RED ASH
 - MILLS