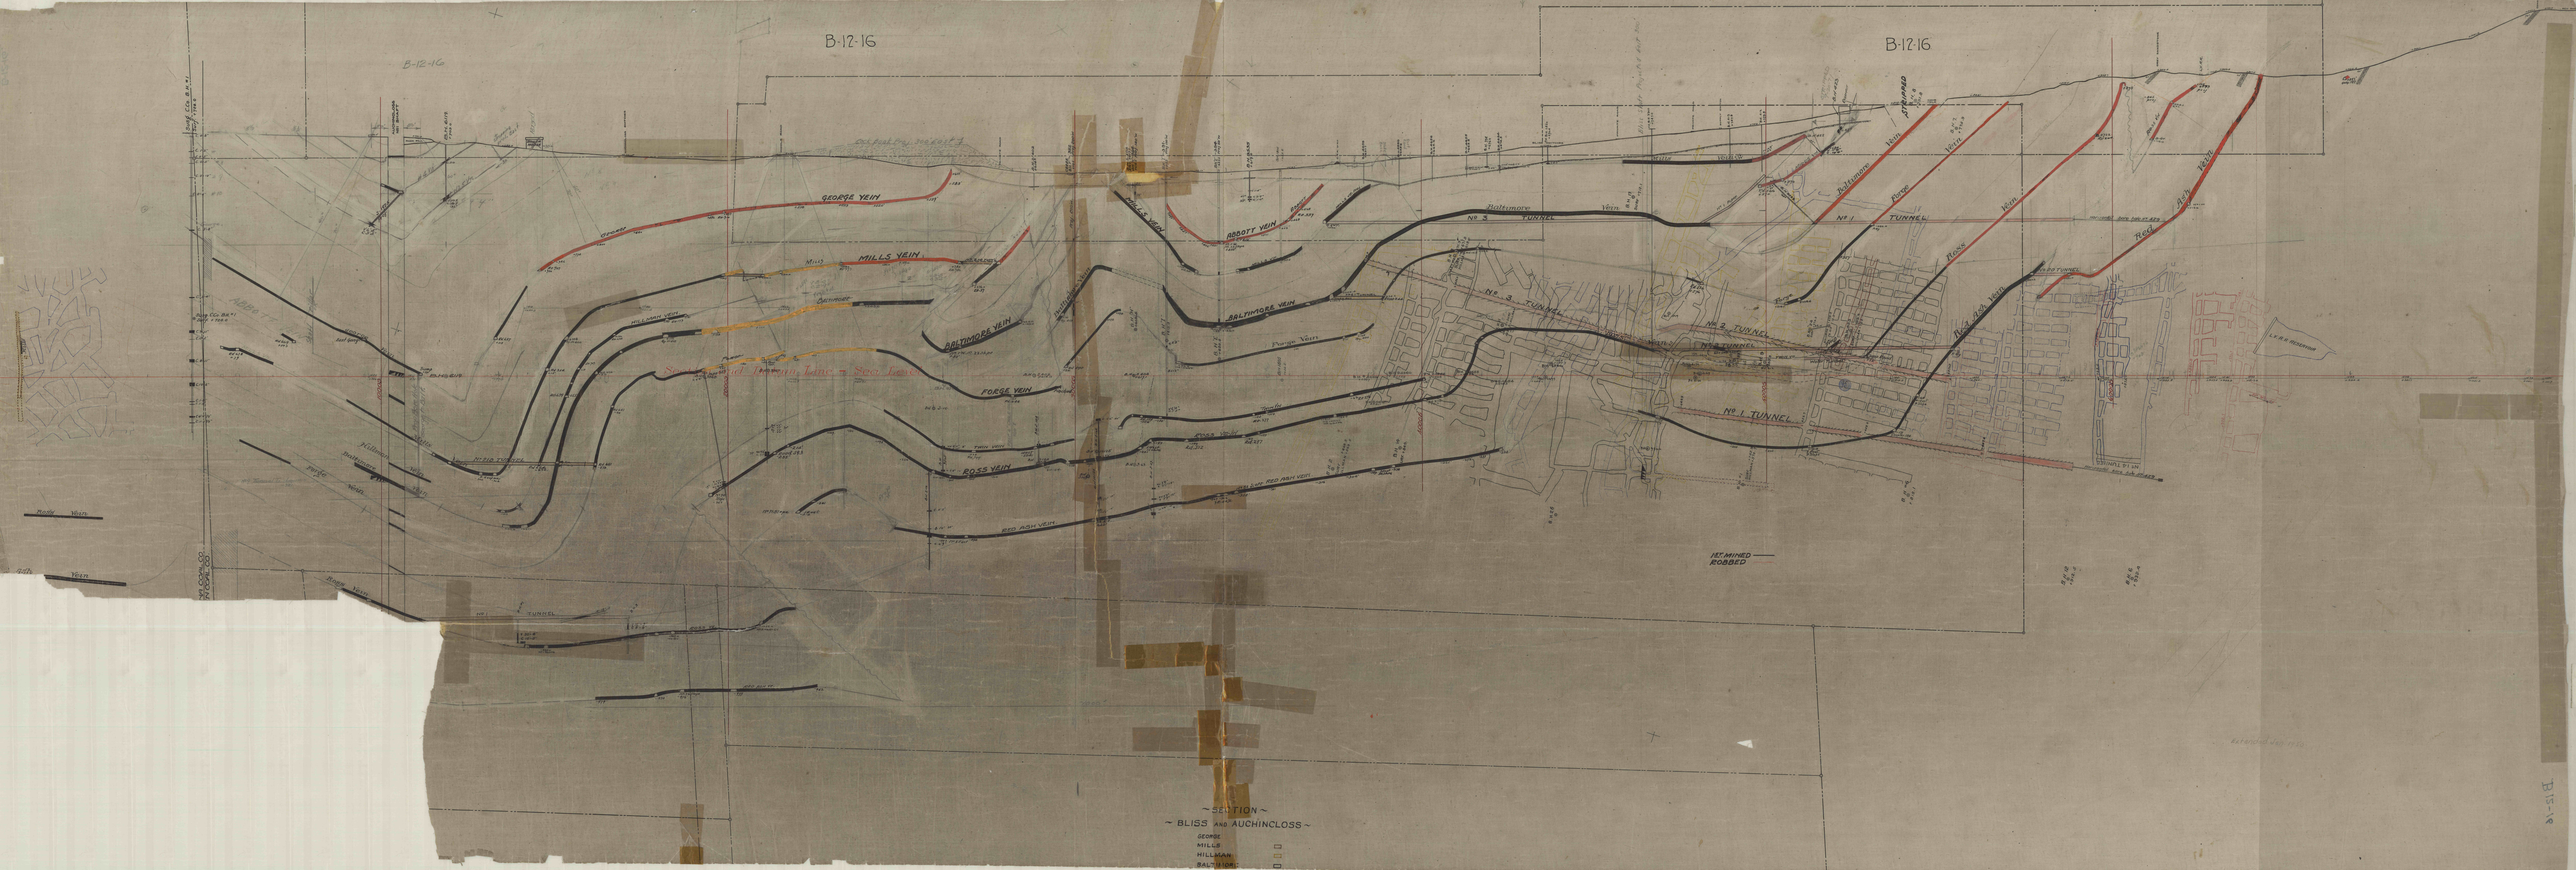
B-12-16
B-12-16
GEORGE VEIN
MILLS VEIN
ABBOTT VEIN
BALTIMORE VEIN
FORGE VEIN
ROSS VEIN
RED ASH VEIN
Baltimore Vein
Forge Vein
Ross Vein
Red Ash Vein
Nº 3 TUNNEL
Nº 1 TUNNEL
Nº 2 TUNNEL
Nº 1 TUNNEL
1ST. MINED ROBBED
~ SECTION ~
~ BLISS AND AUCHINCLOSS ~
GEORGE
MILLS
HILLMAN
BALTIMORE