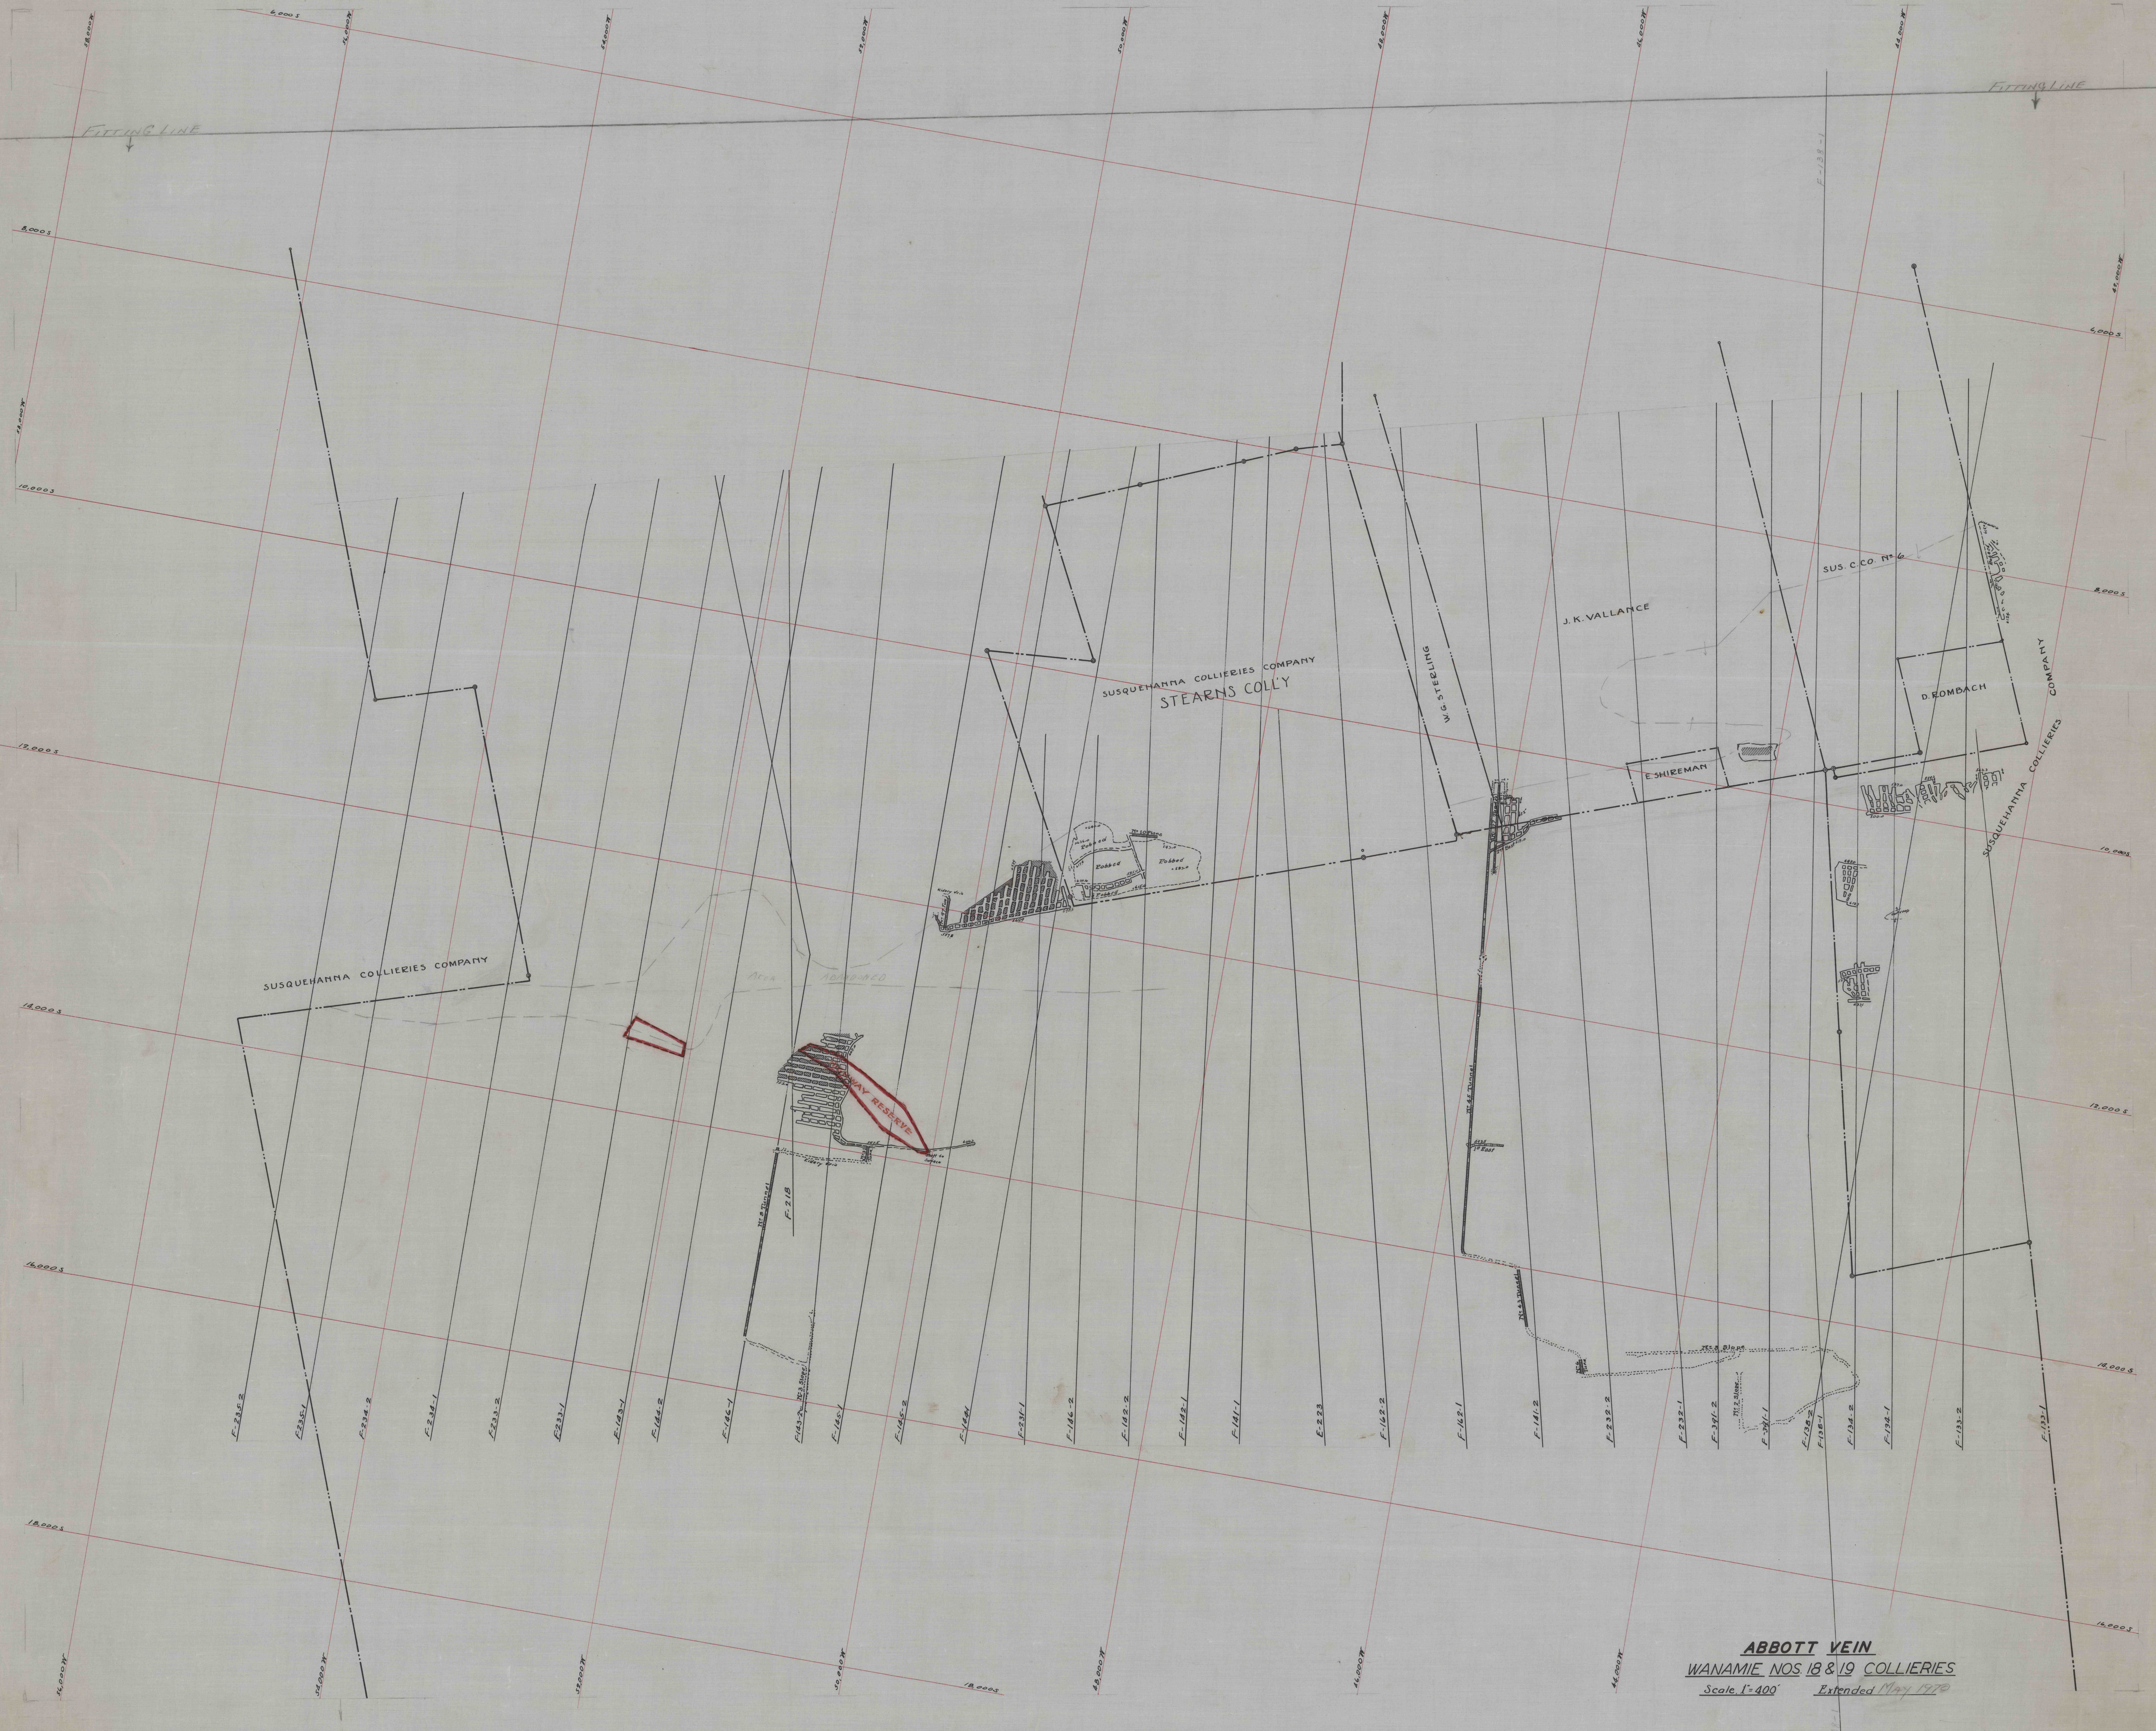
58,000W
6,000 S
56,000W
54,000W
52,000W
50,000W
48,000W
46,000W
44,000W
FITTING LINE
FITTING LINE
F-138-1
58,000W
8,000 S
42,000W
4,000 S
10,000 S
SUSQUEHANNA COLLIERIES COMPANY
STEARNS COLL'Y
W.G. STERLING
J.K. VALLANCE
SUS. C. CO. No 6
D. ROMBACH
E. SHIREMAN
SUSQUEHANNA COLLIERIES COMPANY
8,000 S
12,000 S
No 10 Plane
Robbed
Robbed
Robbed
Robbed
Robbed
Kidery Vein
10,000 S
SUSQUEHANNA COLLIERIES COMPANY
AREA ABANDONED
14,000 S
WAY RESERVE
Shaft to Surface
Kidery Vein
2nd East 613.0
Outcrop
No 45 Tunnel
1st East
12,000 S
No 3 Tunnel
F-218
No 3 Slope
No 43 Tunnel
No 8 Slope
No 6 Tunnel
No 2 Slope
16,000 S
14,000 S
F-235-2
F-235-1
F-234-2
F-234-1
F-233-2
F-233-1
F-143-1
F-144-2
F-146-1
F-143-2
F-145-1
F-145-2
F-144-1
F-231-1
F-146-2
F-142-2
F-142-1
F-141-1
E-223
F-162-2
F-162-1
F-141-2
F-232-2
F-232-1
F-391-2
F-391-1
F-138-2
F-138-1
F-134-2
F-134-1
F-133-2
F-133-1
18,000 S
16,000 S
56,000W
54,000W
52,000W
50,000W
18,000 S
48,000W
46,000W
44,000W
F-138-1

ABBOTT VEIN

WANAMIE NOS. 18 & 19 COLLIERIES

Scale 1" = 400' Extended May 1970