


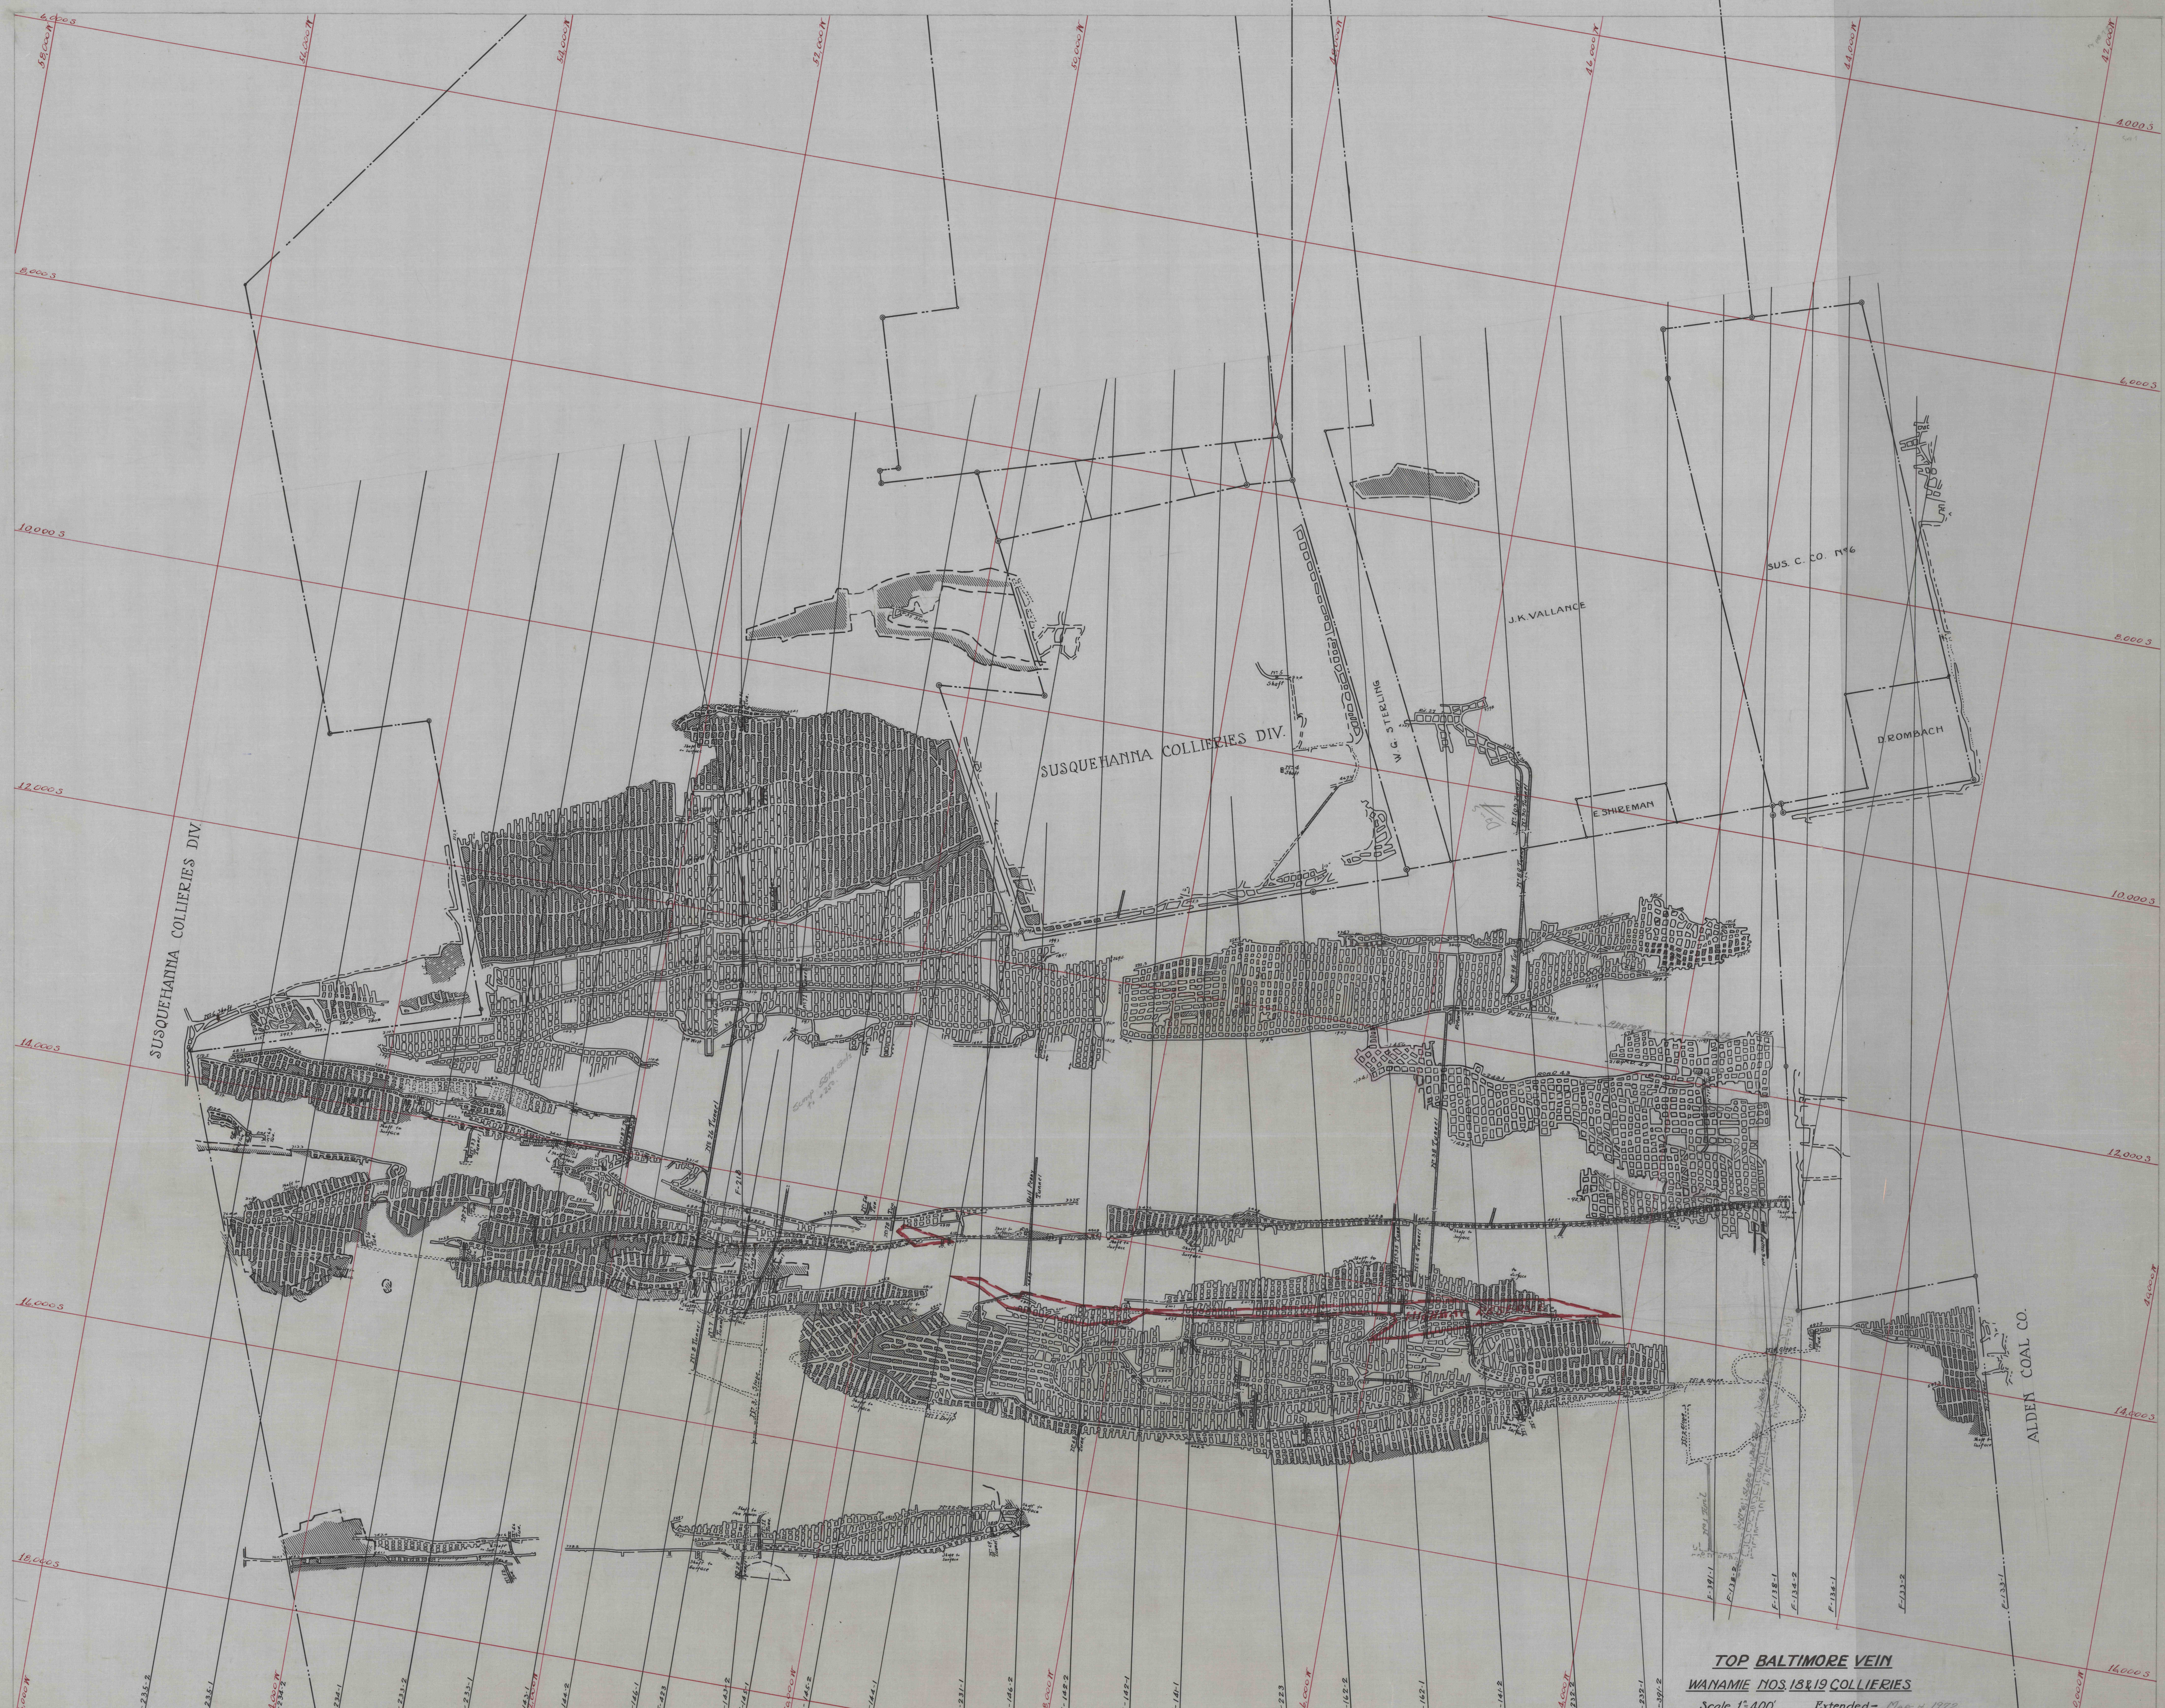

TOP BALTIMORE VEIN
WAYMIE NOS. 18 & 19 COLLIERIES
Scale, 1"=400' Extended - March 1922