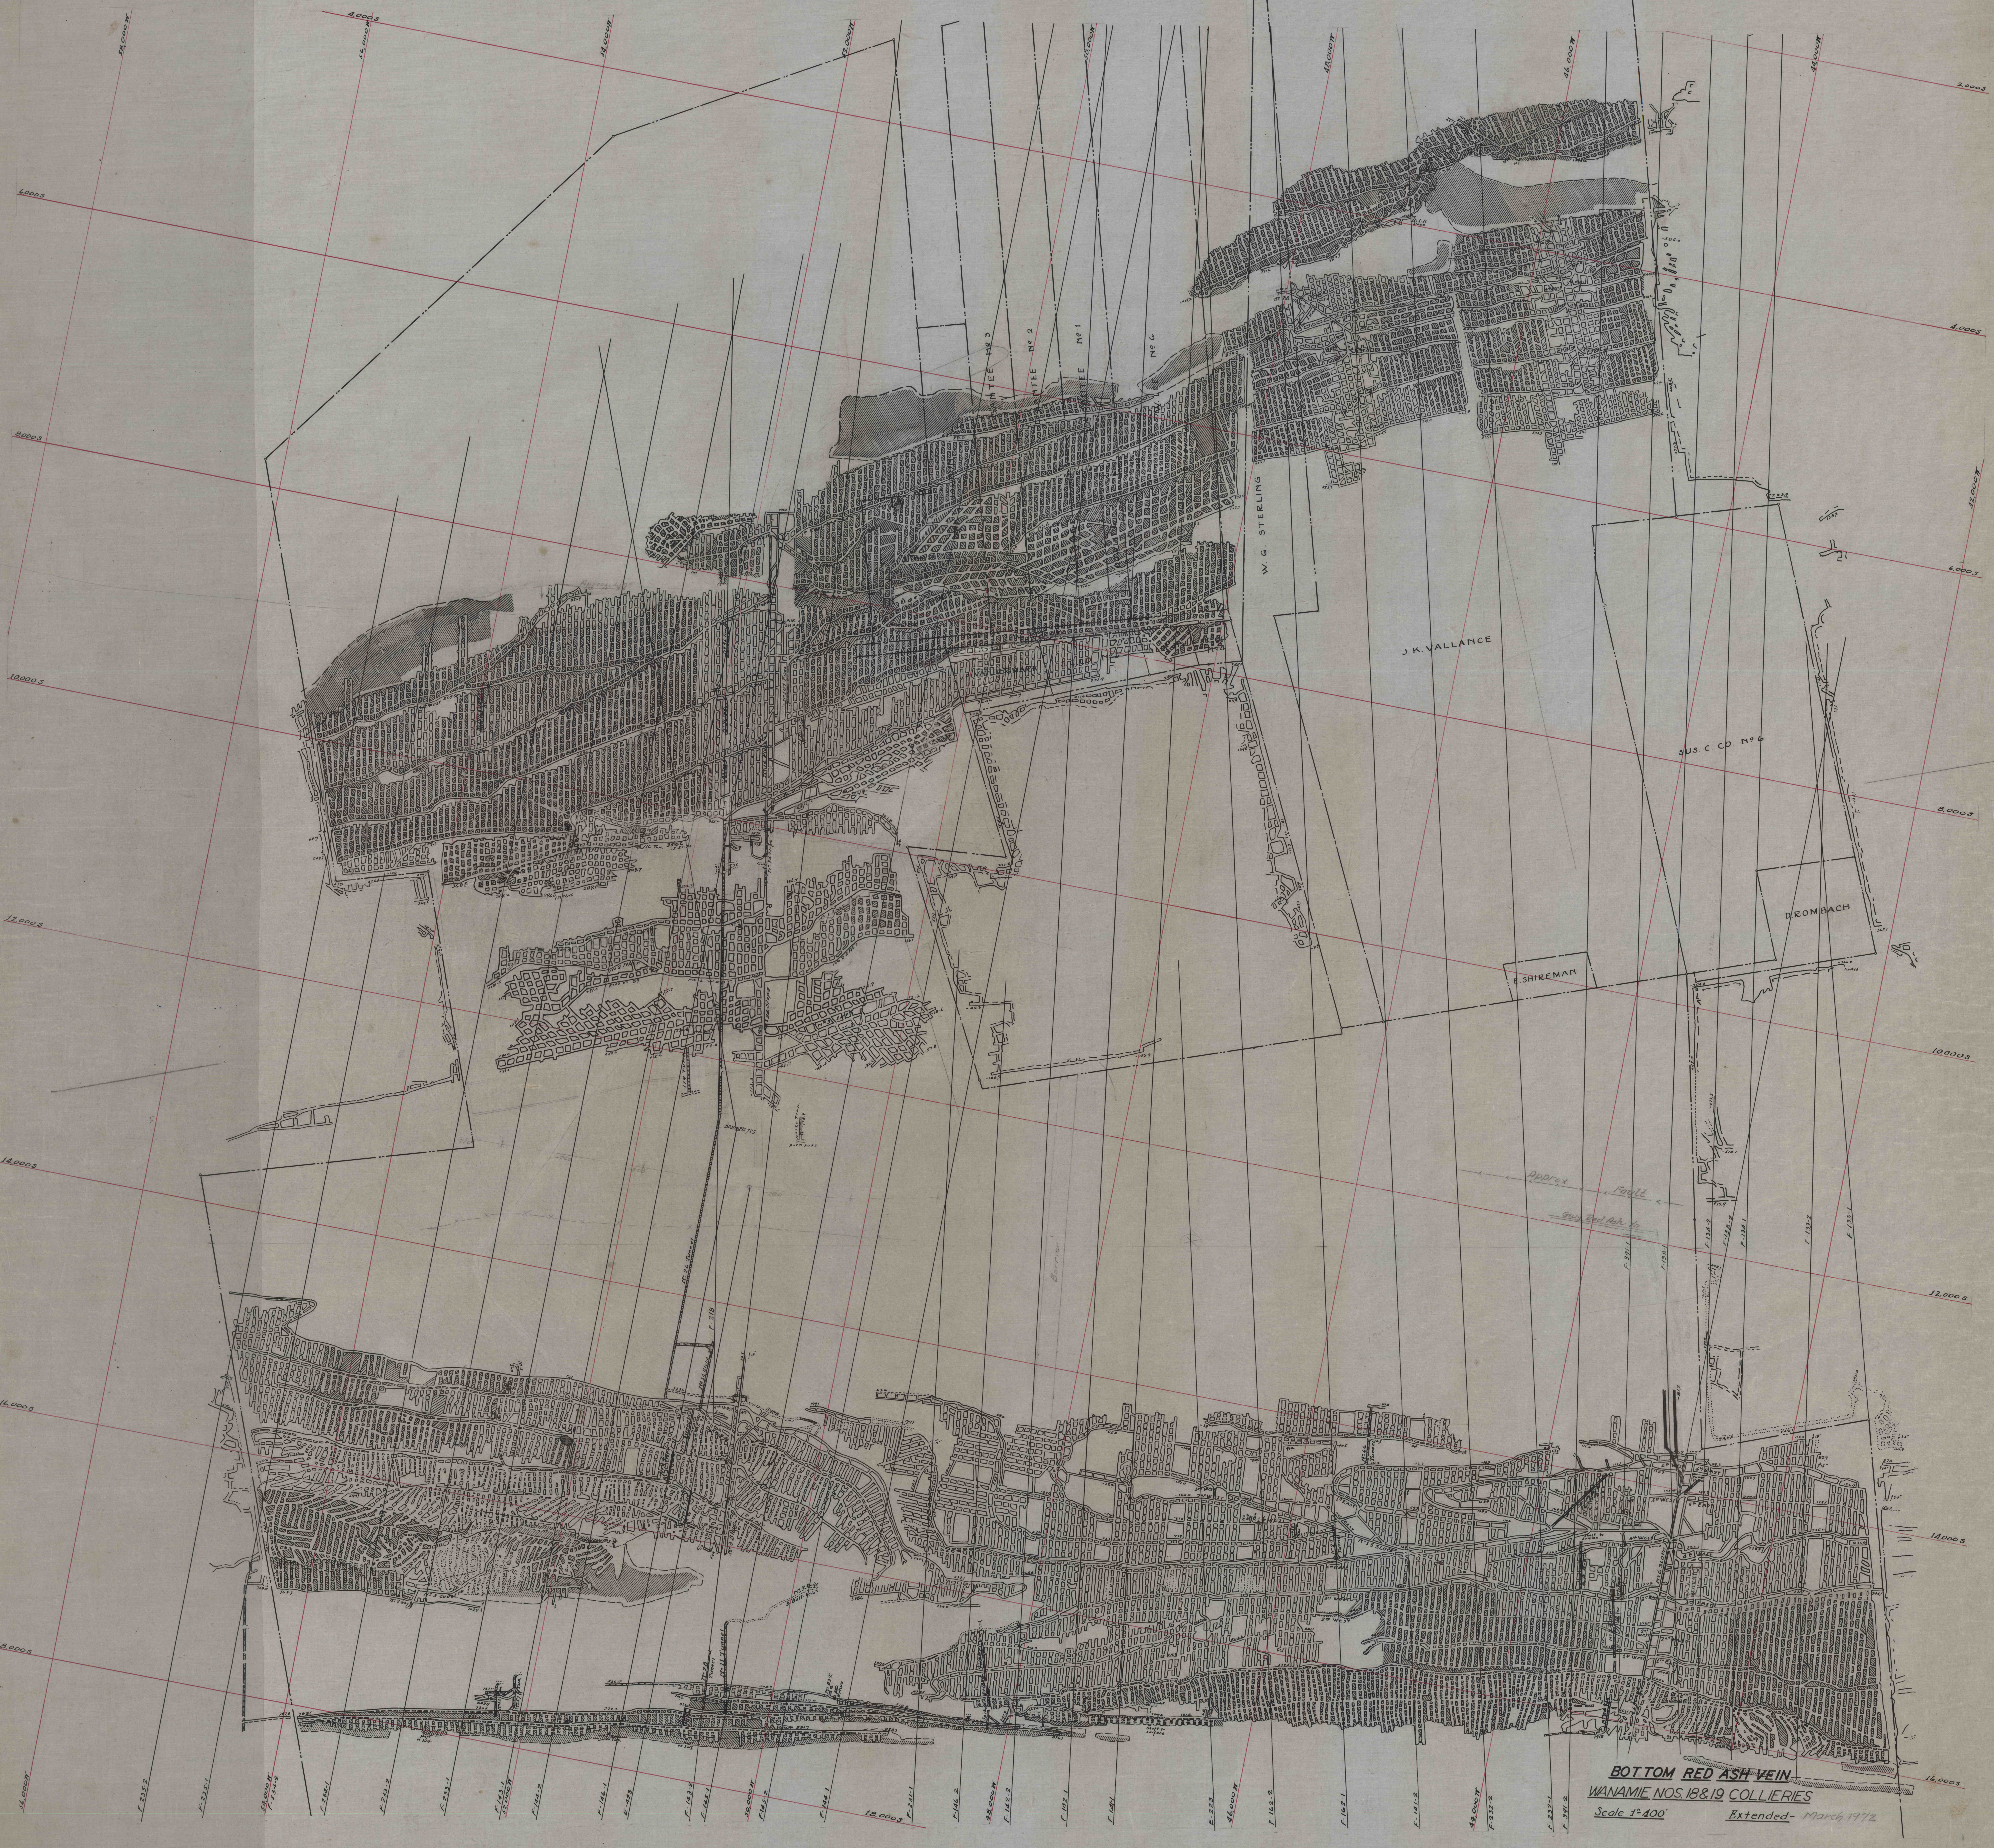
4,000 S
58,000 W
56,000 W
54,000 W
52,000 W
50,000 W
48,000 W
46,000 W
44,000 W
42,000 W
2,000 S
4,000 S
6,000 S
8,000 S
10,000 S
12,000 S
14,000 S
16,000 S
18,000 S
MANTEE No 3
MANTEE No 2
MANTEE No 1
No 6
W. G. STERLING
J. K. VALLANCE
SUS. C. CO. No 6
D. ROMBACH
E. SHIREMAN
AIR SHAFT
No 26 Tunnel
F-218
No 14 Slope
No 34 Slope
119 Tunnel
No 28 Tunnel
No 11 Tunnel
No 3 Slope
No 15 Slope
No 6 Slope
No 46 Tunnel
Barrier
Approx Fault
Grey Red Ash Vn
Shaft to Surface
F-235-2
F-235-1
54,000 W
F-234-2
F-234-1
F-233-2
F-233-1
F-143-1
52,000 W
F-144-2
F-146-1
E-423
F-143-2
F-145-1
50,000 W
F-145-2
F-144-1
F-231-1
F-146-2
48,000 W
F-142-2
F-142-1
F-141-1
E-223
46,000 W
F-162-2
F-162-1
F-141-2
44,000 W
F-232-2
F-232-1
F-391-2
F-391-1
F-138-1
F-134-2
F-138-2
F-134-1
F-133-2
F-133-1

BOTTOM RED ASH VEIN

WANAMIE NOS. 18&19 COLLIERIES

Scale 1" = 400'

Extended- March 1972