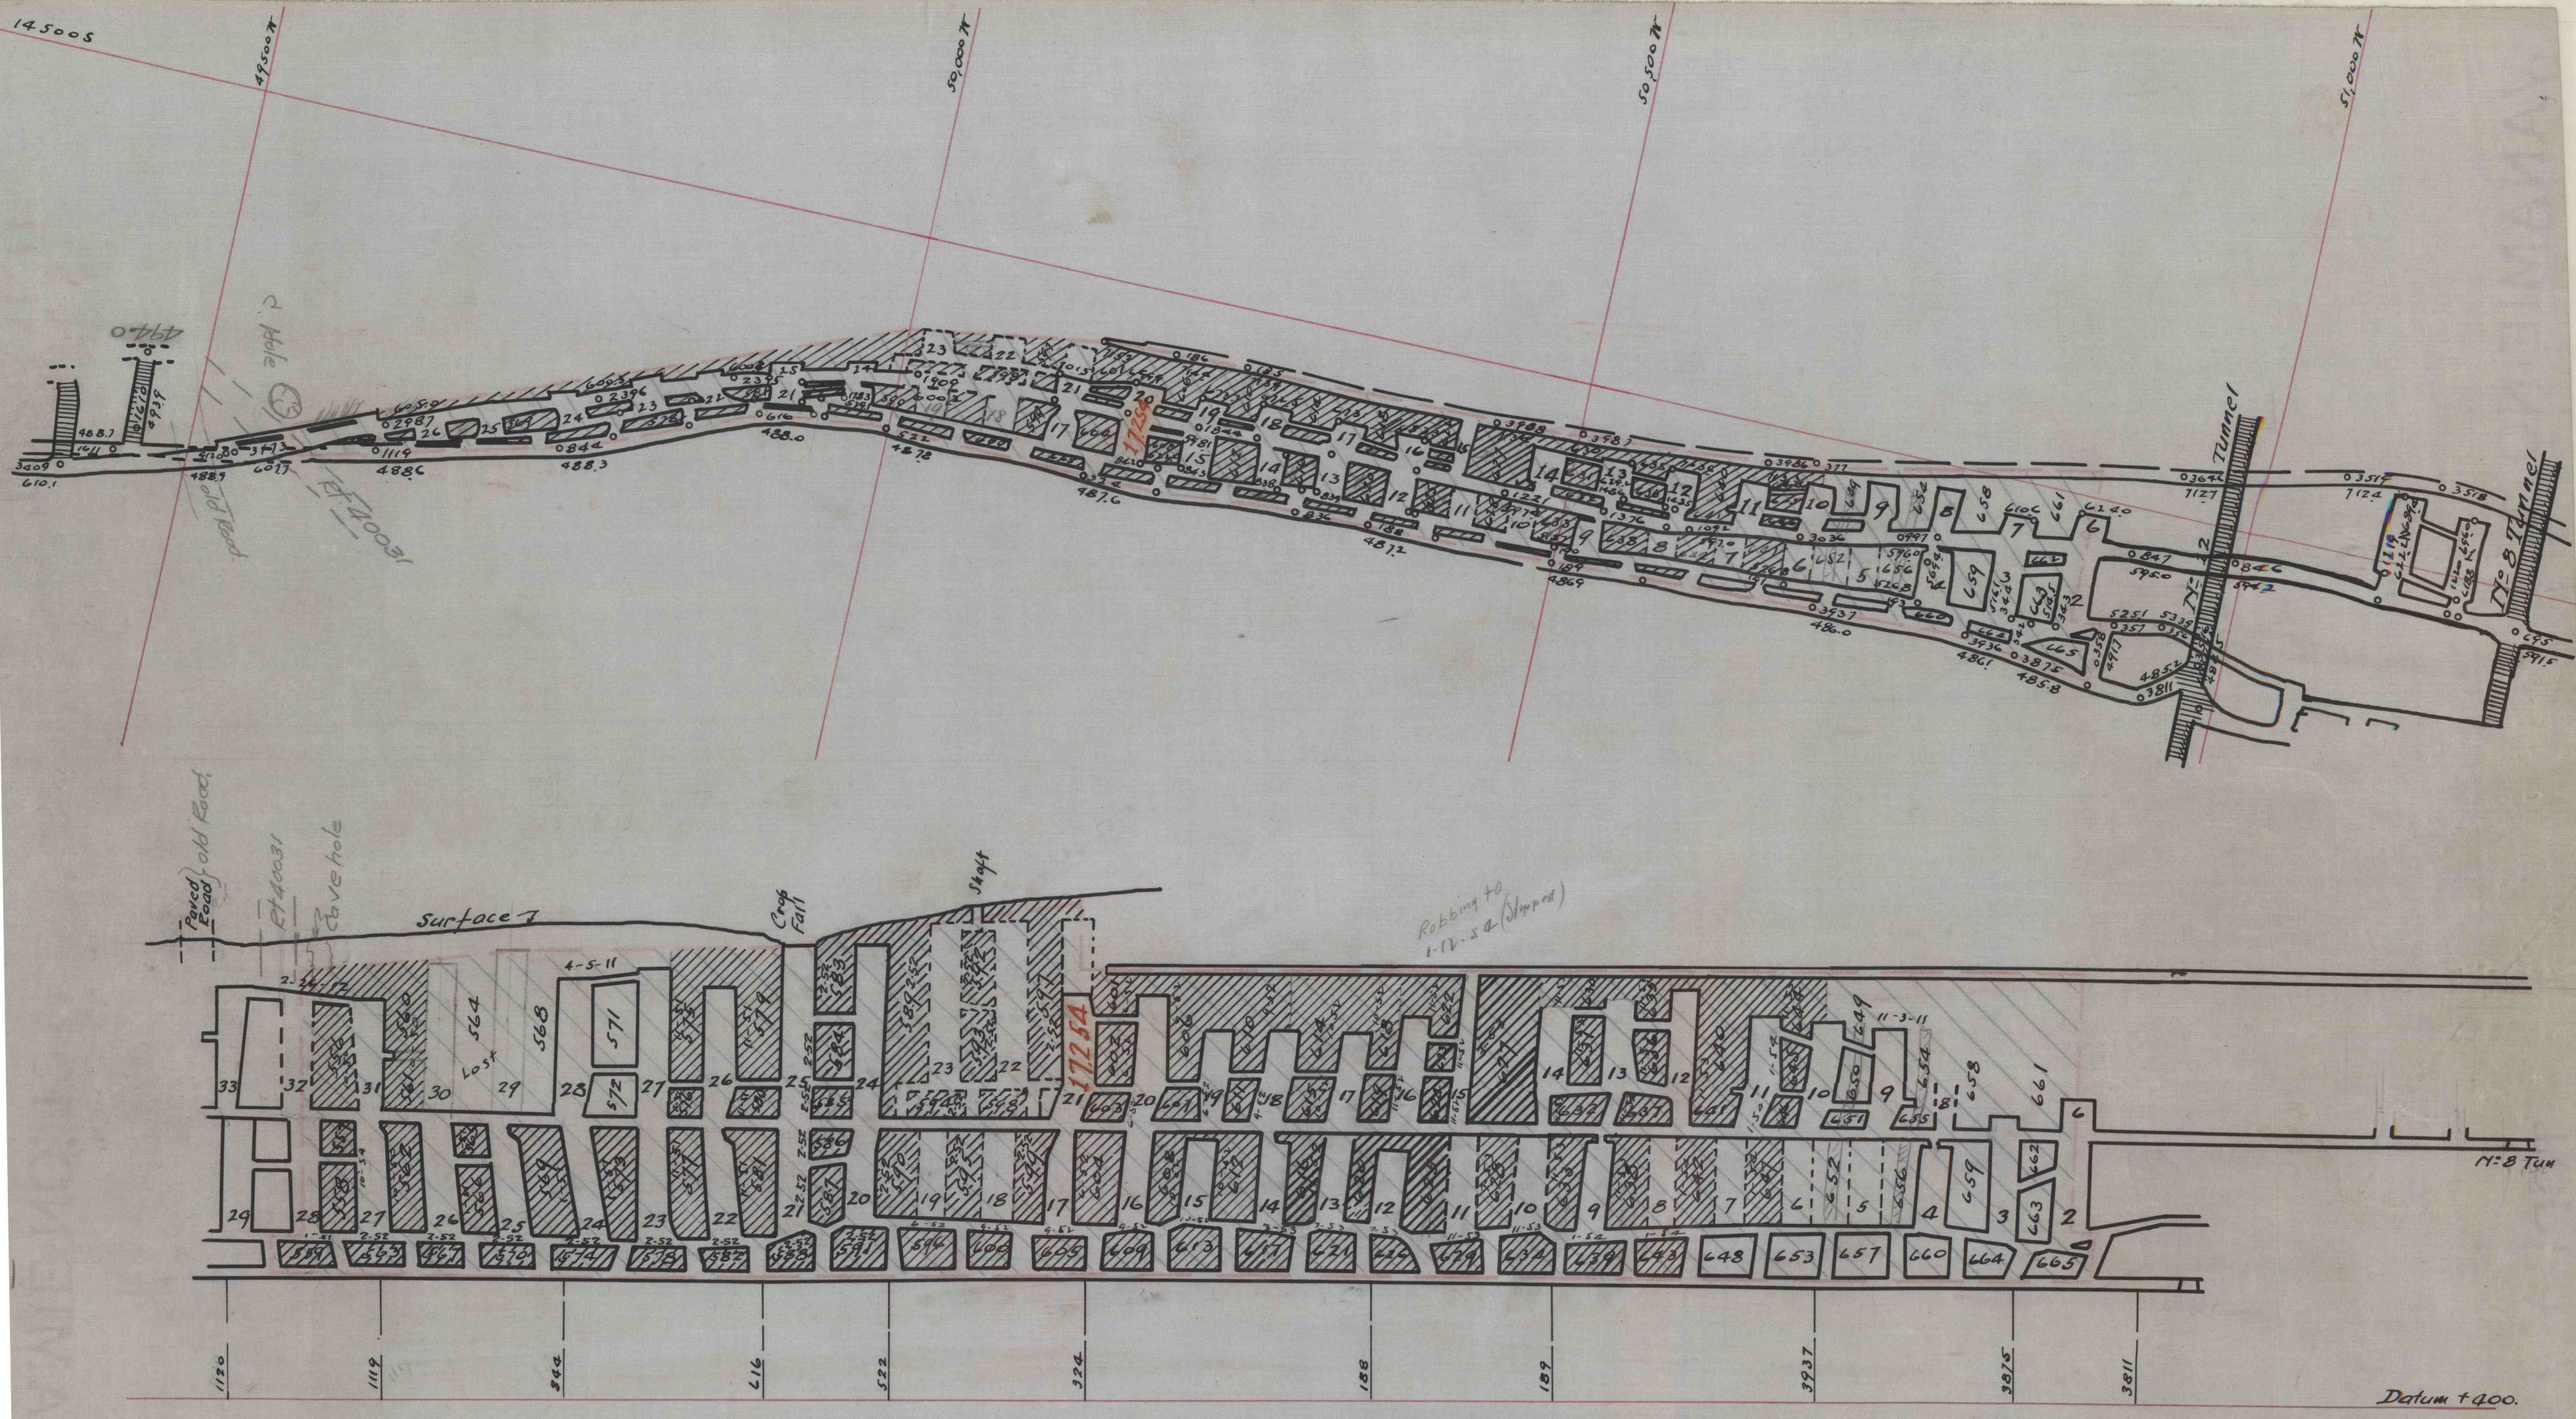
14500S
49,500 W
50,000 W
50,500 W
51,000 W
Tunnel
No 8 Tunnel
Paved Road
old Road
Cave hole
Surface
Crop Fall
Shaft
Robbing to 1-12-54 (Stopped)
Lost
No 8 Tun
Datum +400.