


NO. 2

TOP BALTIMORE VEIN

NO. 2

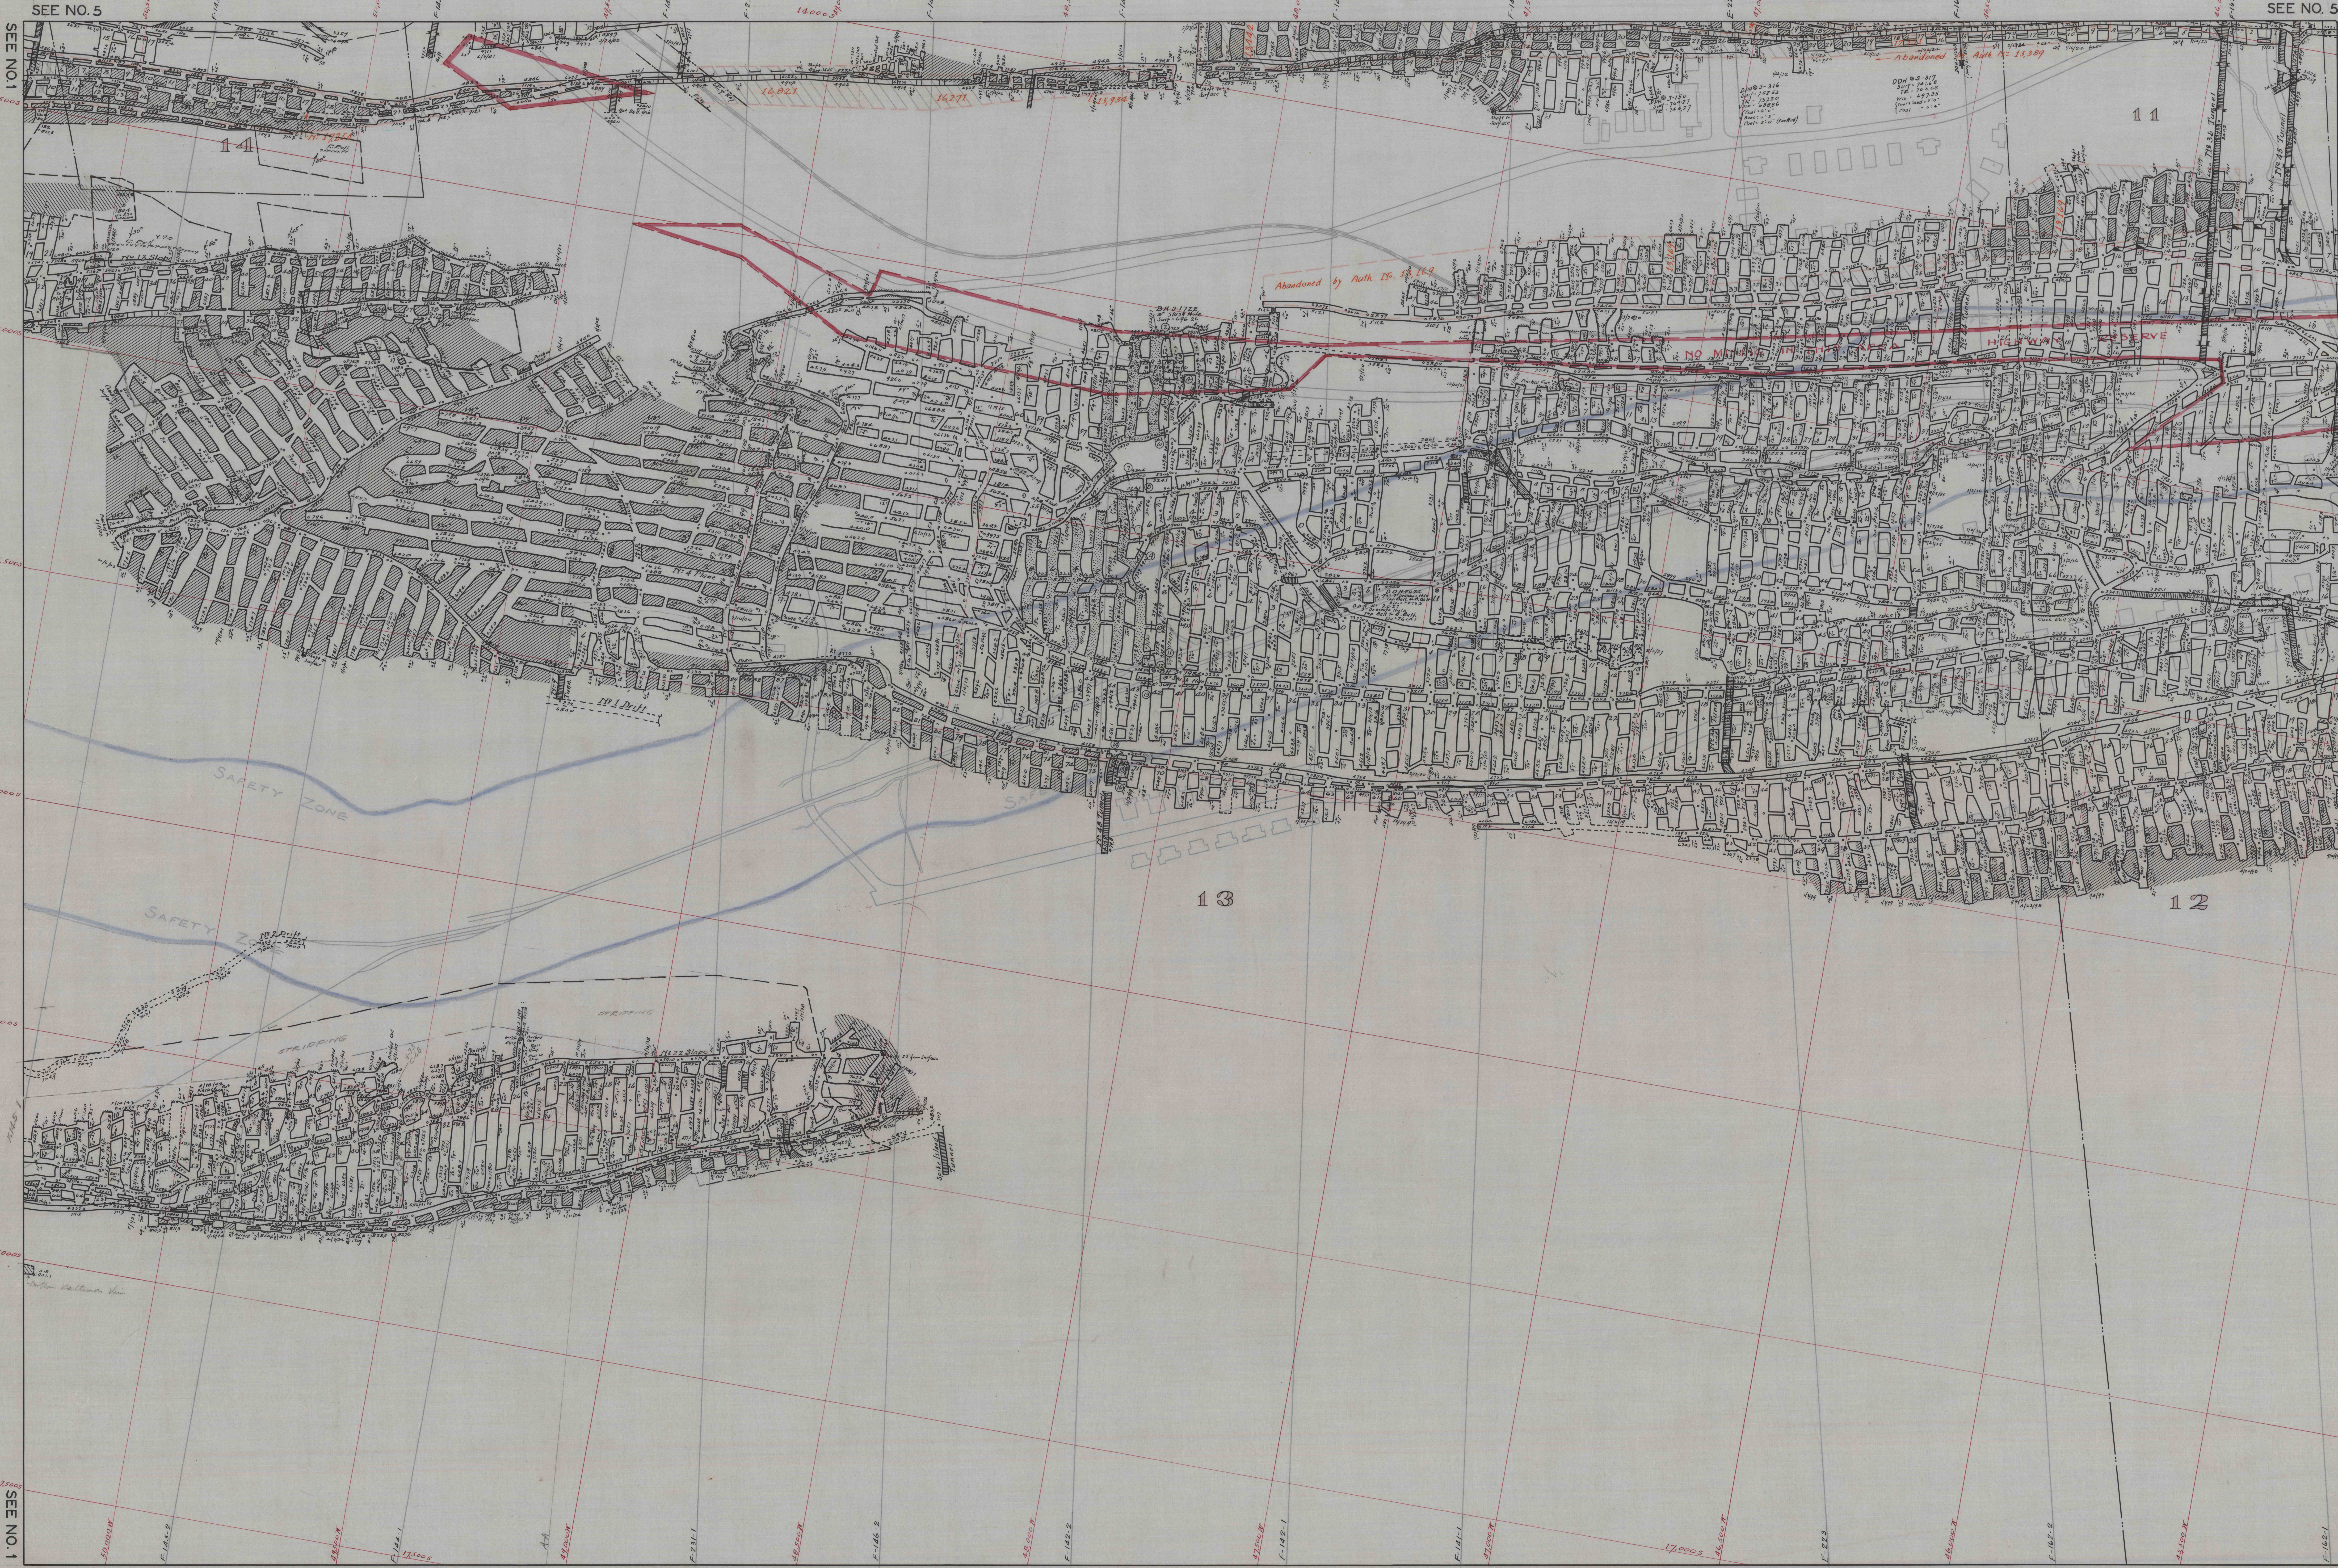

NO. 2

TOP BALTIMORE VEIN

NO. 2