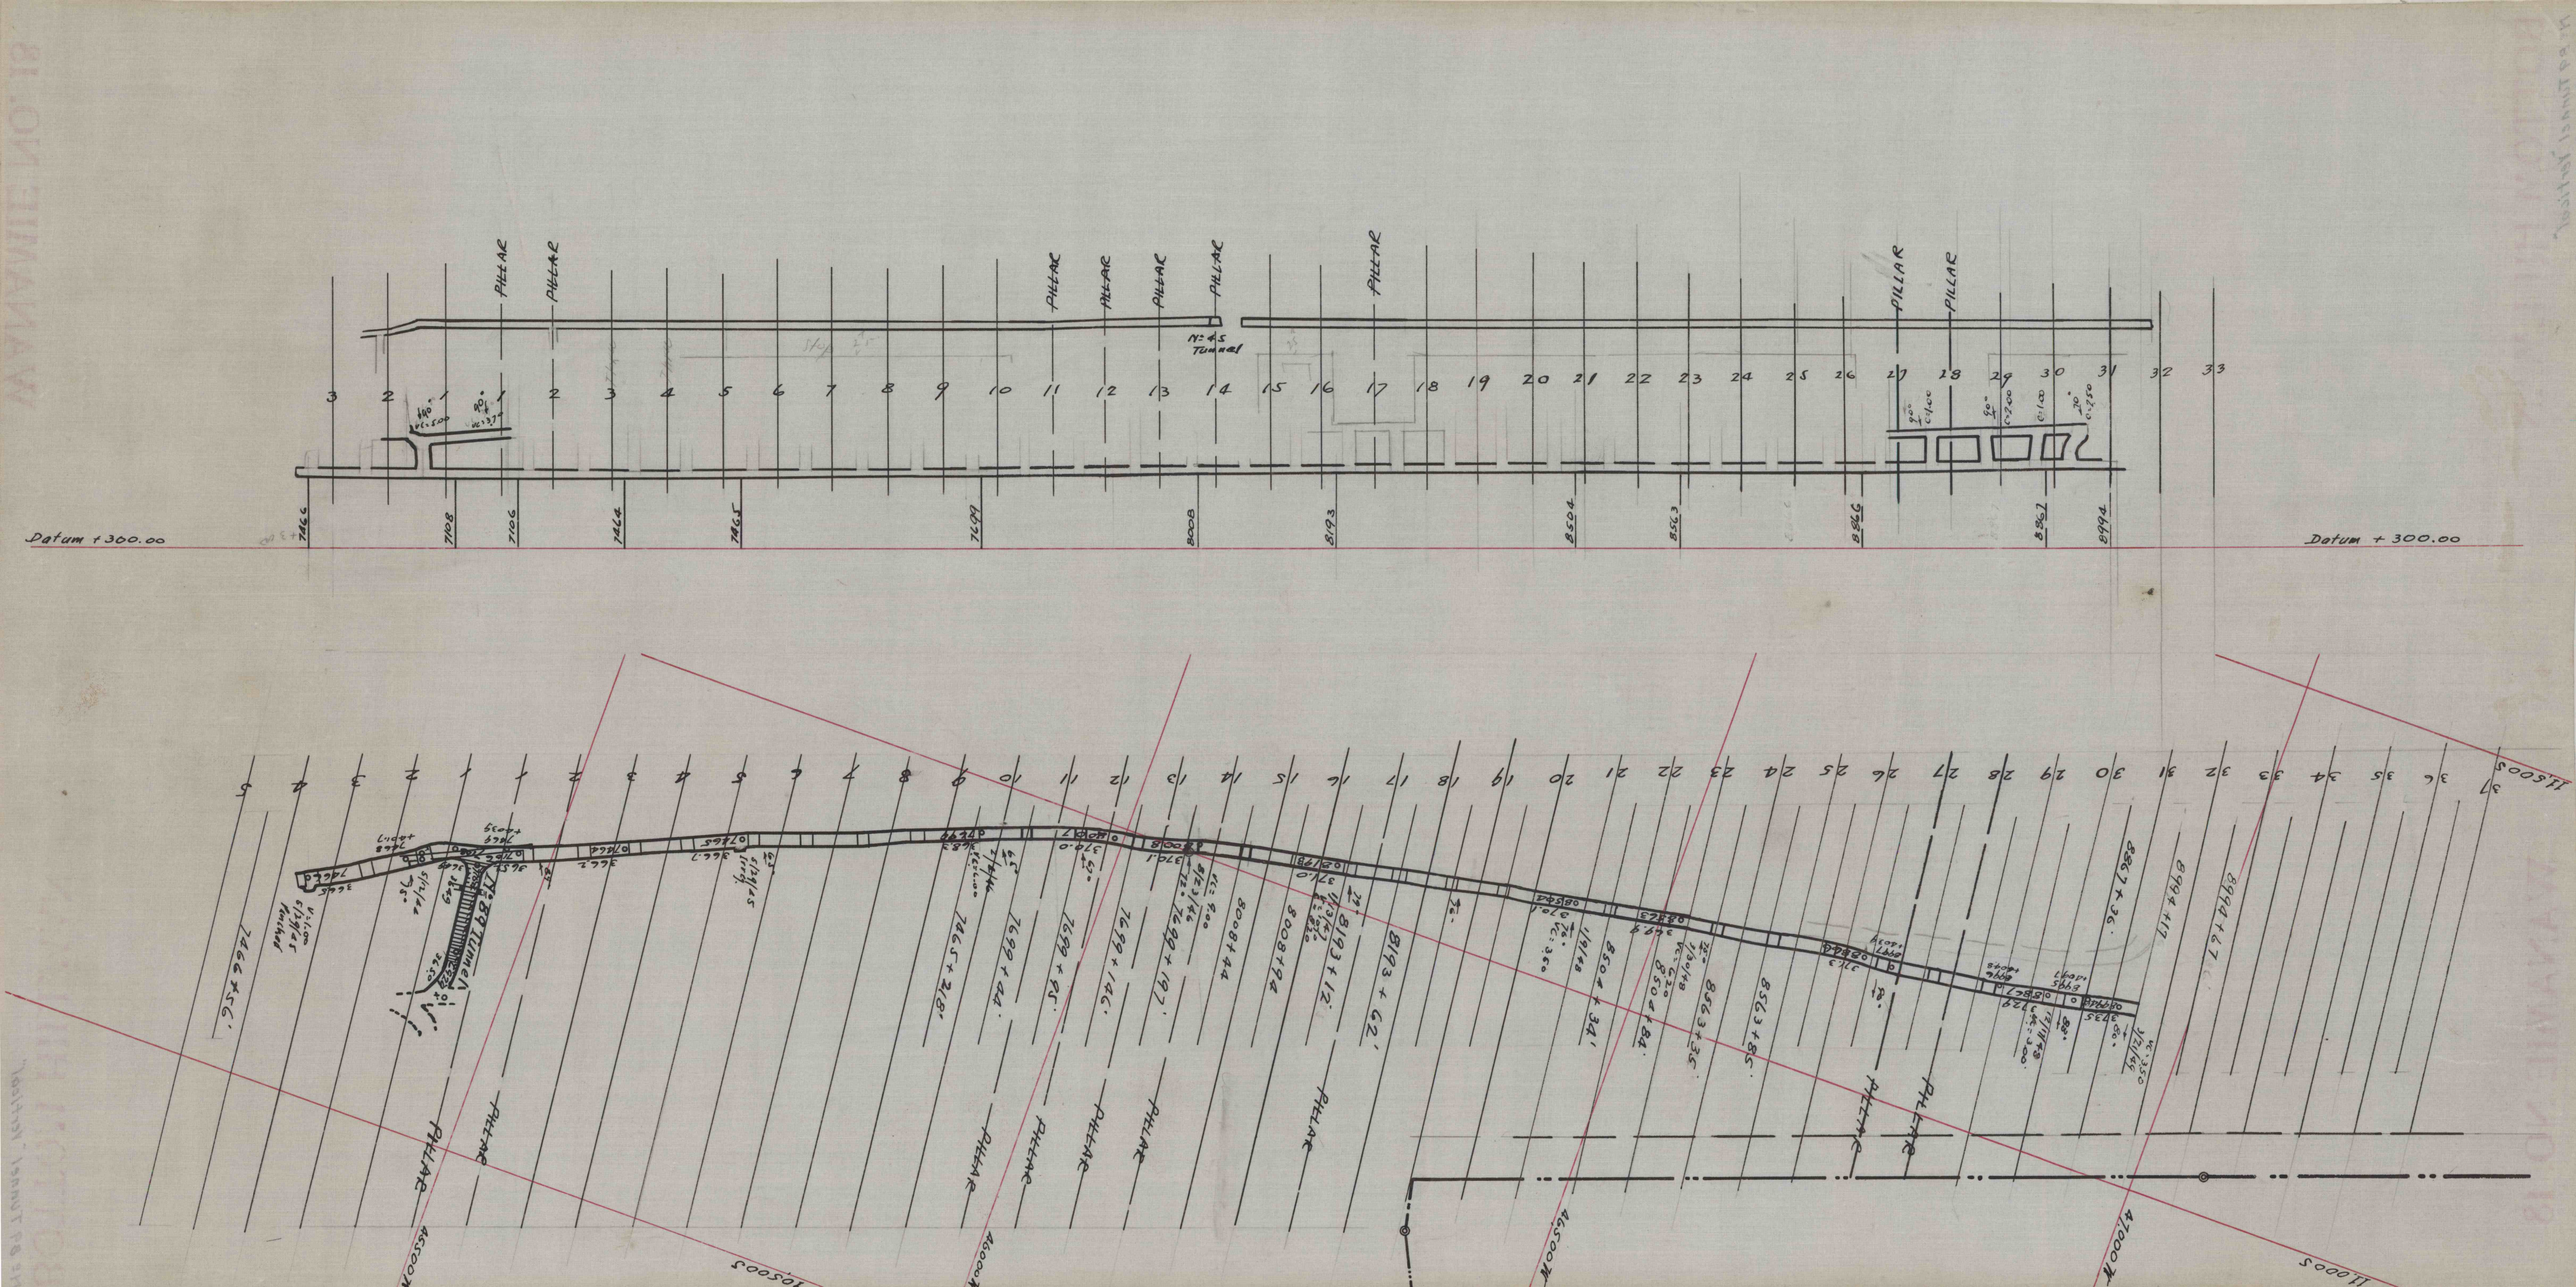
PILLAR
N=45 Tunnel
Datum + 300.00
7466
7108
7106
7464
7465
7499
8008
8193
8504
8563
8846
8967
8994
Datum + 300.00