


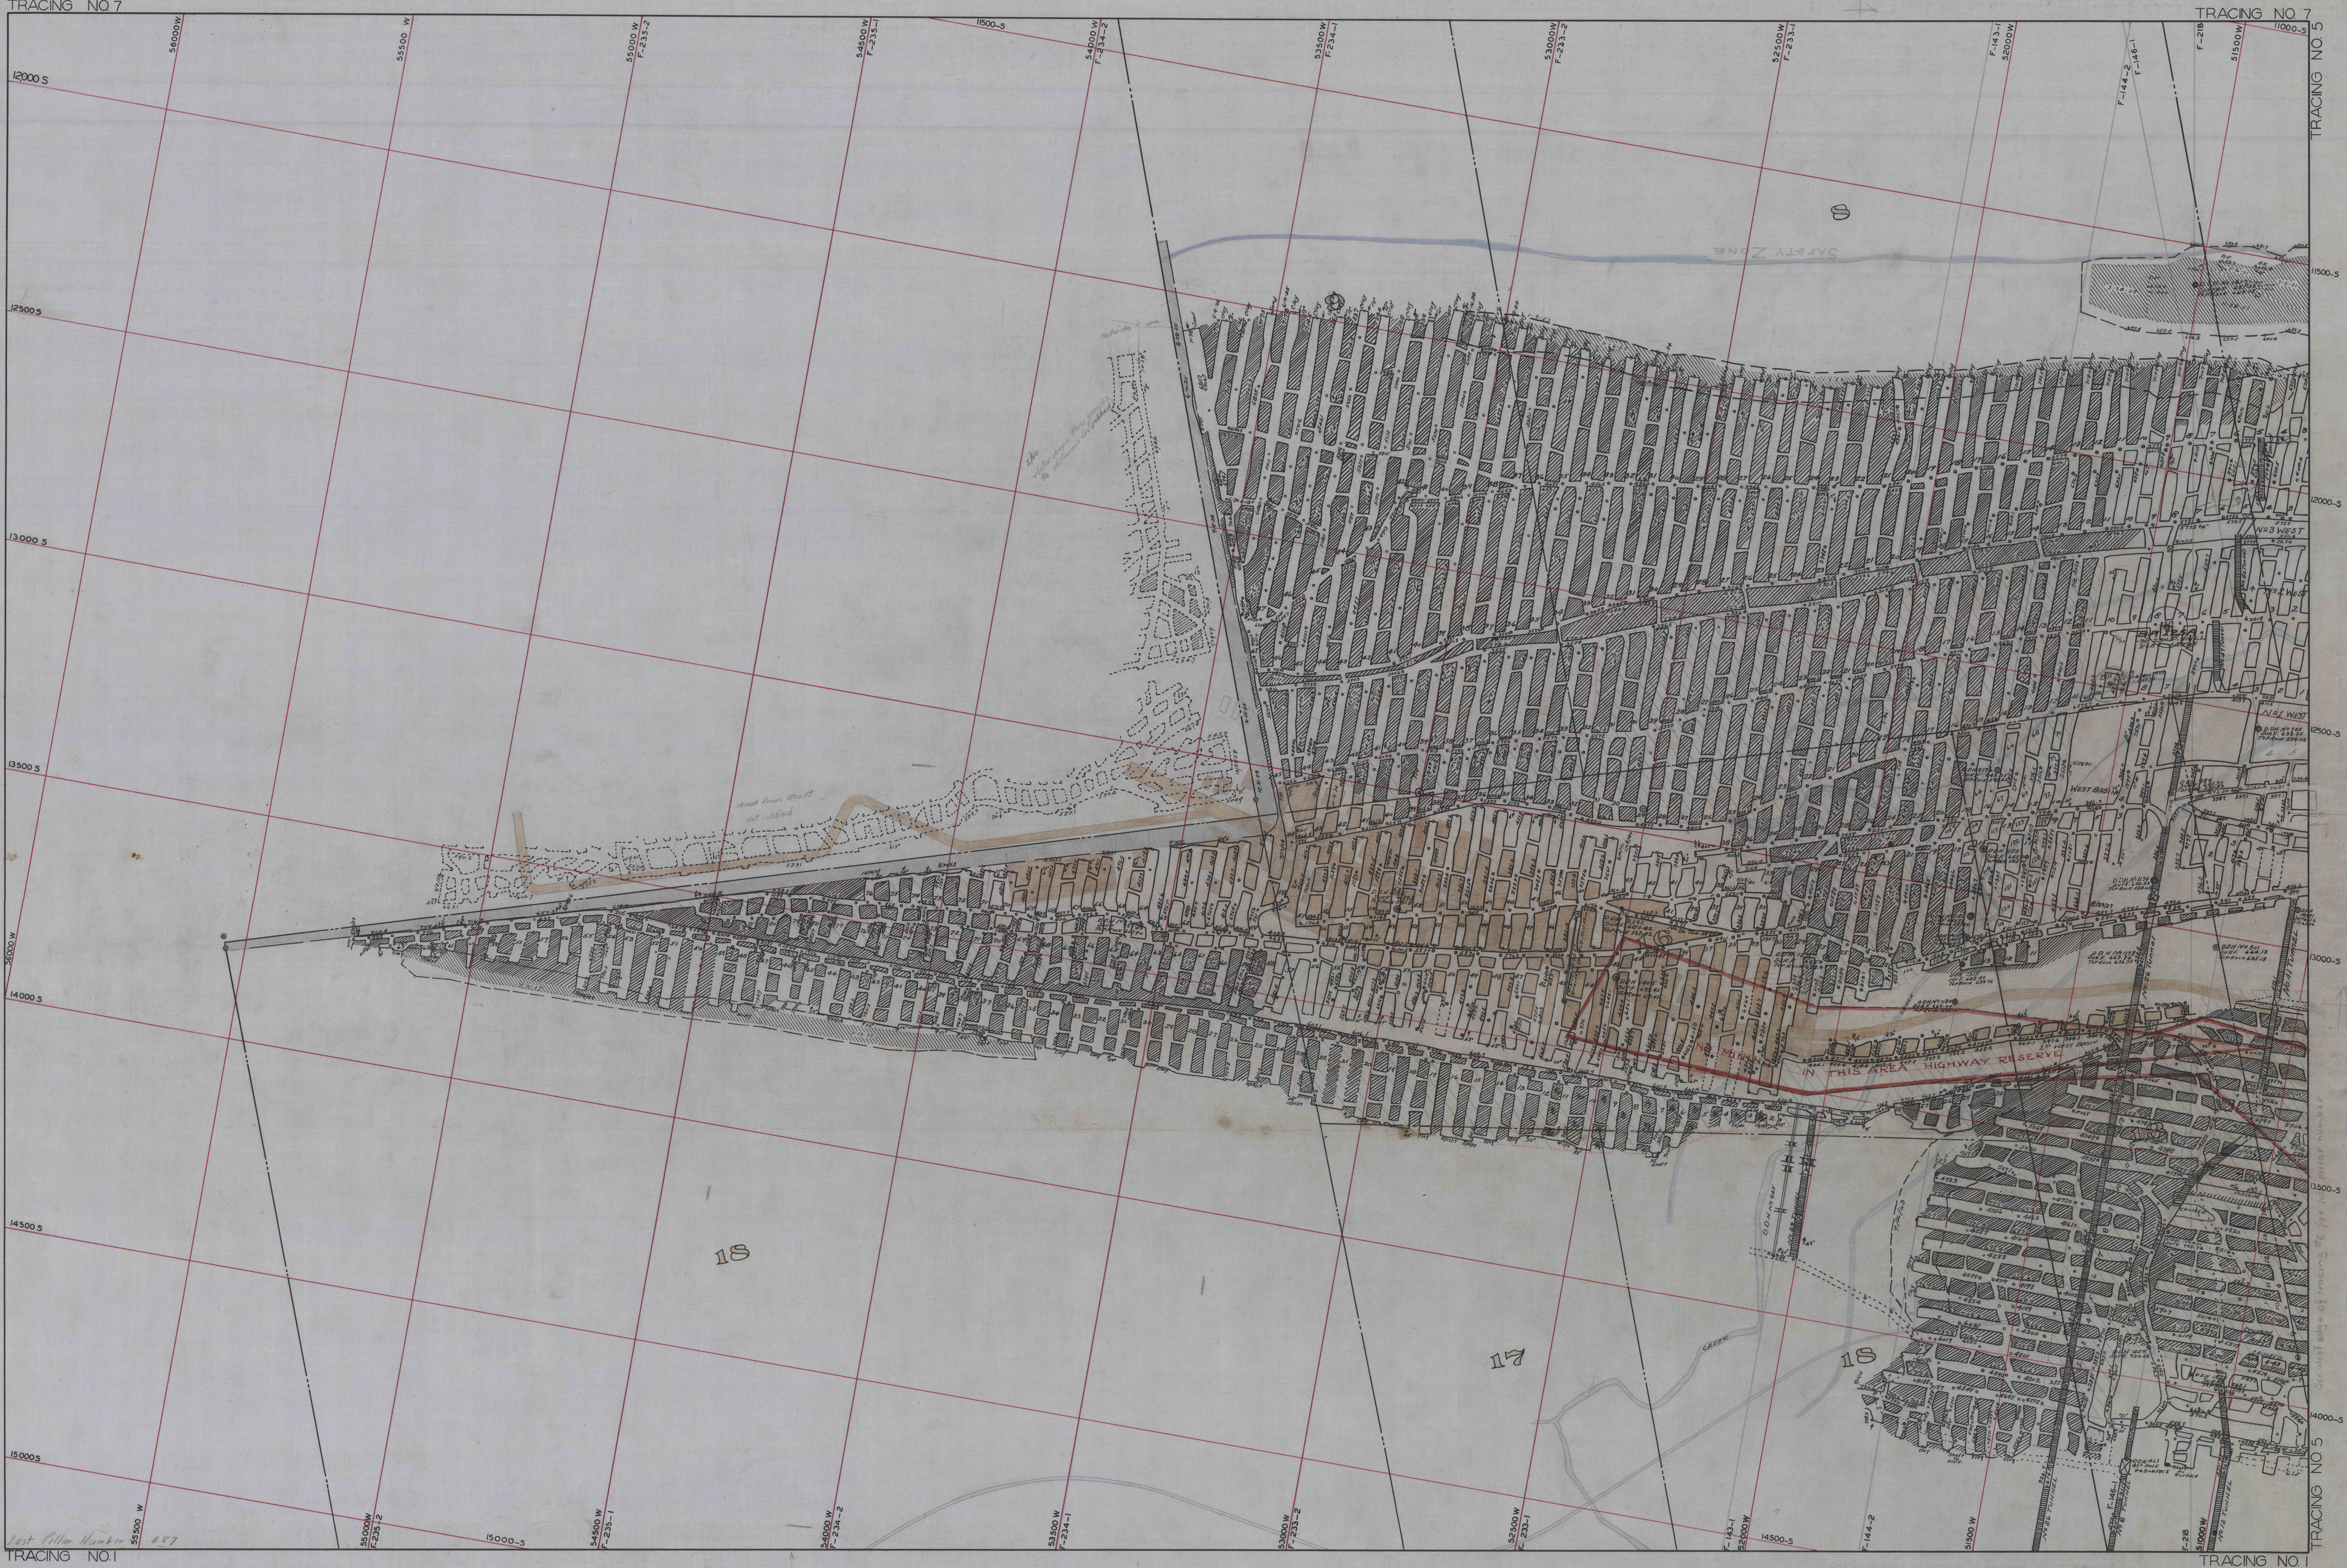

TRACING NO. 7

TRACING NO. 7

12000 S

11000-S

12500 S

11500-S

13000 S

12000-S

13500 S

12500-S

14000 S

13000-S

14500 S

13500-S

15000 S

14000-S

TRACING NO. 1



See west edge of tracing #6 for corner number

18

17


SAFETY ZONE

IN THIS AREA HIGHWAY RESERVE



















