
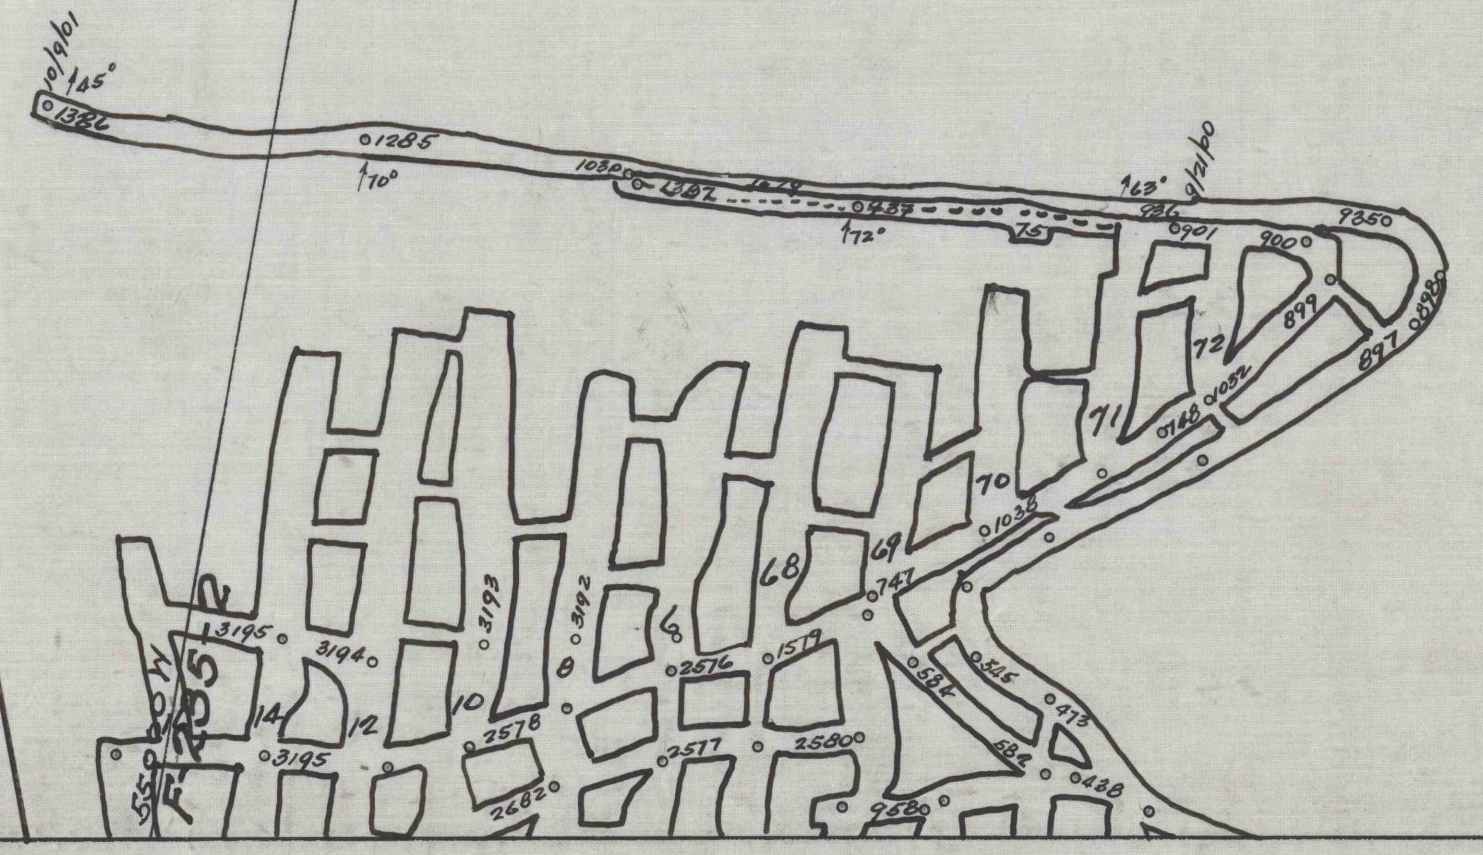


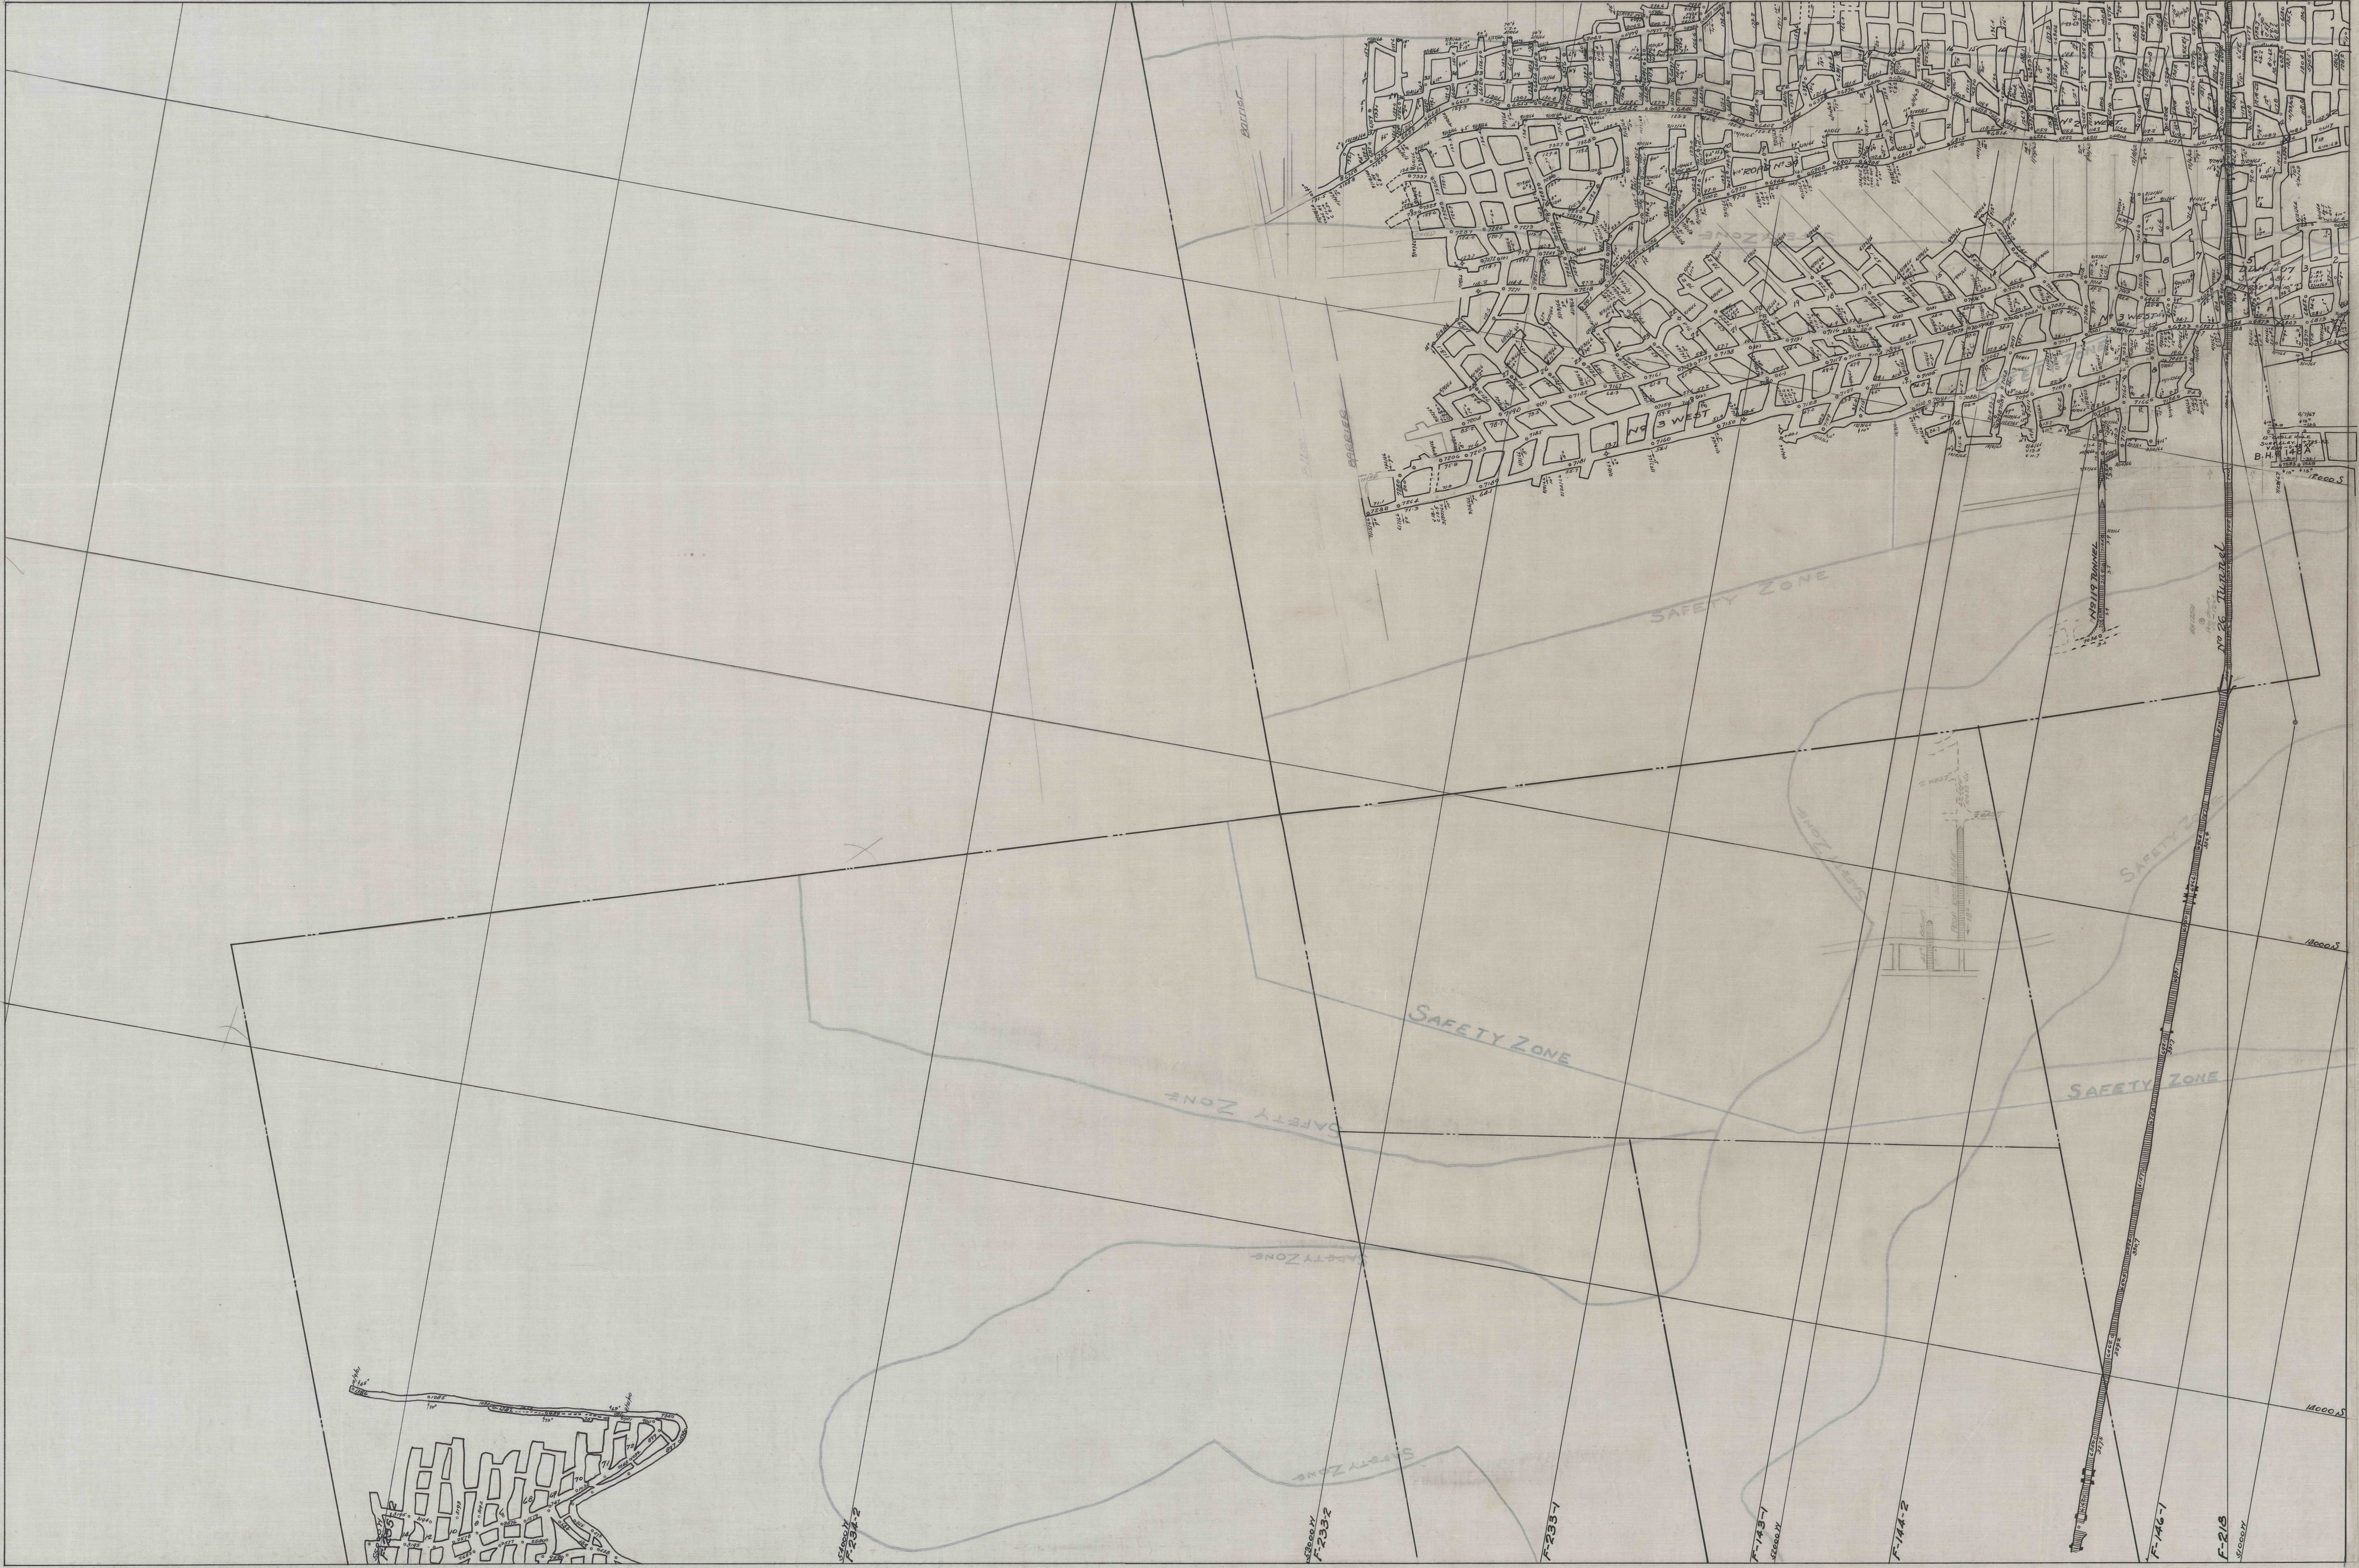

F-233-2

F-233-2

F-233-1

F-143-1

F-144-2

F-146-1

F-213