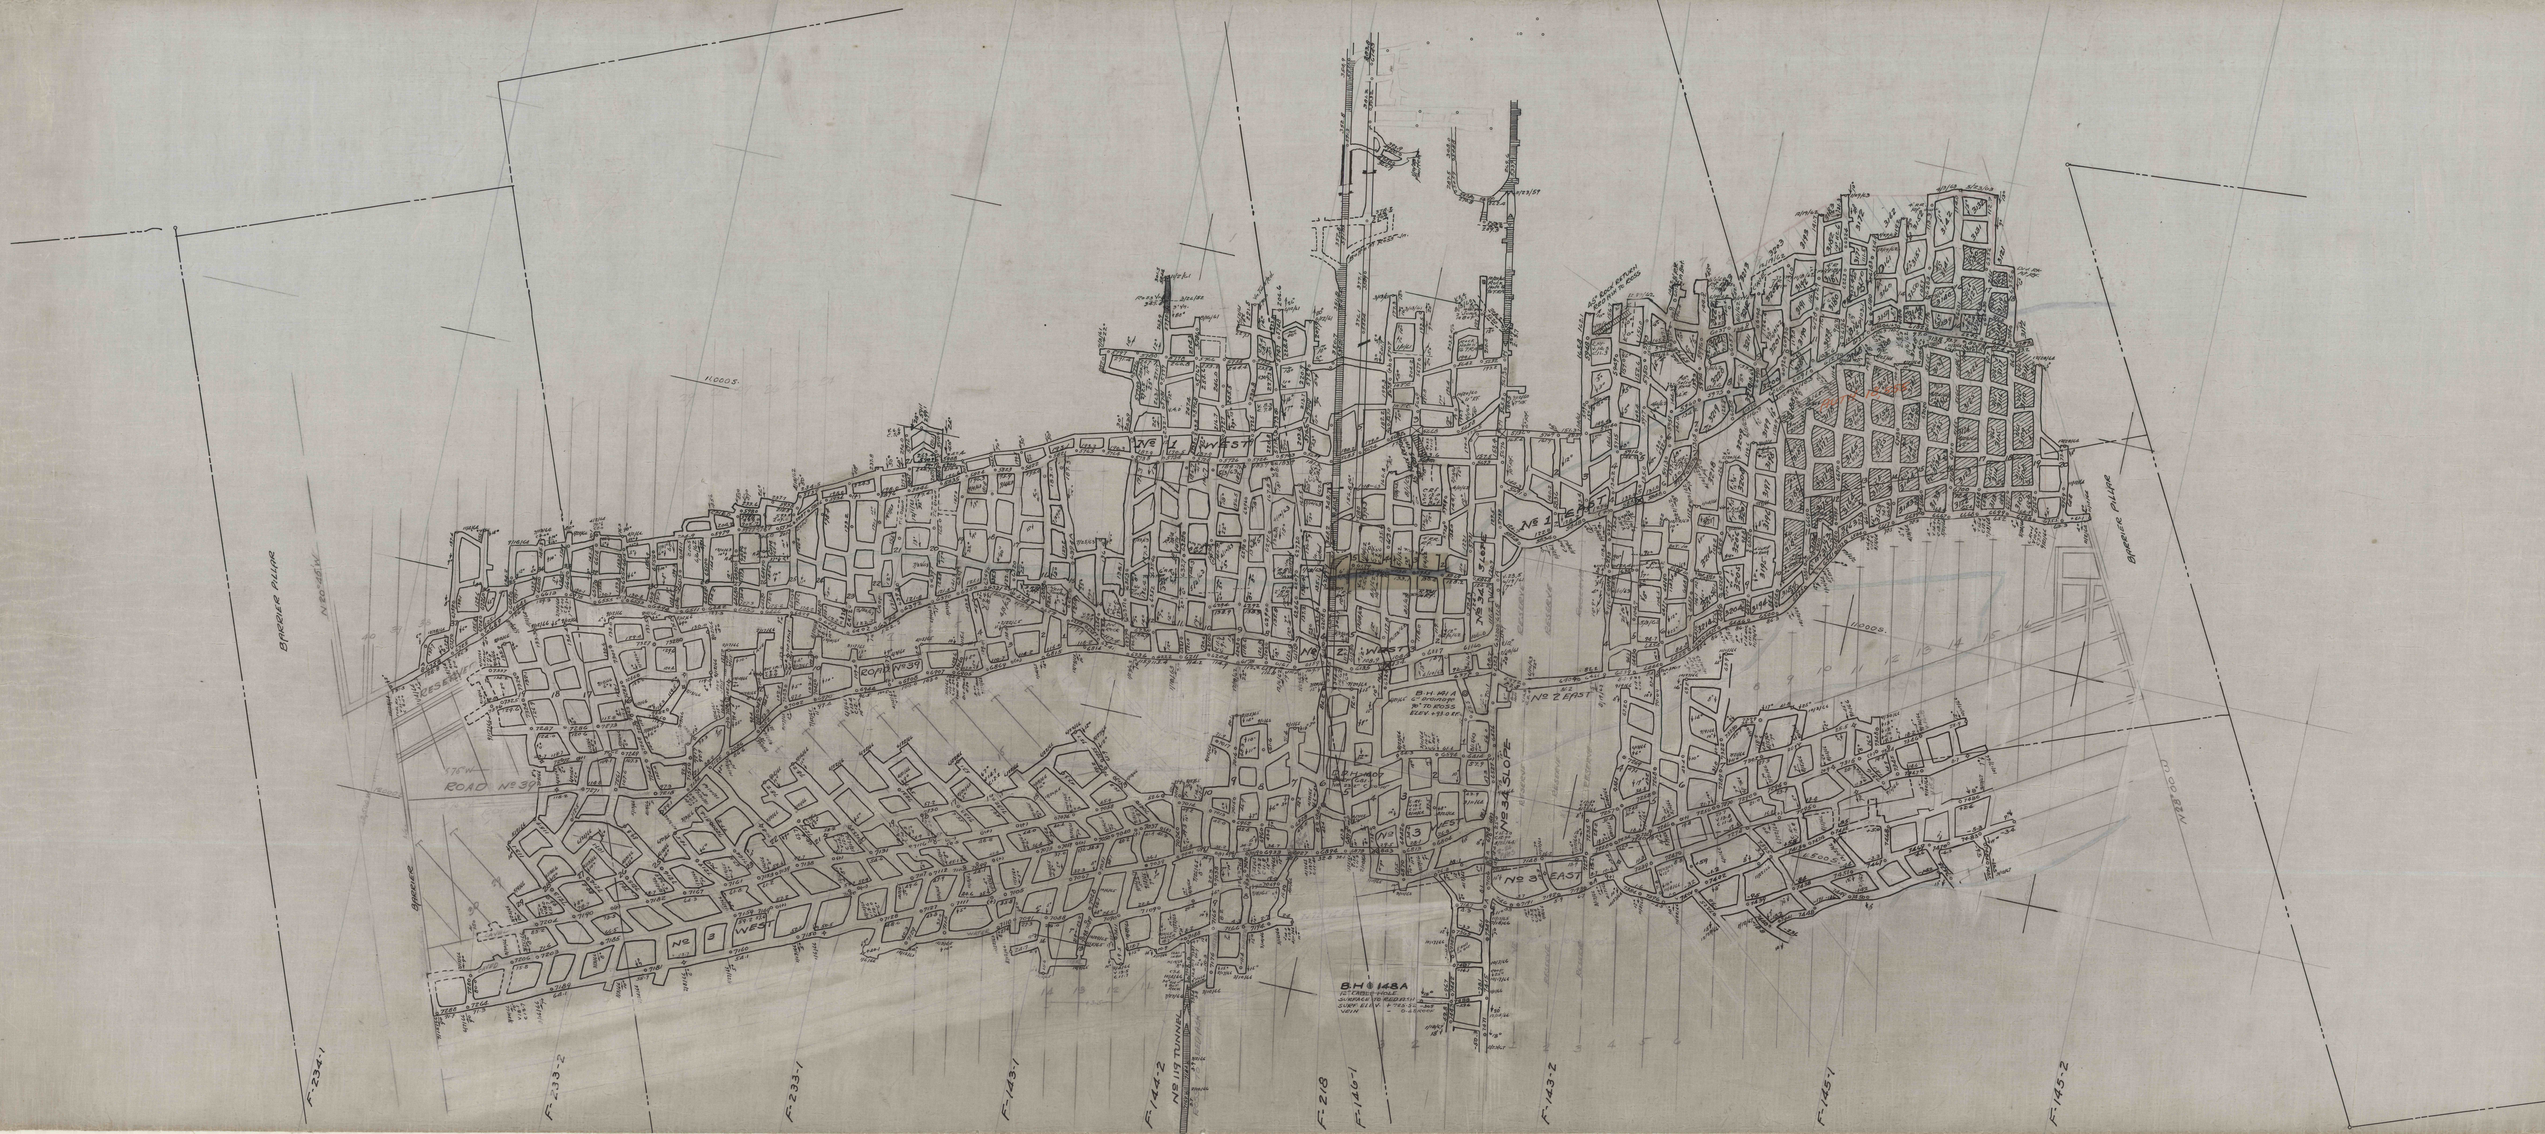

BARRIER PILLAR
N.20°45'W
11,000S.
No 1 WEST
No 1 EAST
No 2 WEST
No 2 EAST
No 3 WEST
No 3 EAST
No 34 SLOPE
ROAD No 39
S75°W
12,000S.
RESERVE
BARRIER
CAVED
CAVE
Ross Vn. 347.
Vn. Twisted
Bottom Ross Vn.
45° ROCK RETURN RED ASH TO ROSS
Rock Hole to T.R.A.
B.H. 141A
6" Drainage
90° TO ROSS
ELEV. + 93.0 R.F.
D.D.H.-1407
B.H. 148A
12" CABLE HOLE
SURFACE TO RED ASH
SURF. ELEV. + 725.52
VEIN - 0.48 ROOF
No 119 TUNNEL
ROSS TO RED ASH
11/23/59
11,500S.
N.28°00'W
ROTH 10,555
BARRIER PILLAR
F-234-1
F-233-2
F-233-1
F-143-1
F-144-2
F-218
F-146-1
F-143-2
F-145-1
F-145-2