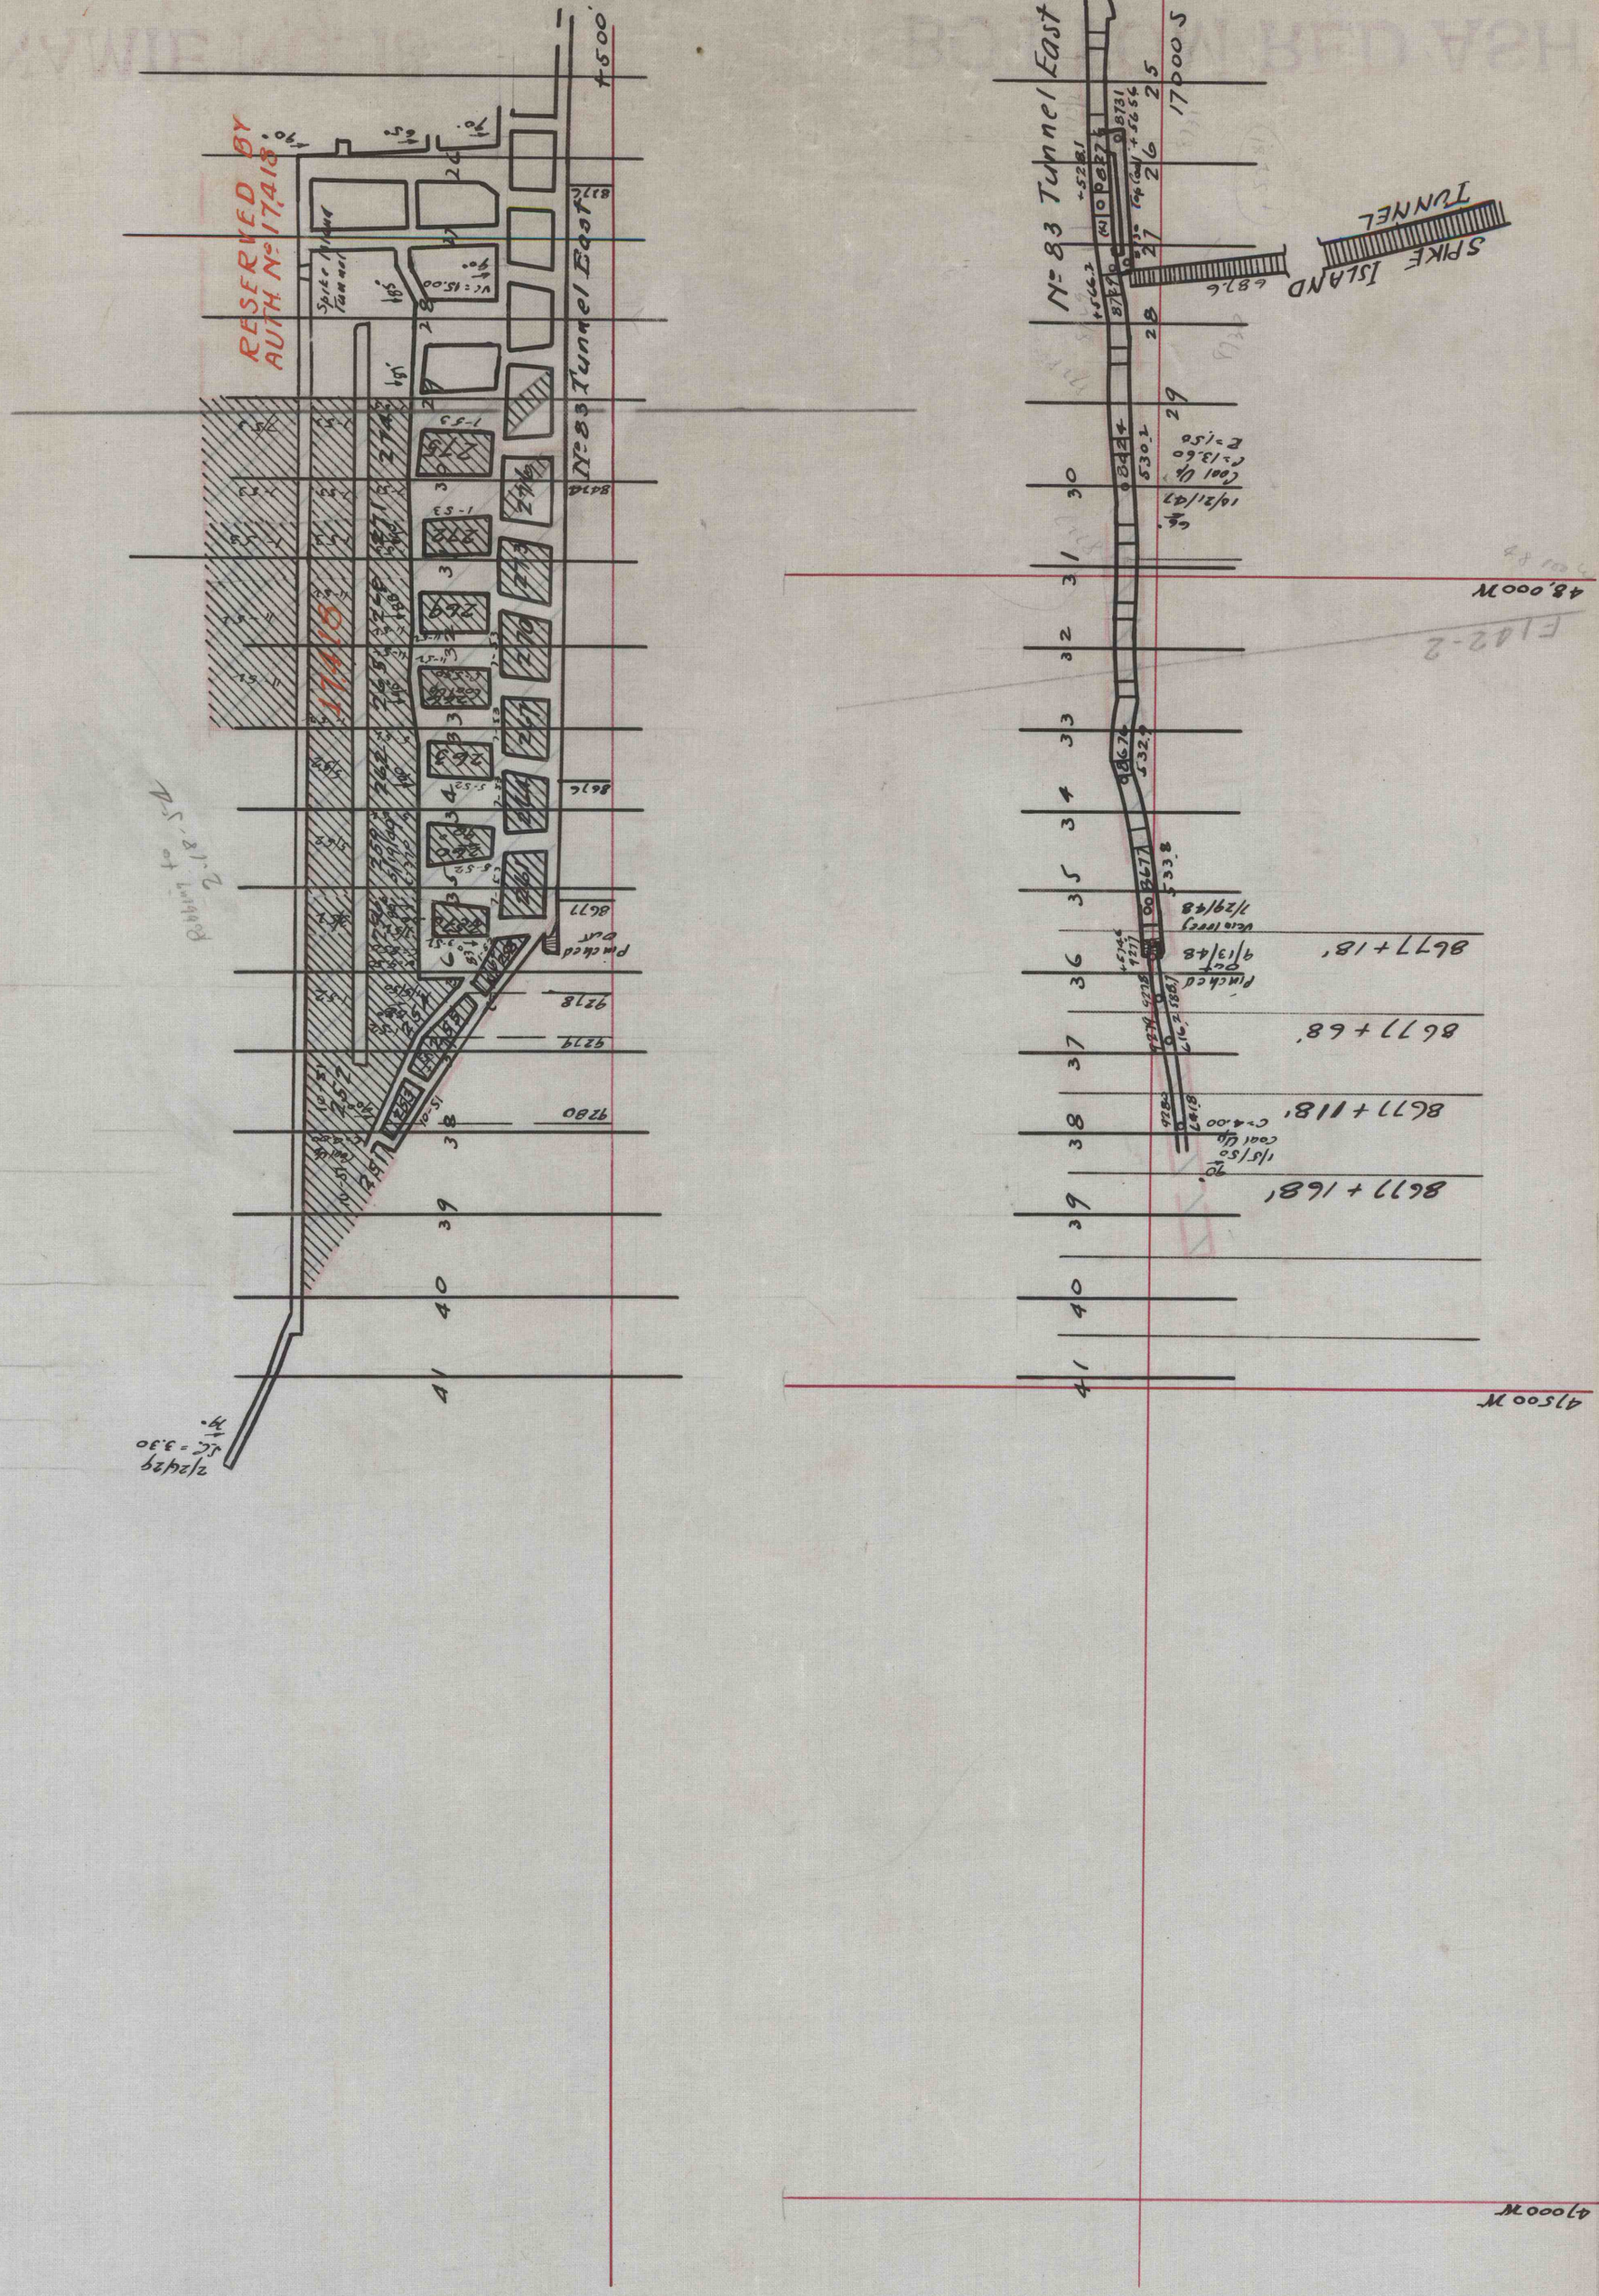
RESERVED BY AUTH. No 17418
17418
No 83 Tunnel East
Spike Island Tunnel
Punched out
8677 + 18'
8677 + 68'
8677 + 118'
8677 + 168'
48,000 W
47500 W
47000 W